


PROFILE		BY	DATE
SURVIVED		<i>D.R.</i>	<i>—</i>
PLOTTED		<i>H.H.</i>	<i>—</i>
GRADES CHECKED			
B. M. 3 NOTED			
STRUCTURE NOTATIONS CH'KD			
NO.	<i>483-15</i>		

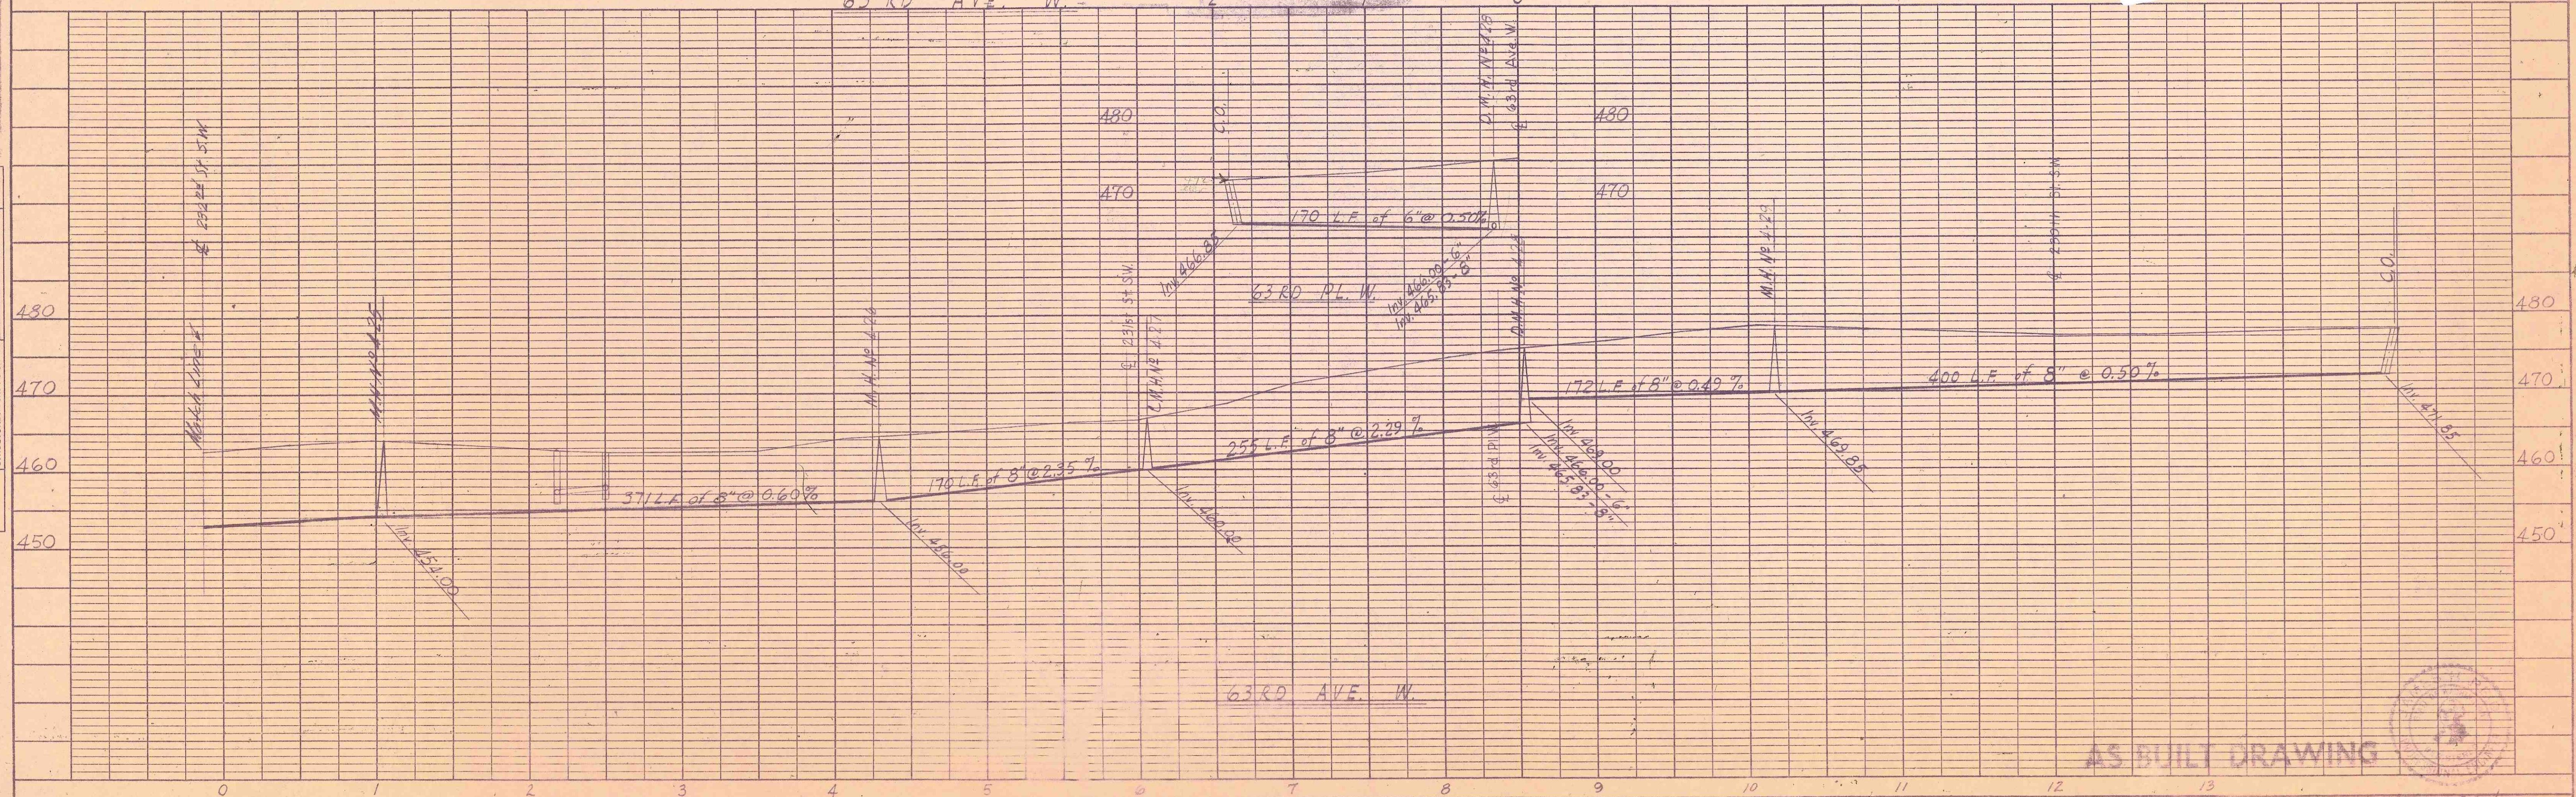

AS BUILT DRAWING

PLATE 1 - PLAN - PROFILE - F. A. S.  
CLEARPRINT PAPER CO., S. F. CAL.  
No. 100CH-1

**JAMES H. REID & ASSOCIATES**  
CONSULTING ENGINEERS, 324 MAIN ST., EDMONDS, WASH.

DESIGN LHN	DRAWN D.B. B.D.	CHECKED L.H.V.	DATE 3-30-59	H. SCALE 1"=50'	FILE NO. 5.50/4-3
				V. SCALE 1"=10'	SHEET 3 OF 4