



DETAIL - CLEANOUT  
no scale (8" SIDE SEWER)

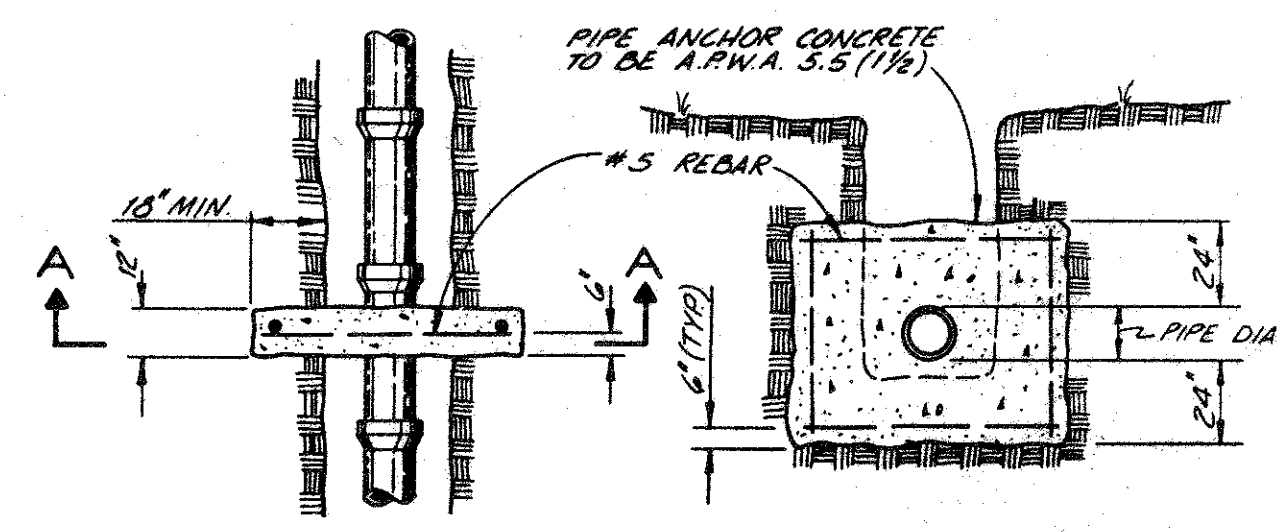

CONCRETE PIPE ANCHOR  
NO SCALE

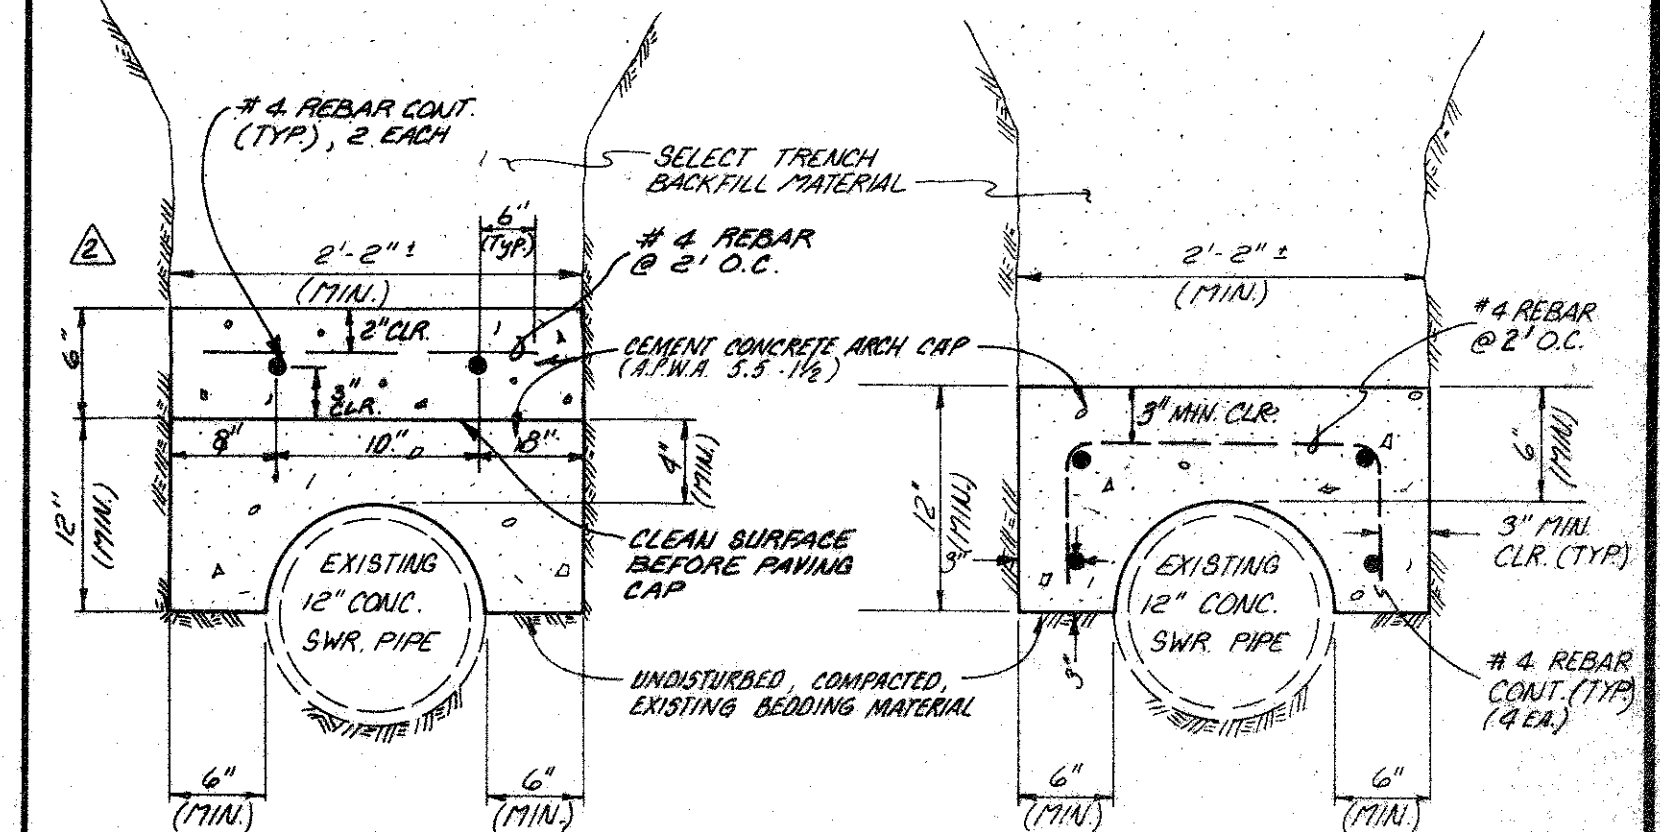

DETAIL ~ CEMENT CONC. ARCH CAP  
NO SCALE

DETAIL ~ REINFORCED CEMENT CONC. ARCH CAP  
NO SCALE

- NOTES: 1. CEMENT CONCRETE PROTECTION CAPS SHALL BE PLACED OVER THE EXISTING CONC. SEWER TRUNK WHENEVER BUT FILLING OCCURS OVER THE PIPE. REINFORCED CAPS SHALL BE PLACED OVER THE EXISTING CONC. SEWER TRUNK WHENEVER EXIST. PIPE COVER EXCEEDS 14 FEET IN DEPTH OR WHERE A ROADSIDE IS PLACED OVER THE PIPE.
2. REINFORCING STEEL SHALL BE MIN. 40 GRADE.
3. SEE PLANS FOR LOCATIONS.

REV	DATE	DESCRIPTION	BY
1	8-20-85	Field Change Revision - Revised Bldgs. Q & M, S.C.B.	
2	9-25-85	Revised San. Sew. & Storm. Plans	
3	9-25-85	GENERAL REVISIONS PER CITY OF BELLEVUE RECORD REVIEW	



**LINCOLN PROPERTY CO.**  
1745 114TH AVE. S.E., SUITE 100  
BELLEVUE, WASHINGTON 98004  
**CREEKSIDE VILLAGE APARTMENTS**

**SANITARY SEWER PLAN**  
(206) 454-3743 OR 885-7877

**DODDS ENGINEERS, INC.**  
4205-148th AVENUE NORTHEAST  
BELLEVUE, WASHINGTON 98007

DWN L.G. WIGHT	BOOK	PROJ. NO.
SVD	DATE	84121
APP'D STEVEN L. BORNEMAN, P.E.	DATE	SHT 17 OF 20

(SOUTH PORTION)

NOTE: SEE SHEET 18 OF 20 FOR PROFILES.  
**AS CONSTRUCTED**  
SEWERAGE UNIT 9-2A DATE: 12-17-86 LTB