

APPLI CATION

The City of Mountlake Terrace

SIDE SEWER PERMIT

OUTSIDE ☐ INSIDE ☐ REPAIRS ☐


CARD No. _____

EASEMENT No. _____

OWNER Parkwood Homes Inc. CONTRACTOR Tymrowood Septic tank co. PERMIT No. _____

HOUSE No. 4507 - 2195W STREET _____ AVENUE LOT No. Lot 6 BLOCK No. _____

NAME ADD. Parkwood Homes

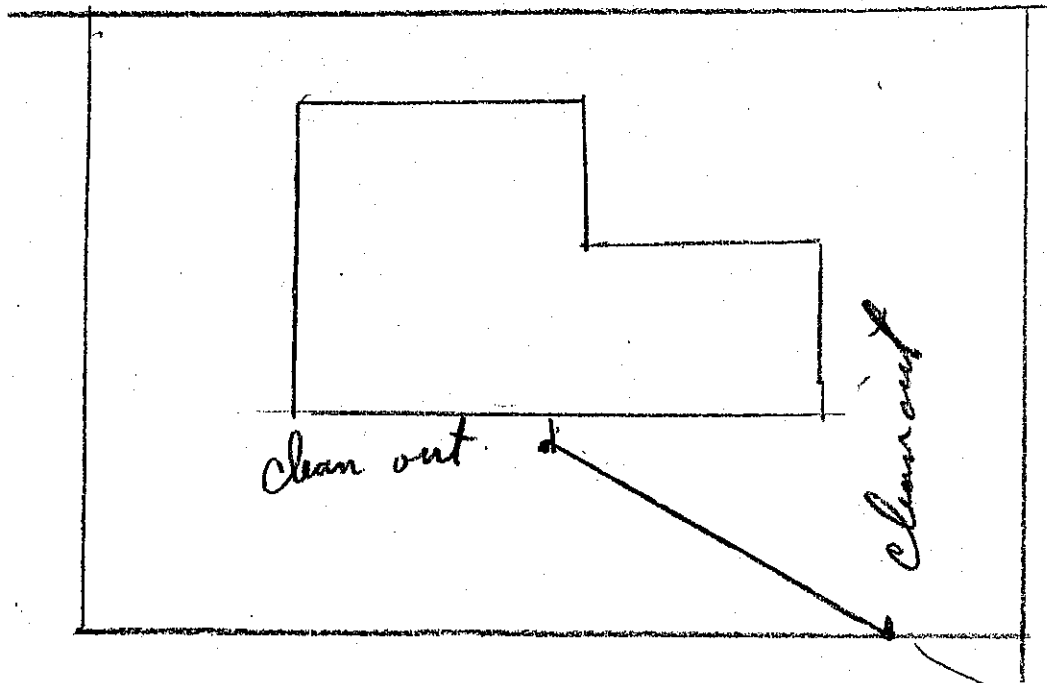

BACKFILL WORK ORDER ISSUED _____ DEPOSIT, \$ 10.00

SEWER WORK ORDER ISSUED _____

Approved: _____

DATE 5-3-66 BY _____

0 40 in street
5-3-66