

# APPLICATION

for

## SIDE SEWER PERMIT

OUTSIDE ☒ INSIDE ☐ REPAIRS ☐

CARD No. \_\_\_\_\_

EASEMENT No. NONE

The City of Mountlake Terrace

OWNER ROBERT J. JAKLEWICZ

CONTRACTOR RUSS JOHNSON


PERMIT No. U-26-82

HOUSE No. 24016 54<sup>TH</sup> W.

STREET  
AVENUE LOT No. \_\_\_\_\_

BLOCK No. \_\_\_\_\_

NAME ADD

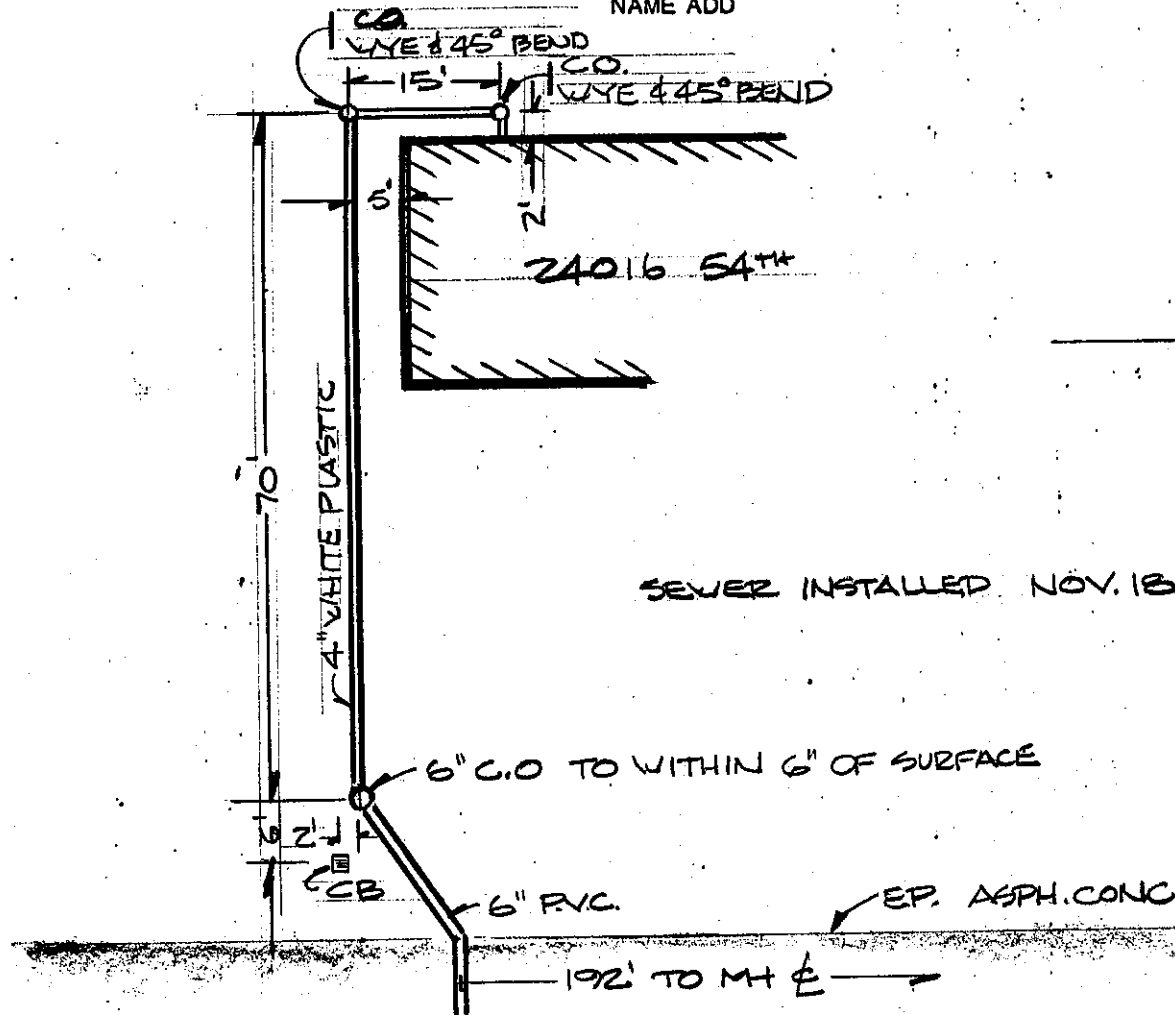

SEWER INSTALLED NOV. 18, 1982

54<sup>TH</sup> AVE. WEST

ASBUILT INFO BY JOHN LYEN  
FOR STAN QUAKE, INSPECTOR  
DRAWN BY WILL VAN RY  
FOR STAN QUAKE

Approved: \_\_\_\_\_

BACKFILL WORK ORDER ISSUED \_\_\_\_\_

DEPOSIT, \$ \_\_\_\_\_