

The City of Montlake Terrace

for  
**SIDE SEWER PERMIT**  
OUTSIDE ☒ INSIDE ☐ REPAIRS ☐


CARD No. \_\_\_\_\_

EASEMENT No. \_\_\_\_\_

OWNER \_\_\_\_\_ CONTRACTOR Lin Homes Lynnwood Septic Tank PERMIT No. U 21 77

HOUSE No. 4512 225th Pl Sw STREET 6 Hidden Highlands No 2 AVENUE LOT No. \_\_\_\_\_ BLOCK No. \_\_\_\_\_

NAME ADD \_\_\_\_\_

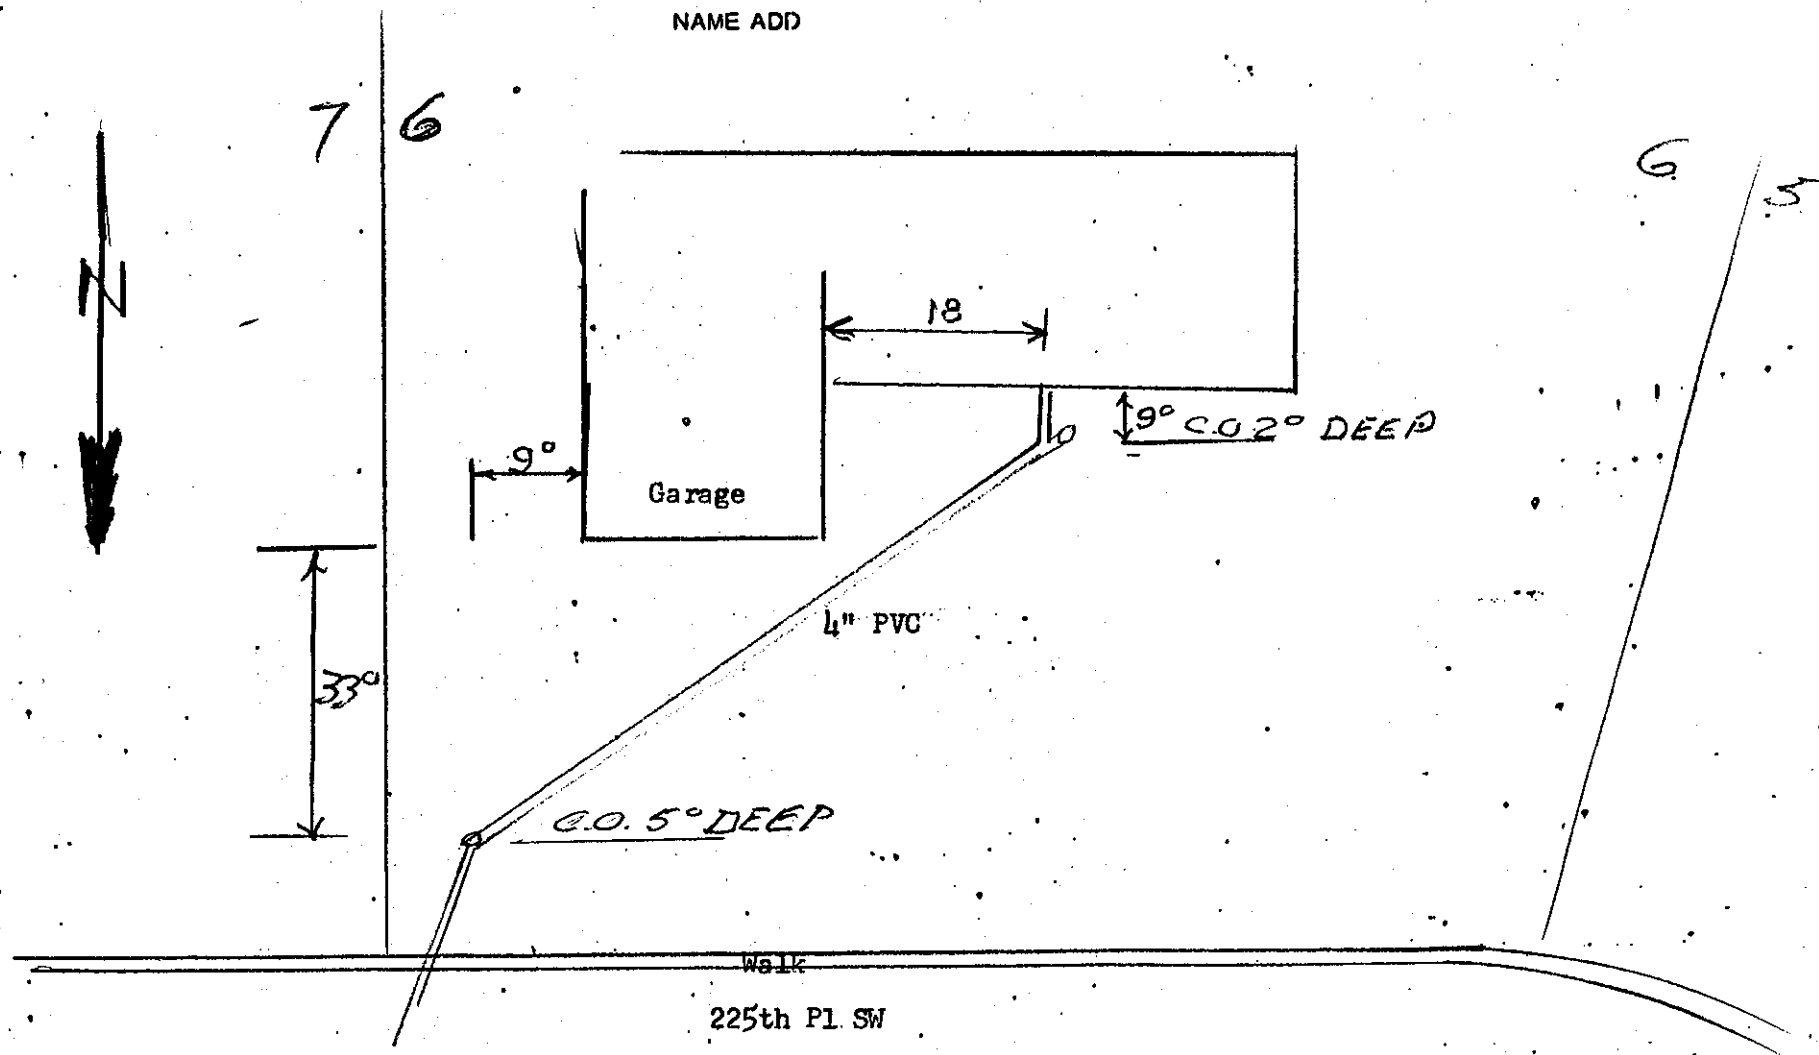

BACKFILL WORK ORDER ISSUED 3 22 77 Date 3 18 77 DEPOSIT, \$ 20  
SEWER WORK ORDER ISSUED \_\_\_\_\_

Approved: \_\_\_\_\_

DATE 3 22 77

BY [Signature]