

APPLICATION

for

CARD No. _____

SIDE SEWER PERMIT

The City of Mountlake Terrace

OUTSIDE ☐ INSIDE ☐ REPAIRS ☐


EASEMENT No. _____

OWNER Jim Hallerstedt CONTRACTOR North End Septic Tank PERMIT No. _____

HOUSE No. 22308 - 39 Ave W. STREET _____ AVENUE LOT No. Lot 1 BLOCK No. A

NAME ADD. Cedar Grove # 2

7-16-68

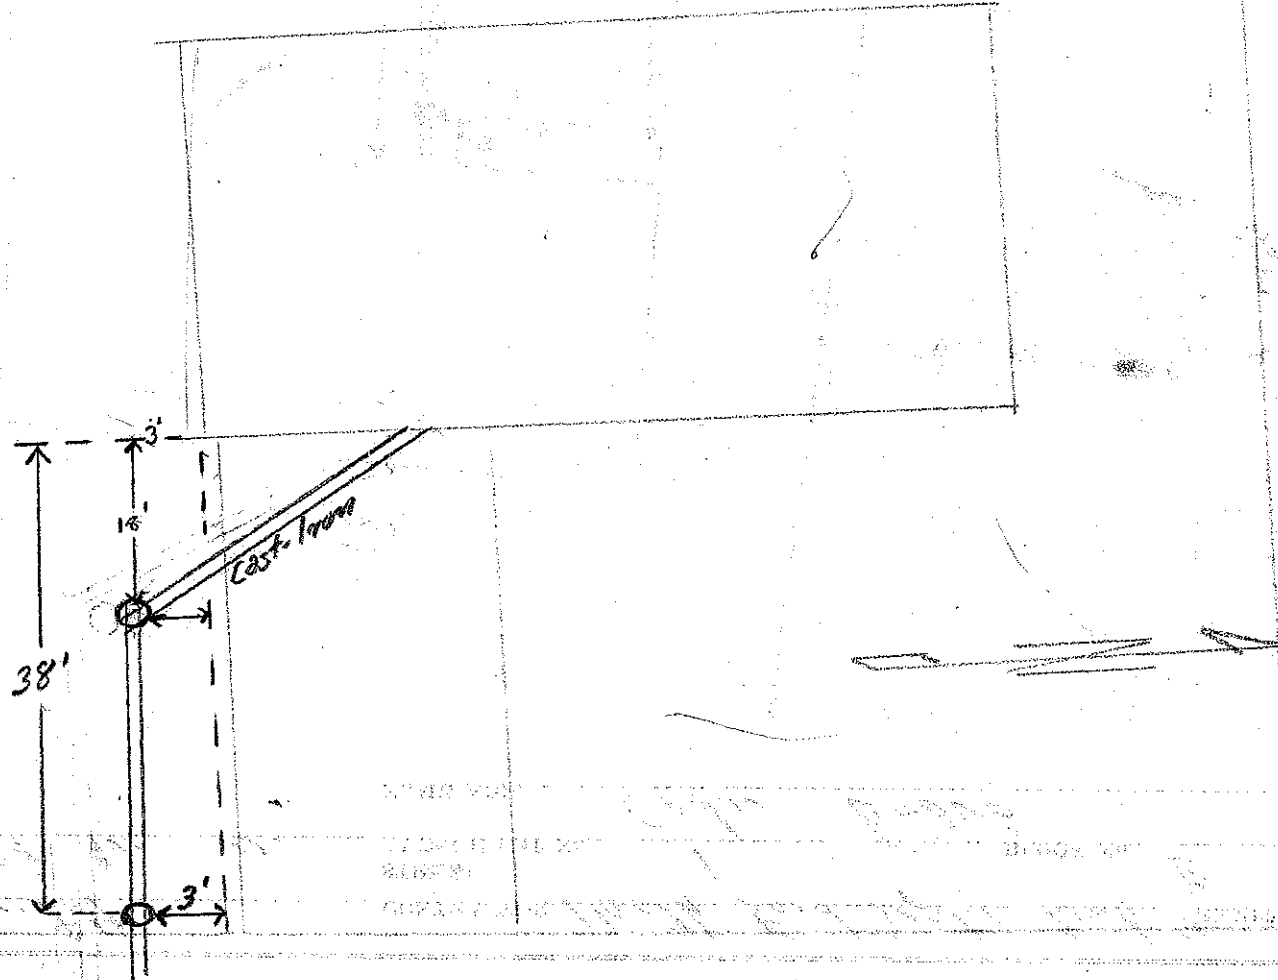

Date

Approved:

BACKFILL WORK ORDER ISSUED _____

DEPOSIT, \$ _____

SEWER WORK ORDER ISSUED _____

DATE _____ BY _____

APPLICATION