


PLAN
 DATE
 BY
 CHECKED
 NOTE BOOK ALIGNMENT CHECKED
 NO. RT. OF WAY CHECKED



48TH AVE. W.

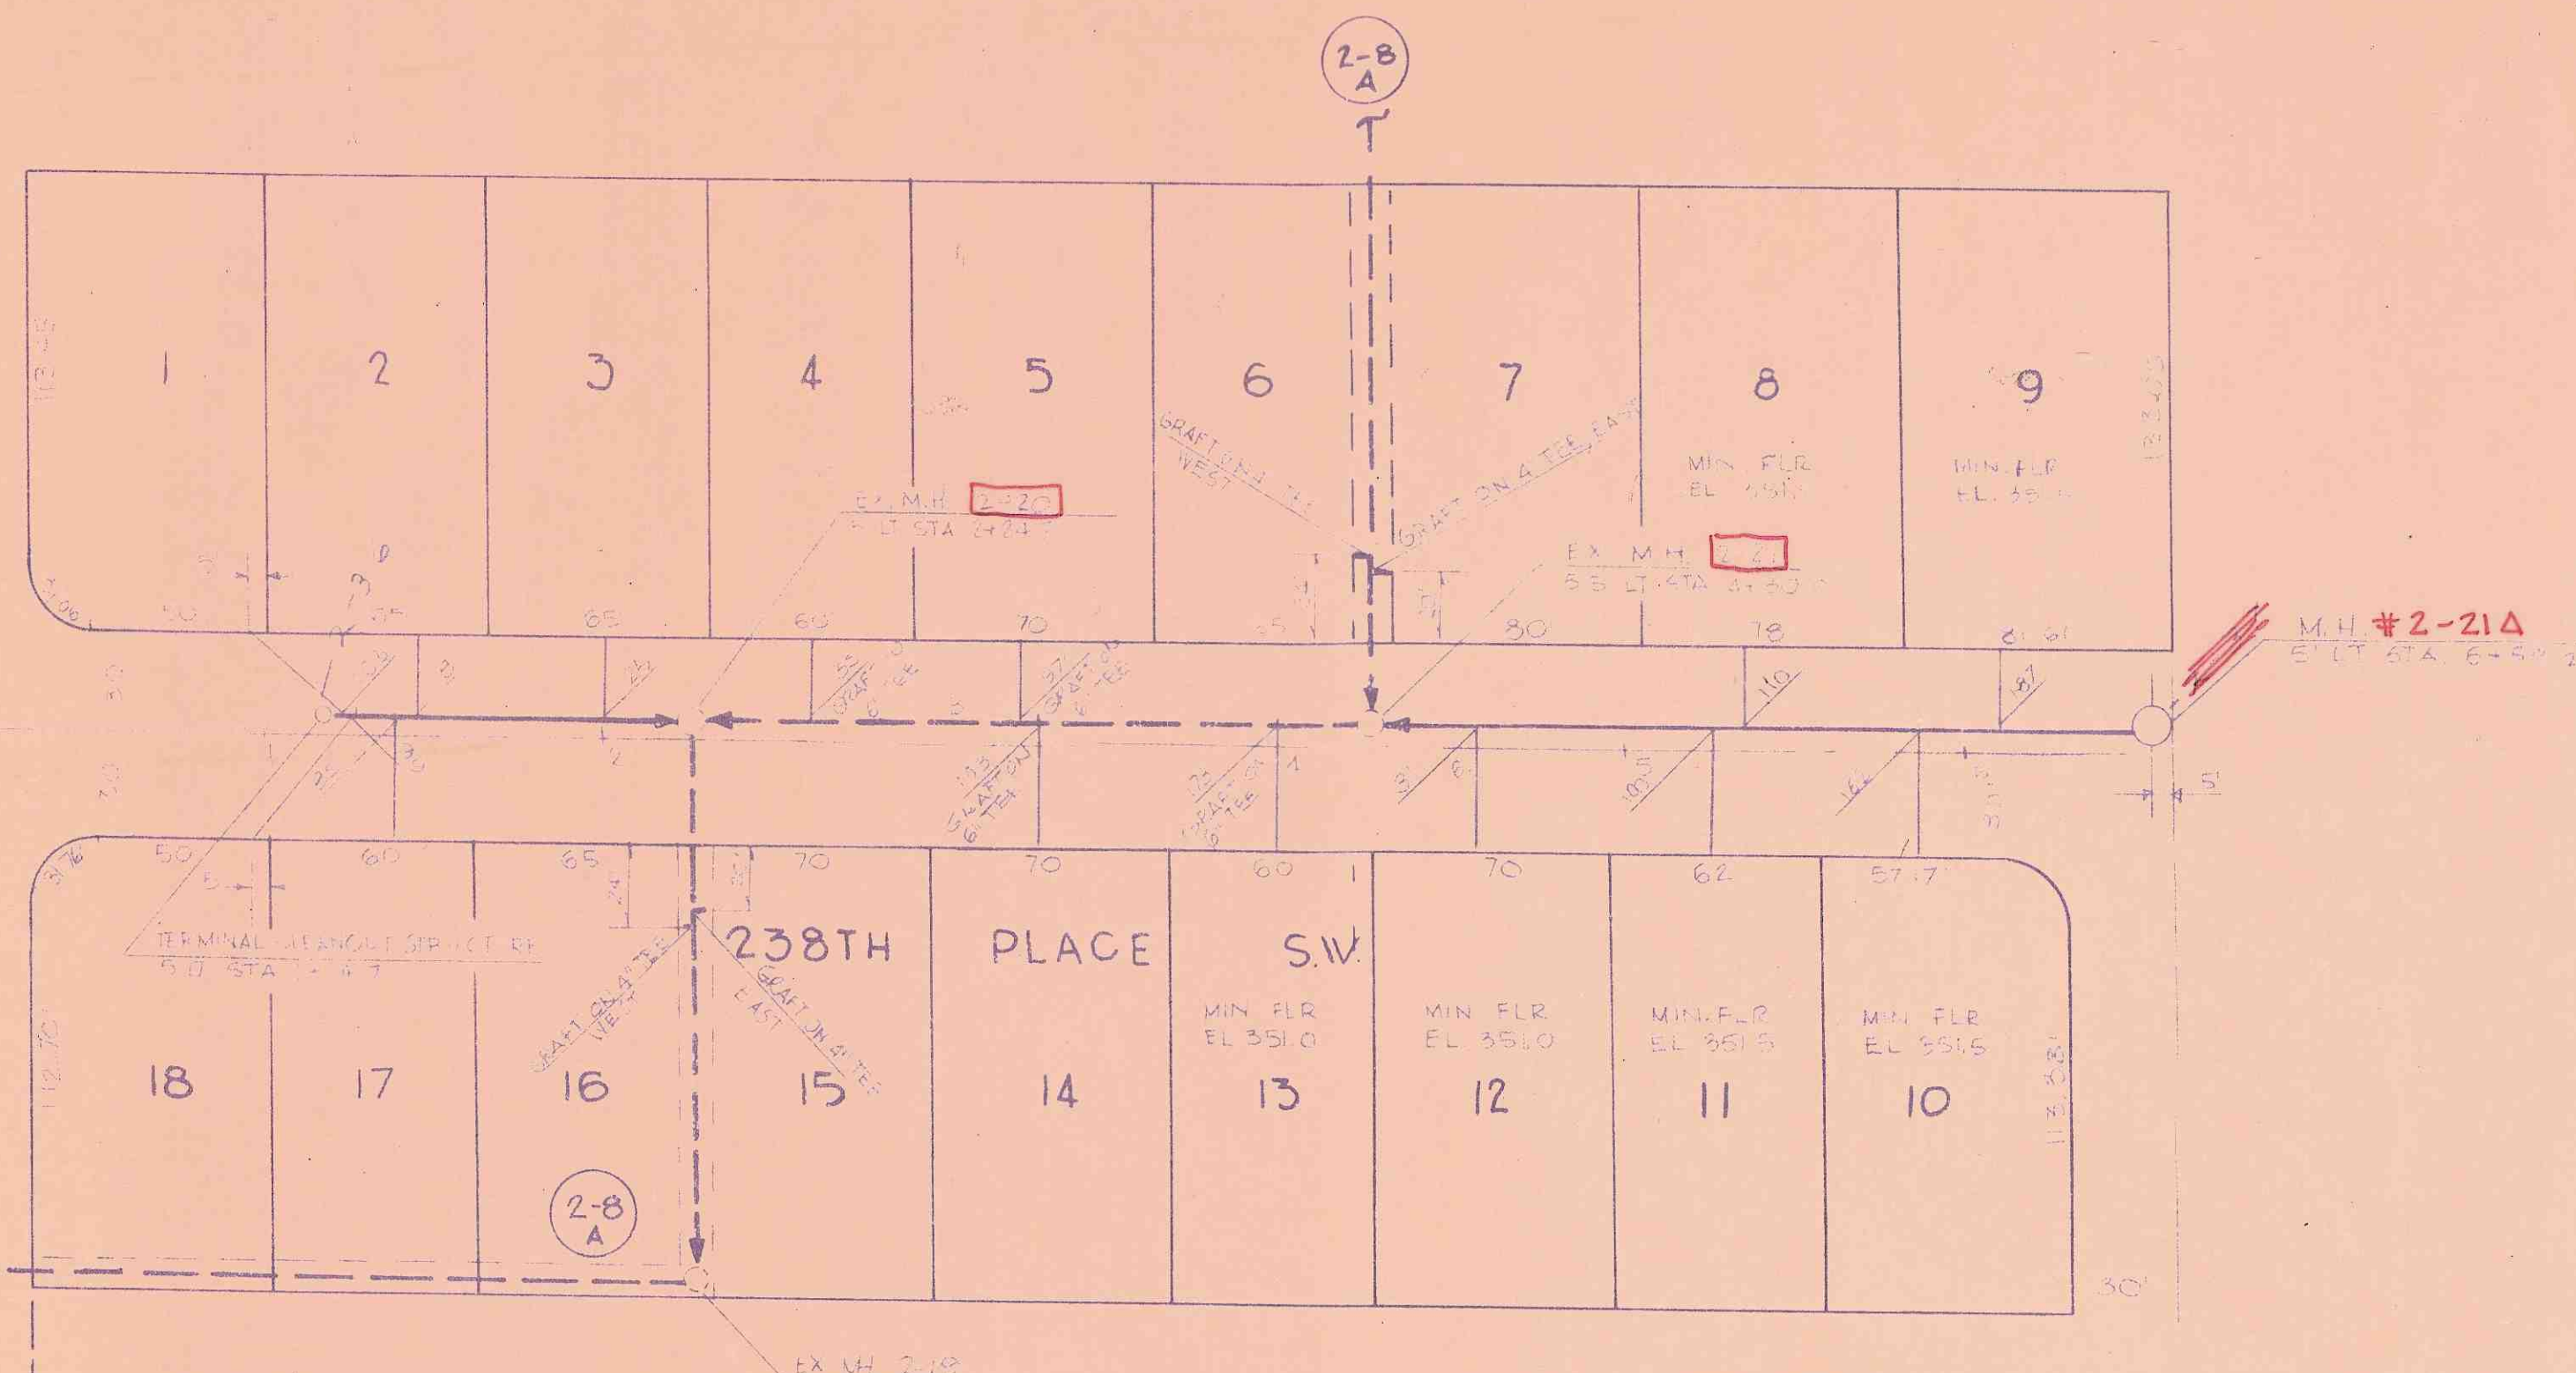

NOTES:

1. SINGLE SIDE SEWERS TO BE 8" DIAMETER TO PROPERTY LINE
2. MINIMUM SLOPE ON SIDE SEWERS IS 2 PER CENT
3. ALL MATERIALS & CONSTRUCTION TO BE IN ACCORDANCE WITH CITY OF MOUNTLAKE TERRACE REQUIREMENTS.

Copy of original by Denise Garcia



APPROVED

MOUNTLAKE TERRACE CITY ENGINEER

Scan Name: scans06278.pdf
 Scan Date:

NO.	REVISION	DATE	BY
RUSKIN FISHER & ASSOCIATES			
CIVIL ENGINEERS		LAND SURVEYORS	
SEATTLE, WASH.			
SHERIDAN ADDITION			
238TH PL. S.W.			
MOUNTLAKE TERRACE -		WASH.	
SANITARY SEWERS.			
DRAWN BY LE - 10/15/62		SCALE V=1"=5' H=1"=50'	
CHECKED BY RYER		DATE 10-16-62	
APPROVED BY		DATE	
JOB NO. 62649		SHEET 1 OF 1	

PROFILE
 DATE
 BY
 CHECKED
 NOTE BOOK GRADES CHECKED
 NO. STRUCTURE NOTATIONS CHECKED

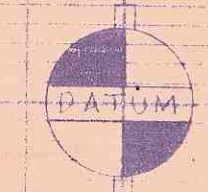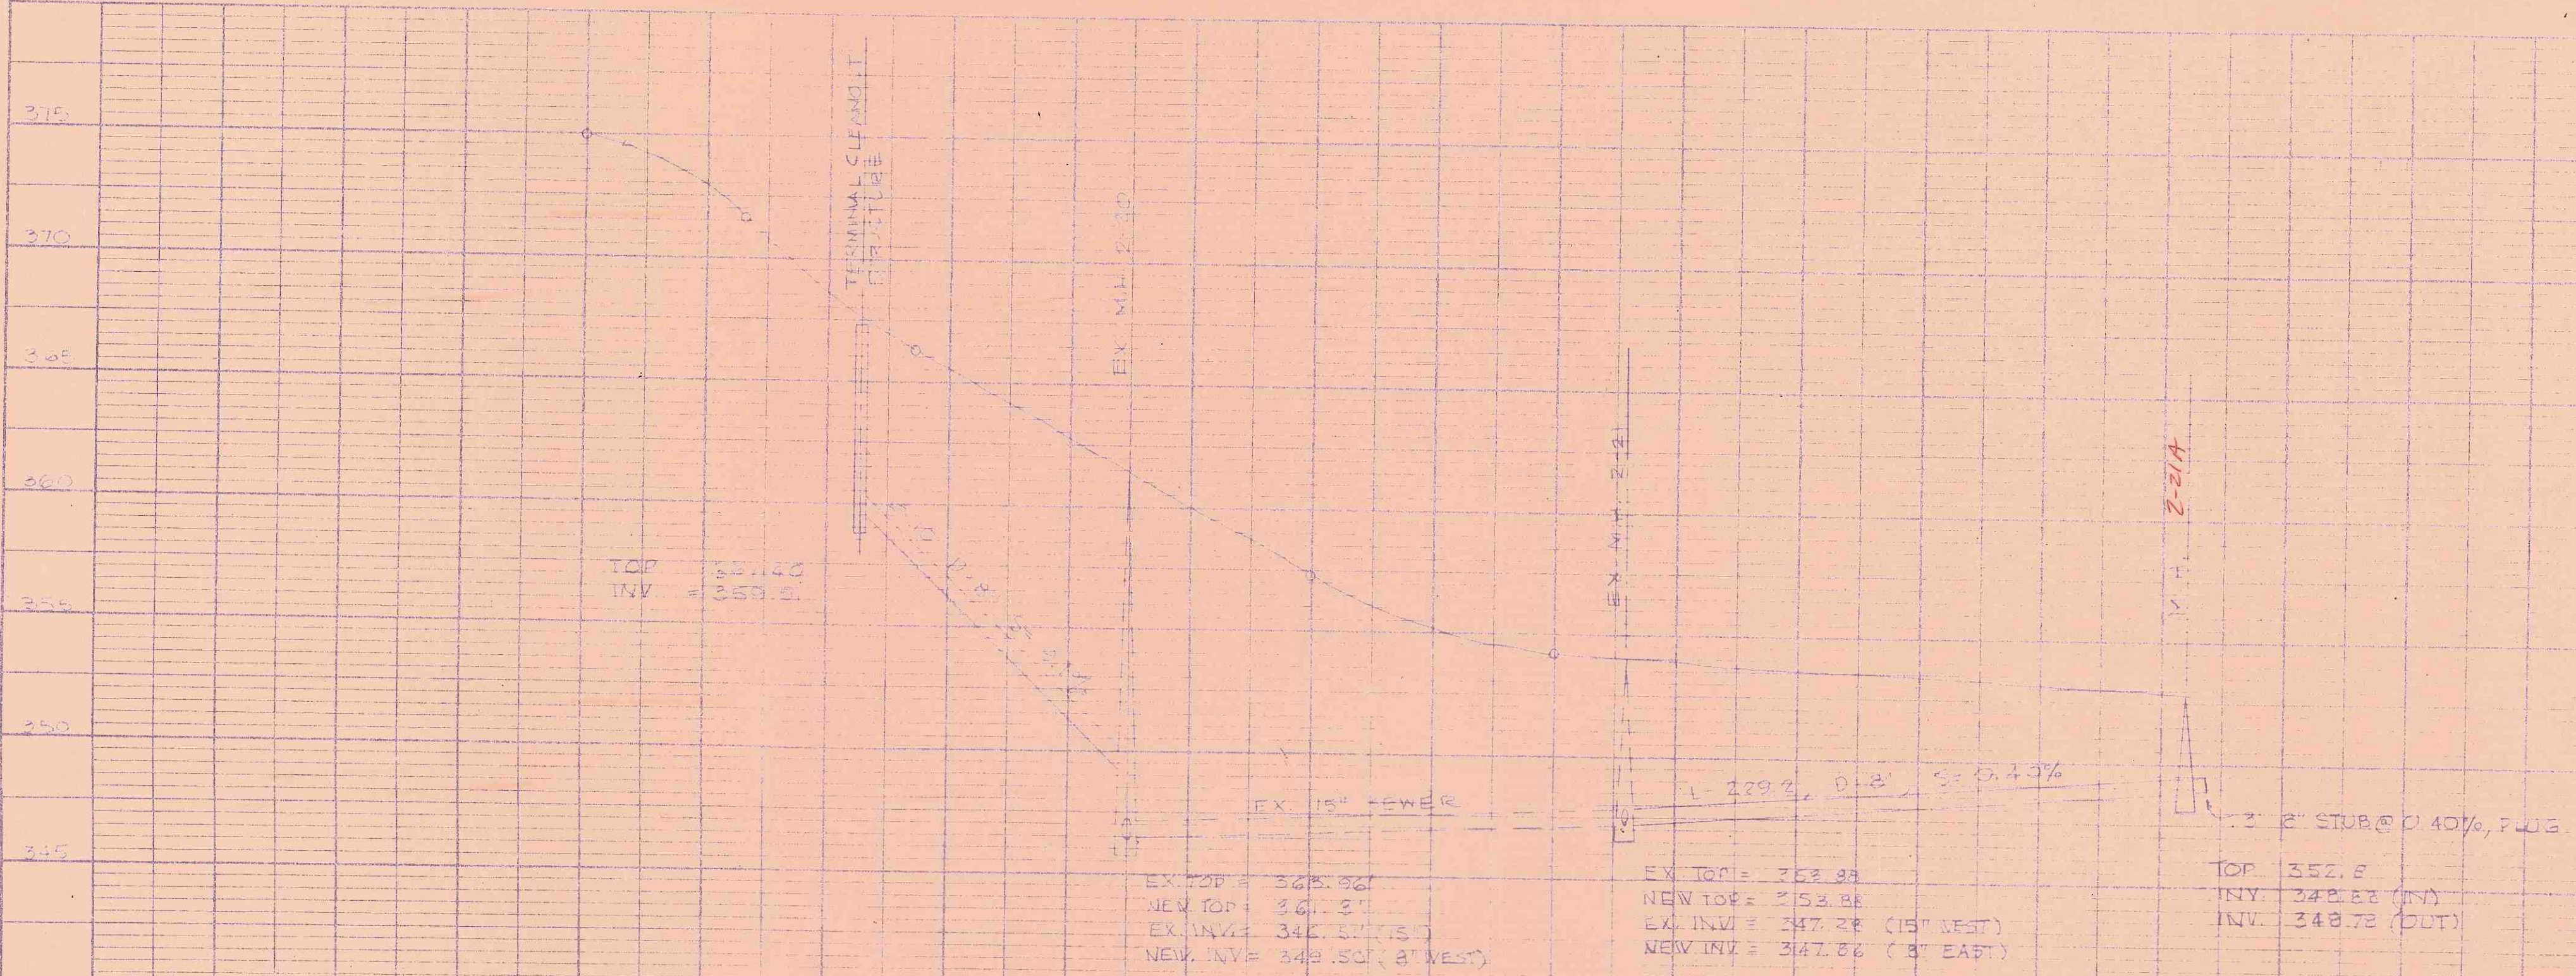

DATUM: 24" ELEV 352.88 10" FIRE HYDRANT
 LOCATED @ N.W. COR. INTER 238TH
 AND 48TH AVE. W.

Sewerage unit 2-8-A