

The City of Mountlake Terrace

APPLICATION

SIDE SEWER PERMIT

OUTSIDE ☒ INSIDE ☐ REPAIRS ☐

EASEMENT No.

OWNER *Arthur M. Nicklen*

CONTRACTOR *owner*


PERMIT No. *33*

HOUSE No. *23903-WS6th Ave*

STREET
AVENUE LOT No. *7*

BLOCK No. *1*

NAME ADD. *Replot of Lind Tracts*

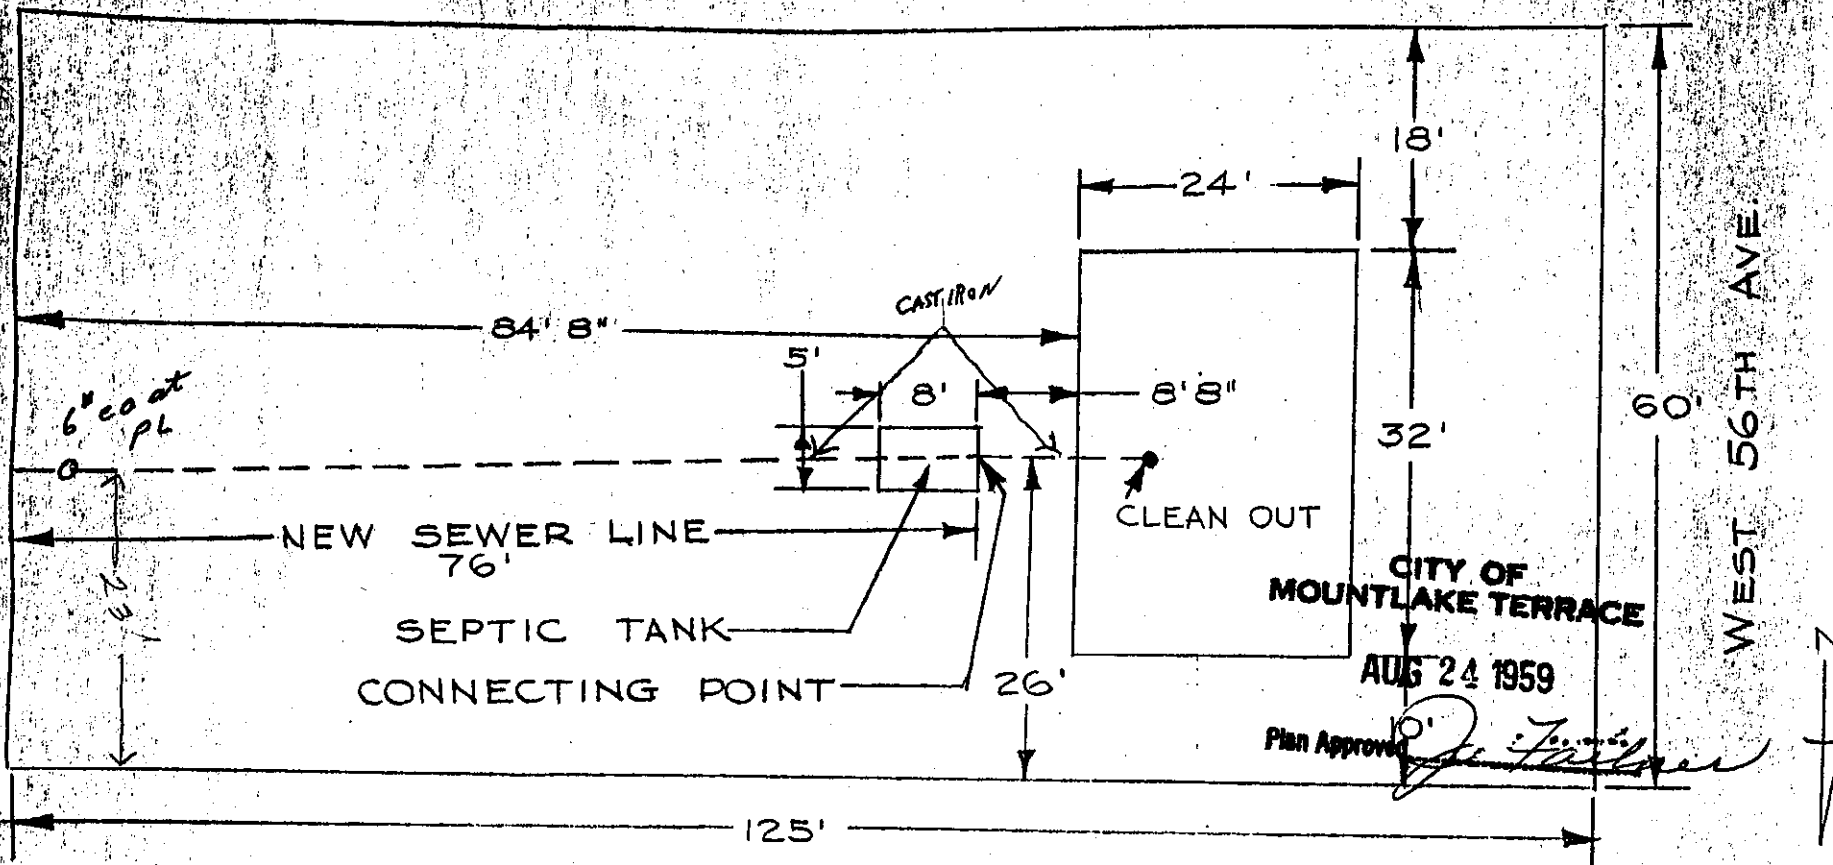

SEPTIC TANK TO BE EMPTIED & FILLED

BACKFILL WORK ORDER ISSUED

Date

DEPOSIT, \$ *10.00*

receipt #3934

Approved:

DATE

8-24-59

BY

INSPECTED N.C.

Scott M. Holt

2-5-60 INST CON S.M.H.