

The City of Mountlake Terrace

APPLICATION

for

SIDE SEWER PERMIT

OUTSIDE ☒ INSIDE ☐ REPAIRS ☐


CARD No. 0

EASEMENT No. _____

OWNER _____ CONTRACTOR V&S Septic Service PERMIT No. U-5-82

HOUSE No. 21327 STREET 44TH AVENUE LOT No. _____ BLOCK No. _____

NAME ADD _____

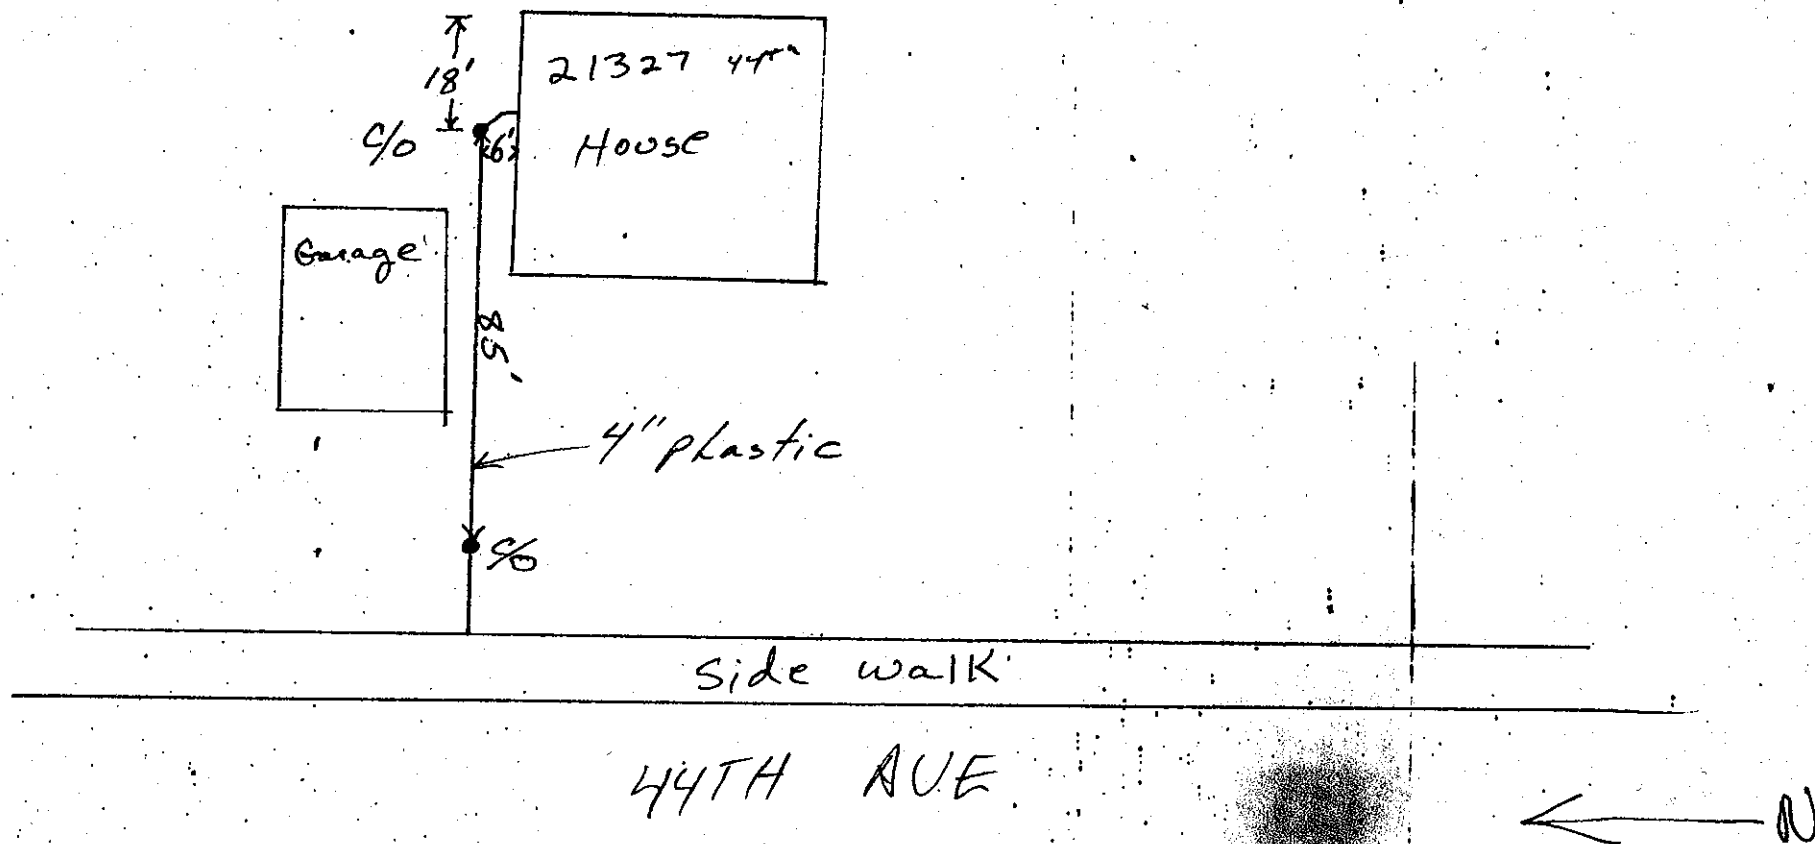

BACKFILL WORK ORDER ISSUED 2-18-82 ^{Date} DEPOSIT, \$ _____
SEWER WORK ORDER ISSUED _____

Approved: _____

DATE 2-18-82 BY J. Kwaka