

PLAN	DATE	BY	CHKD.
DESIGNED			
PLANNED			
NOTED			
NO. 248			

PROFILE	DATE	BY	CHKD.
DESIGNED			
PLANNED			
NOTED			
NO.			

Scan Name: scans00501.pdf  
Scan Date:

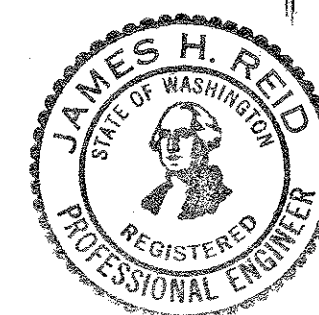
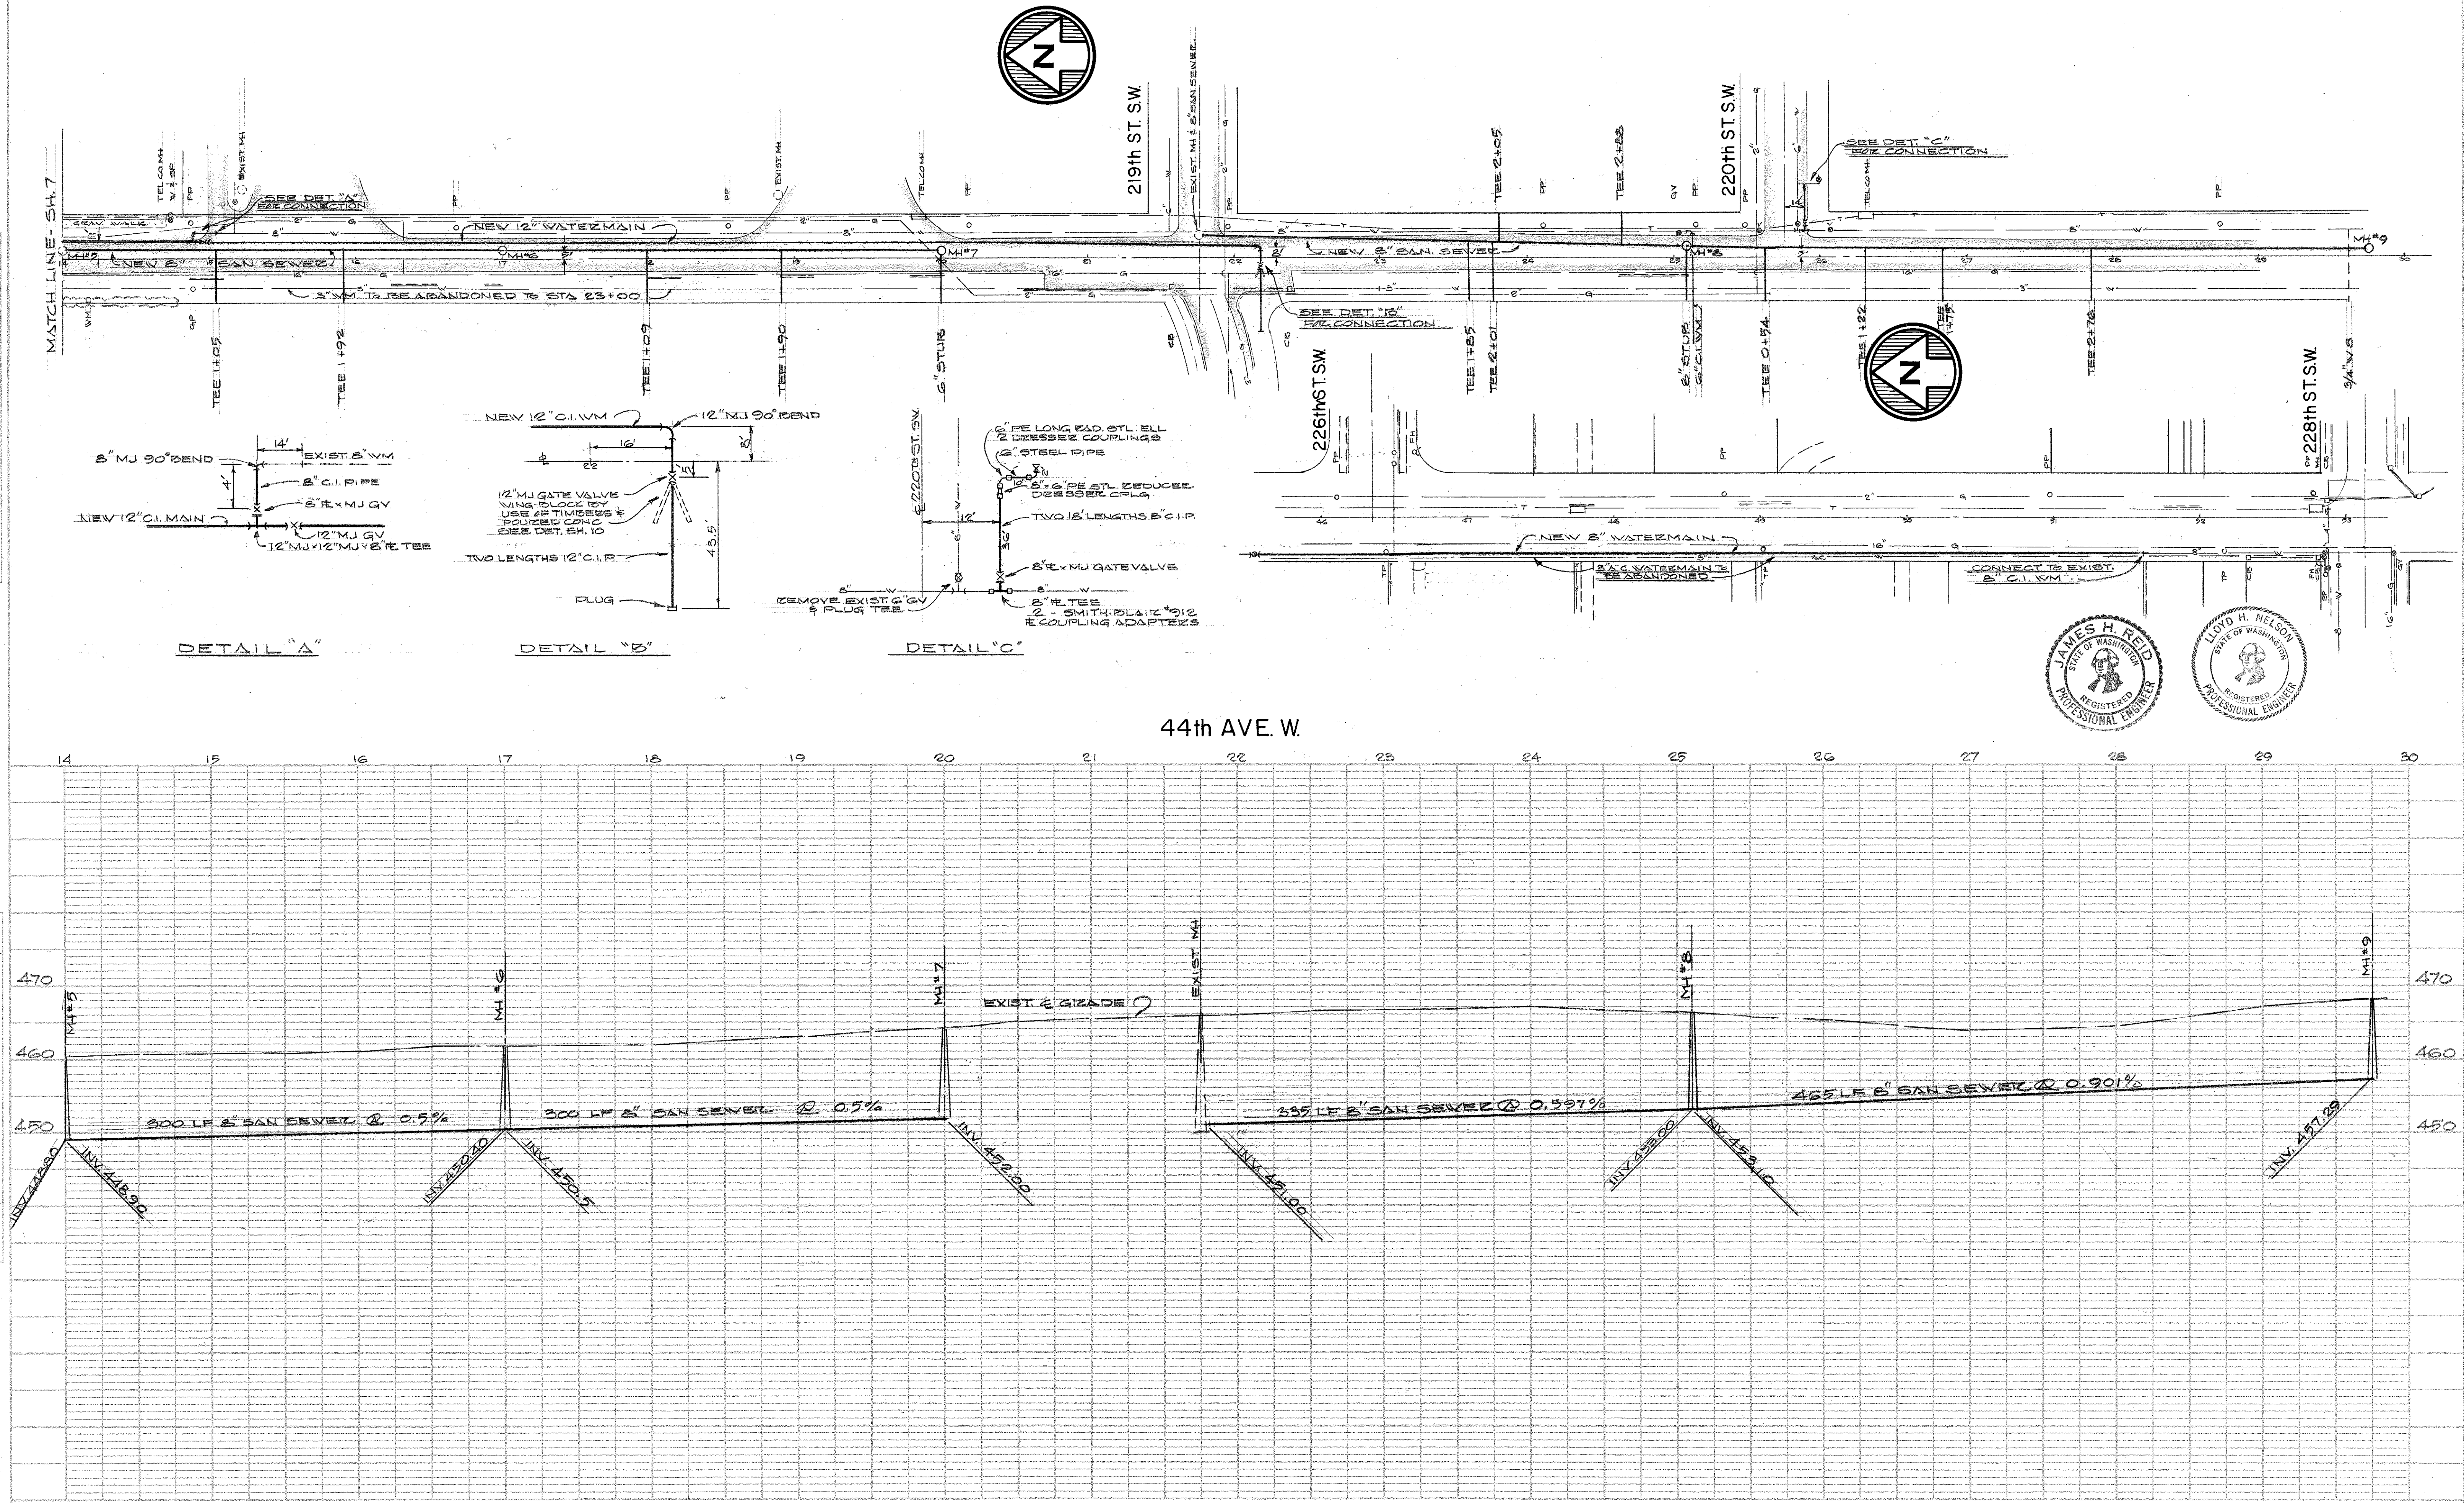


PLATE 1 - PLAN - PROFILE - F.A.S.  
CLEARPRINT PAPER CO., S. F. CAL.  
NO. 1000-1

REID, MIDDLETON & ASSOCIATES, INC.  
CONSULTING ENGINEERS & LAND SURVEYORS, 324 MAIN ST., EDMONDS, WASH.

DESIGN	DRAWN	CHECKED	DATE	H. SCALE	V. SCALE	FILE NO.
LHN	LF	LHN	MAY 1968	1"=50'	1"=10'	5,329-08

AS BUILT DRAWING

URBAN ARTERIAL PROJECT - NO. 2-1-141 (1) - PHASE I  
44th AVE. W. - 212th ST. SW TO 228th ST. SW.  
SCHED. II - III - SANITARY SEWER & WATERMAIN  
PLAN & PROFILE  
SHEET 5 OF 10