
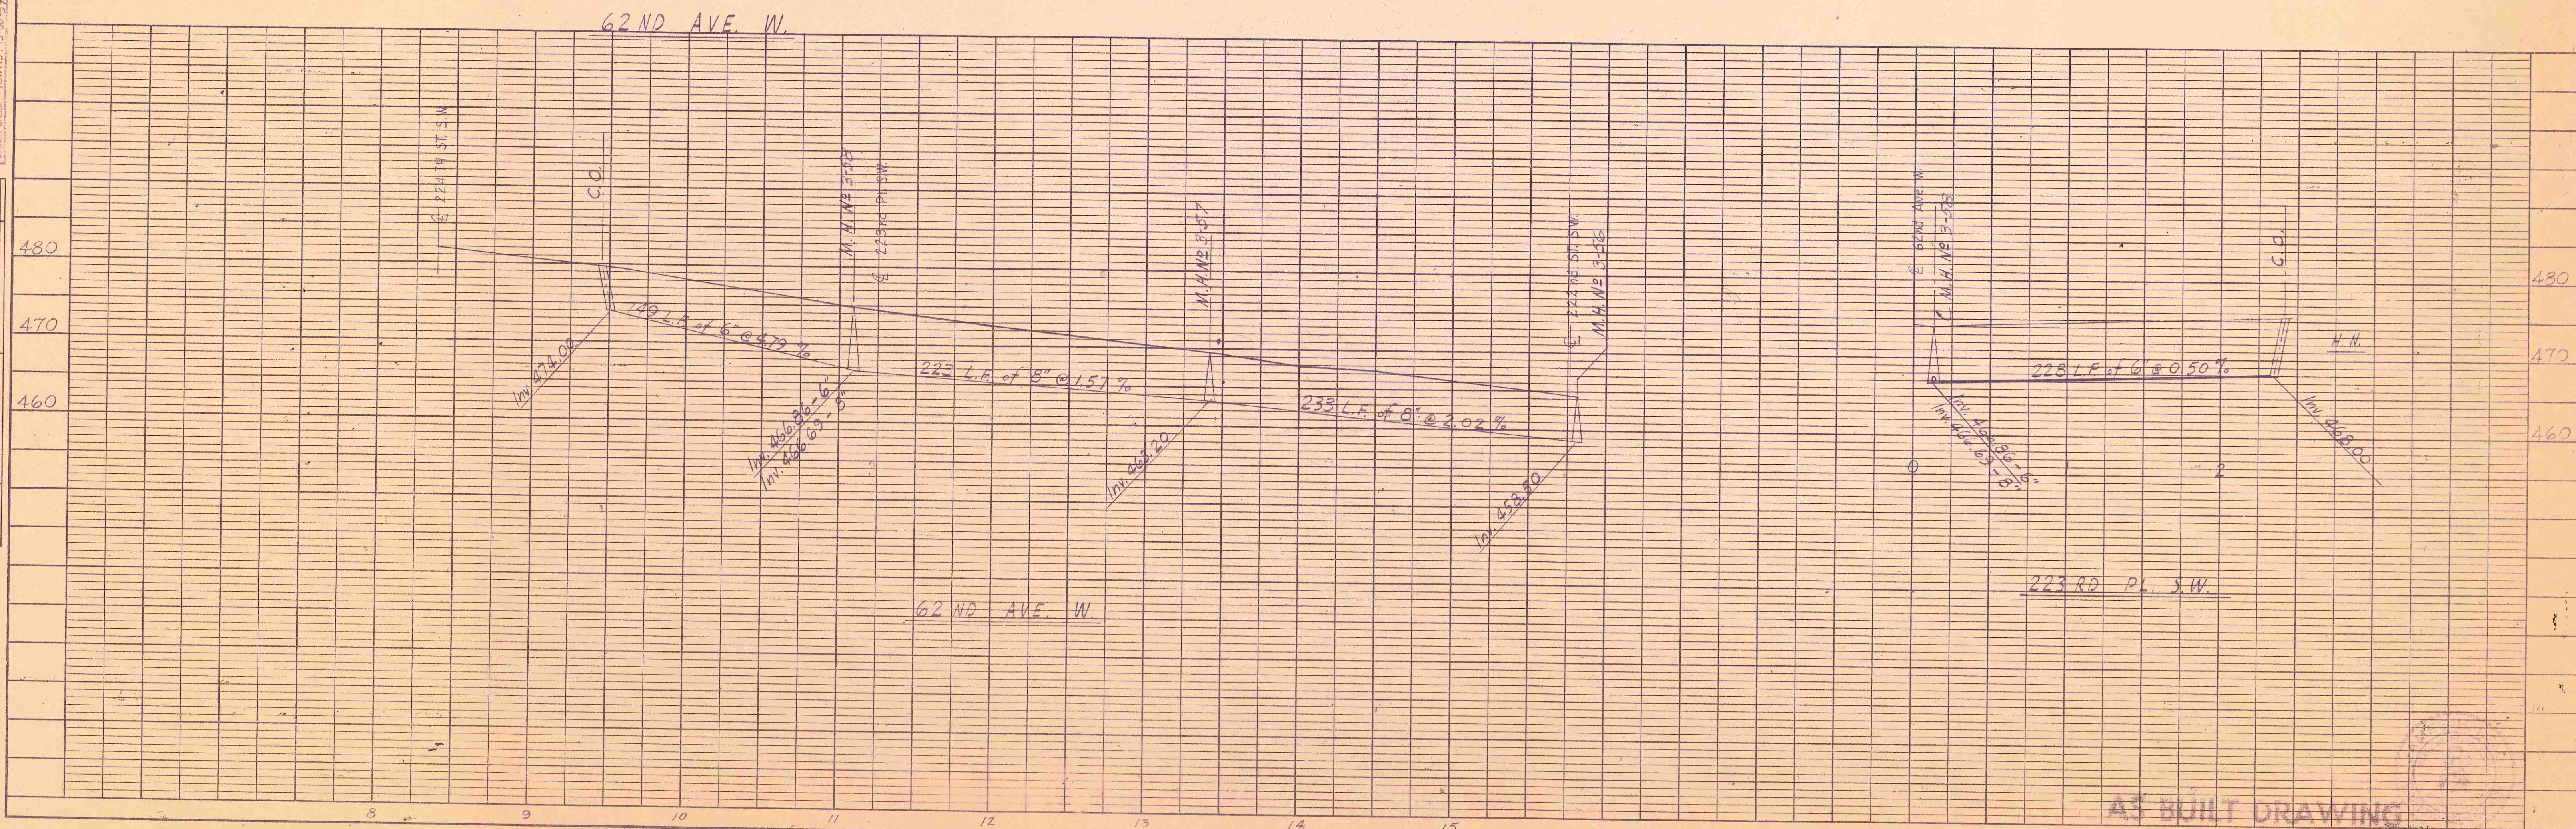


PROFILE	SURVEYED	BY	DATE
	PLOTTED	<i>D.D.</i>	<i>10-27-58</i>
NOTE BOOK	GRADES CHECKED	<i>D.D.</i>	
	B. M. & NOTED		
NO. <i>117-560</i>	STRUCTURE NOTATIONS CH'D		

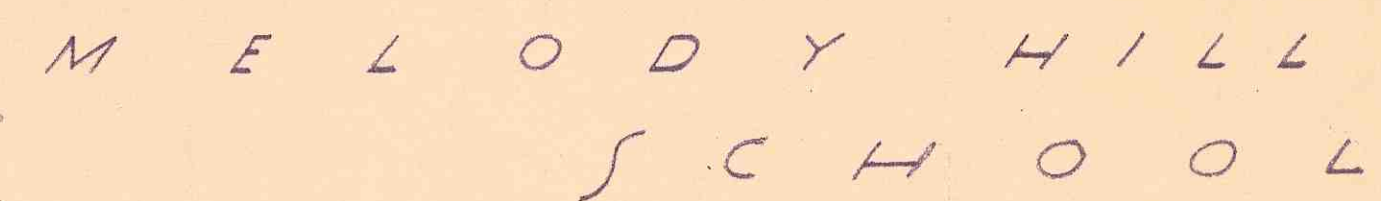

AS BUILT DRAWING

PLATE 1- PLAN - PROFILE - F. A. S.
CLEARPRINT PAPER CO., S. F. CAL.
No. 1000H-1

JAMES H. REID & ASSOCIATES
CONSULTING ENGINEERS, 324 MAIN ST., EDMONDS, WASH.

DESIGN	DRAWN	CHECKED	DATE	H. SCALE 1"=50'	FILE NO. 550/3-13
L.N.	H.H.	E.N.	3-30-59	V. SCALE 1"=10'	SHEET 13 OF 19

CITY OF MOUNTLAKE TERRACE
SEWERAGE SYSTEM UNIT 3