

APPLICATION

for

SIDE SEWER PERMIT

The City of ~~Edmonds~~

Mount Lake Terrace

NEW CONSTRUCTION ☐

REPAIRS ☐

EASEMENT No.

OWNER

Jim Hellenstedt

CONTRACTOR

North End Septic Tank

PERMIT No.

ADDRESS

22400 - 39 Ave W.

LEGAL DESCRIPTION: LOT No.


3

BLOCK No.

A

NAME OF ADDITION

Cedar Grove # 2

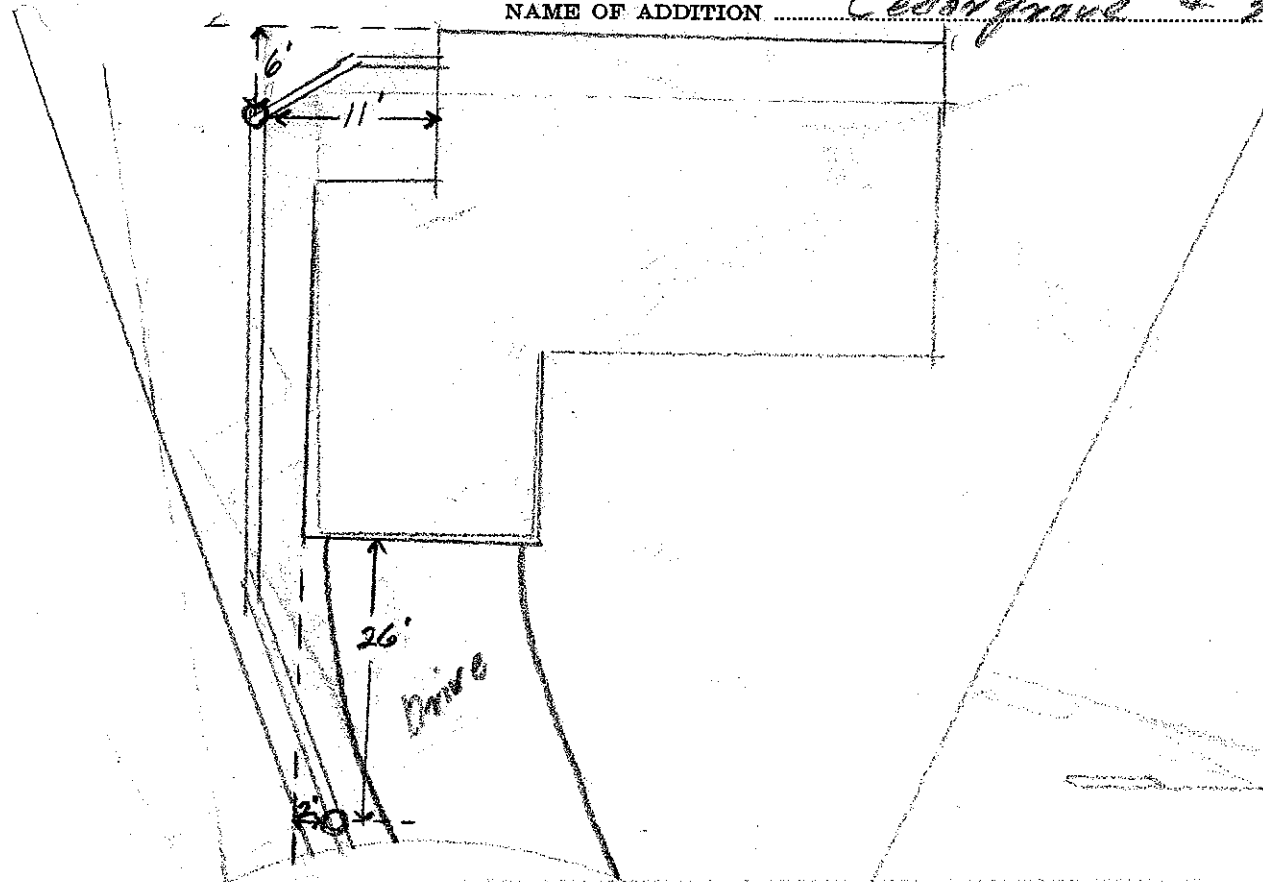

NOTICE: This permit is valid only for the purpose stated herein and is not to be used for any other purpose. The City of Edmonds reserves the right to cancel this permit at any time if it is determined that the work is not being completed in accordance with the terms of the permit.

The City of ~~Edmonds~~

APPROVED: _____

DATE

By

APPLICATION