
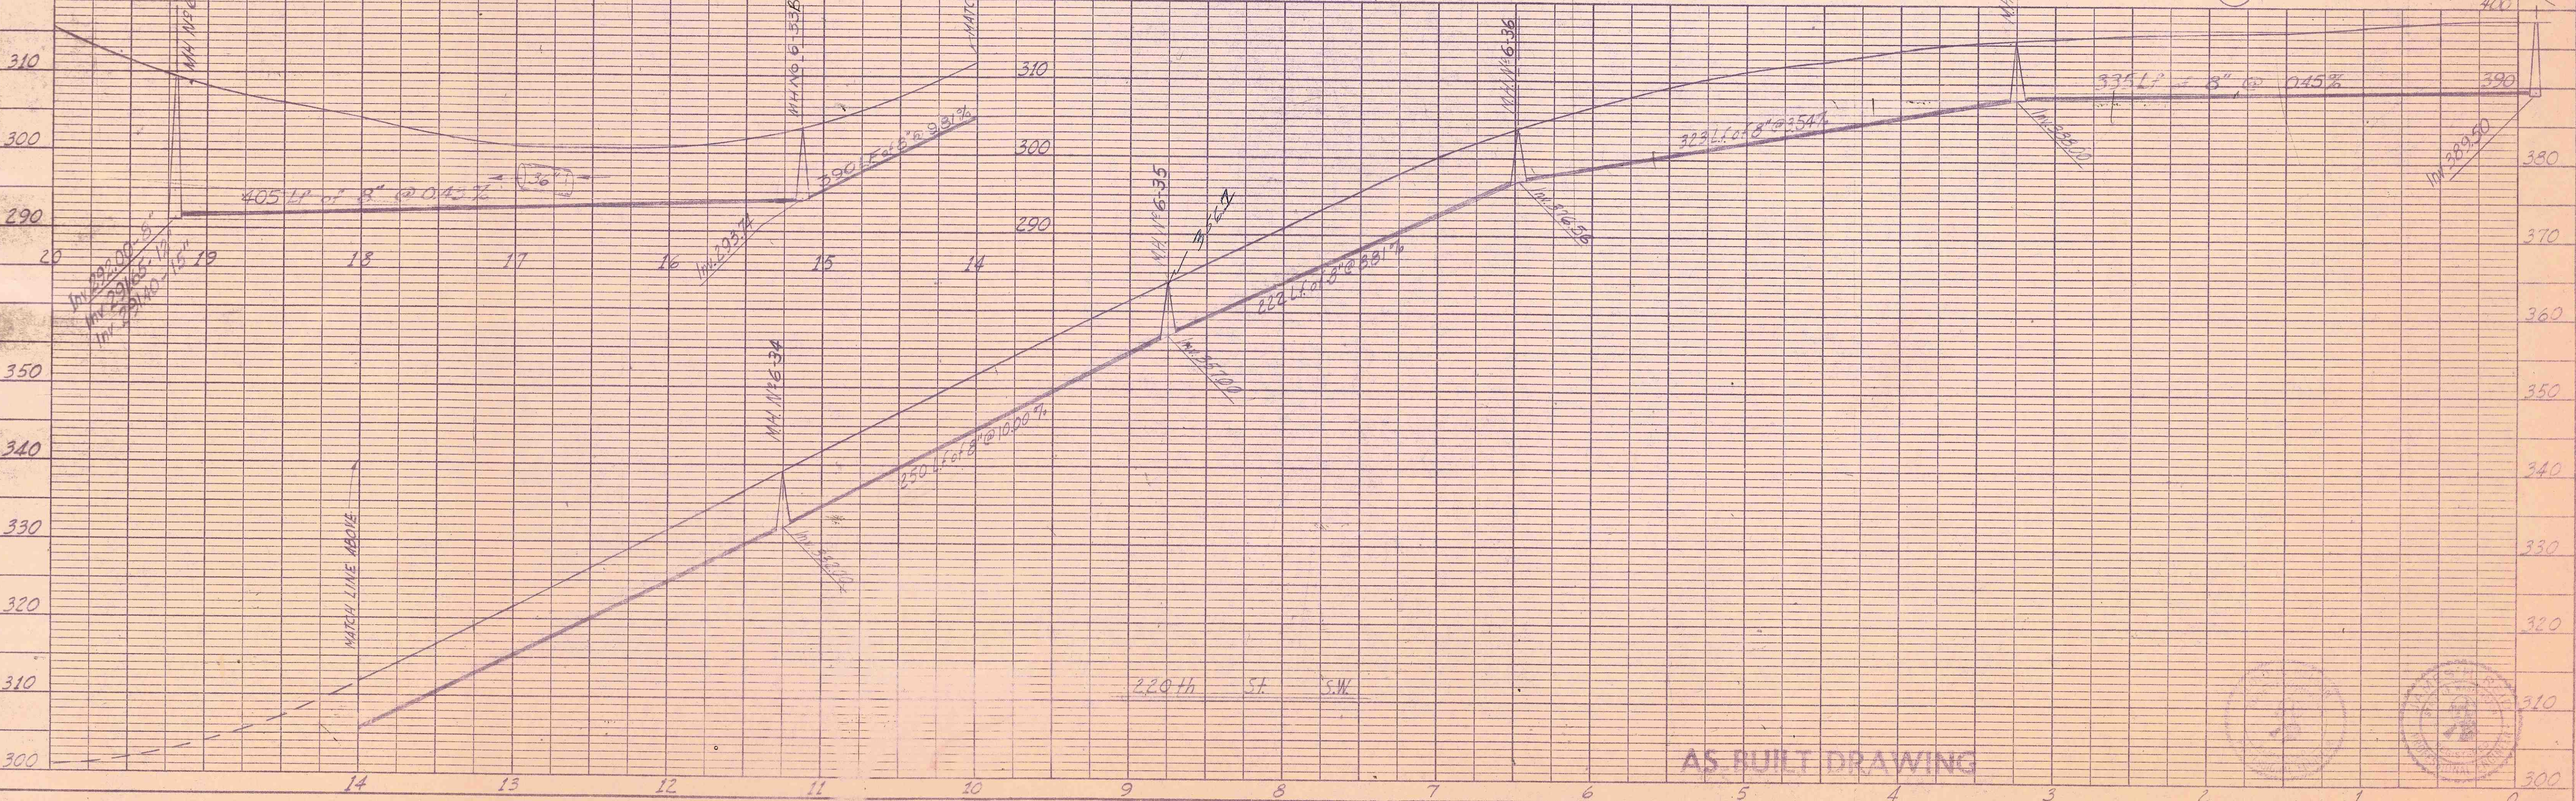


PLAN
 SURVEYED
 NOTE BOOK
 ALIGNED
 RT OF WAY CHECKED
 NO. 11-2-2
 DATE 11-1-59
 BY J.H.R.

DATE 11-1-59
 BY J.H.R.
 CHECKED
 DATE 11-1-59
 BY J.H.R.

PROFILE
 GRADES CHECKED
 NOTE BOOK
 GRADES CHECKED
 NO. 11-2-2
 DATE 11-1-59
 BY J.H.R.

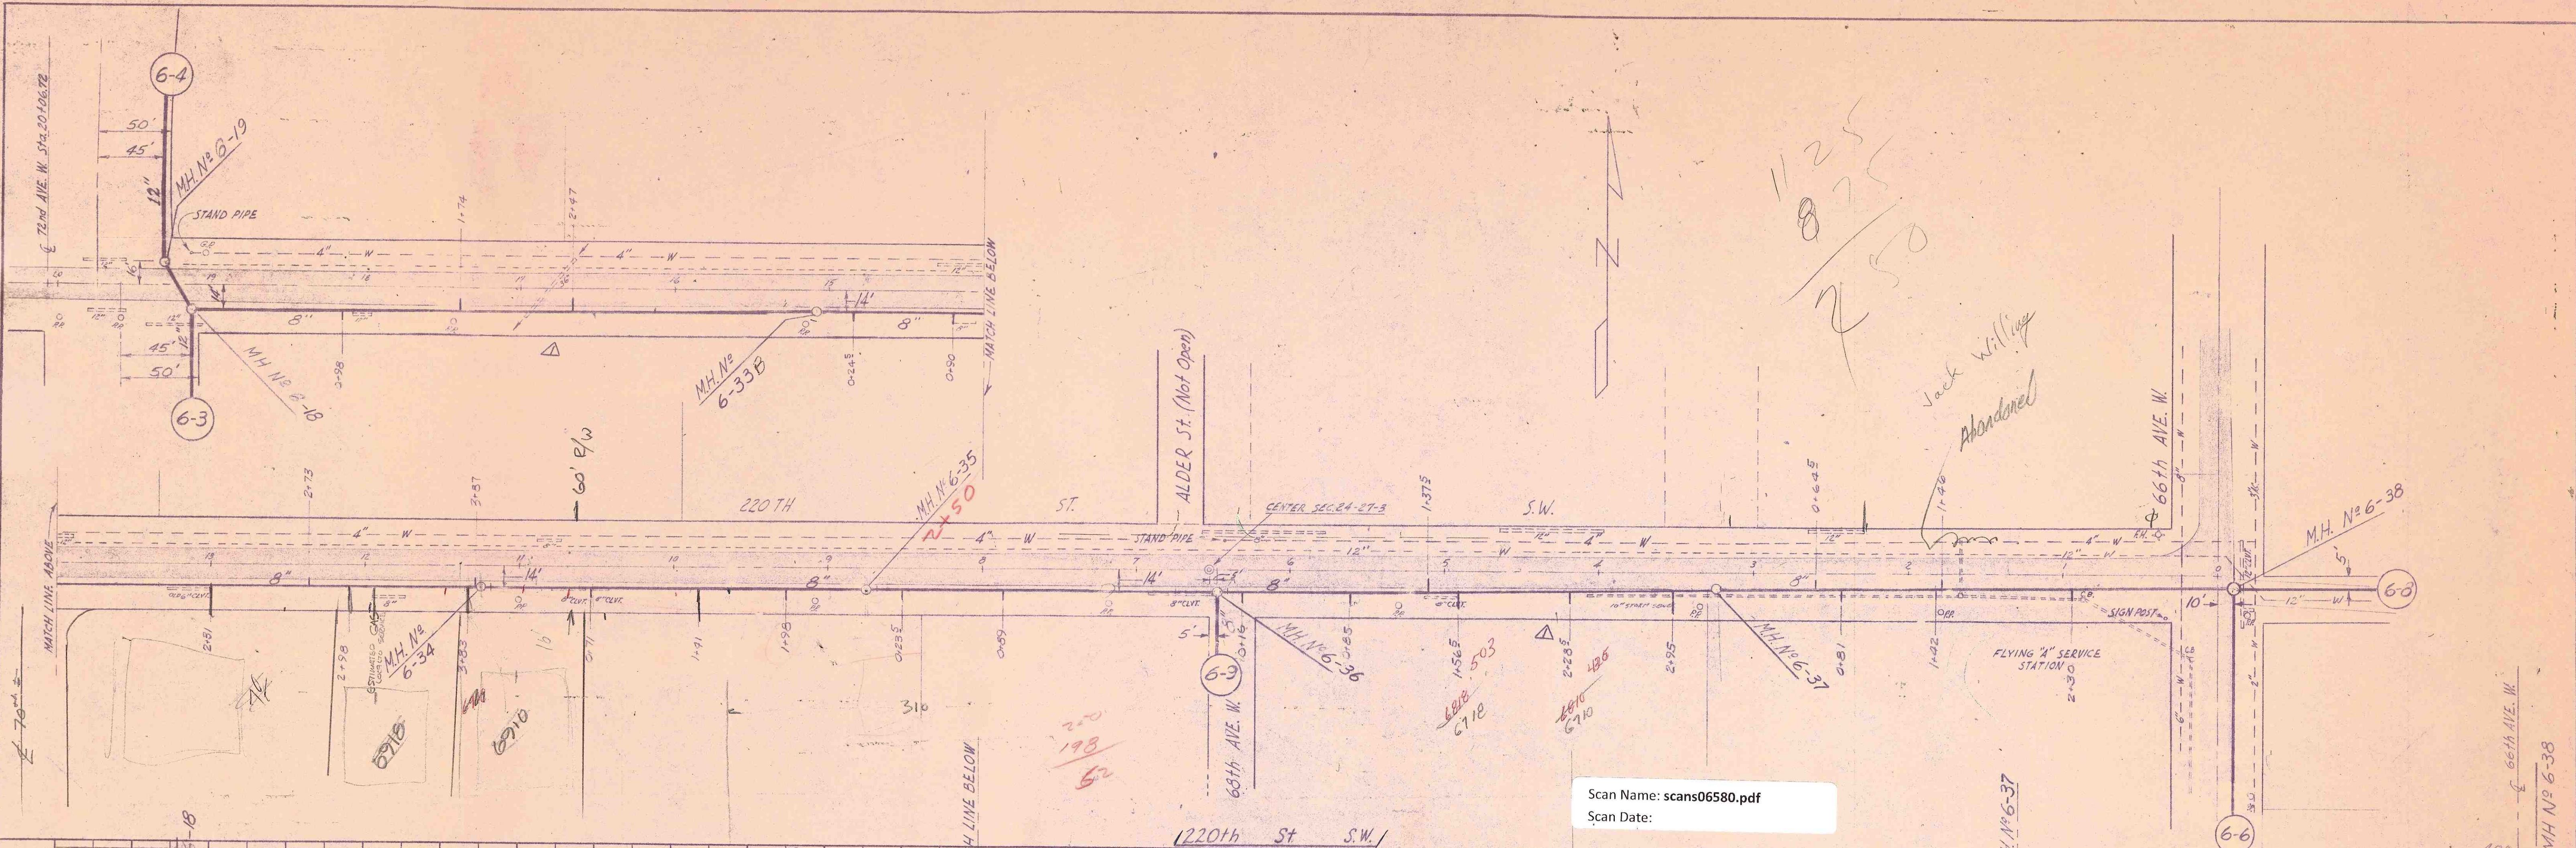

AS BUILT DRAWING

PLATE 1-PLAN-PROFILE-F.A.S.
 CLEARPRINT PAPER CO. S.F. CAL.
 NO. 30001

JAMES H. REID & ASSOCIATES
 CONSULTING ENGINEERS, 324 MAIN ST., EDMONDS, WASH.
 DESIGN DR. LN. 5-12-59
 DATE 5-12-59
 H. SCALE 1"=50'
 V. SCALE 1"=10'
 FILE NO. 5.50/6/7
 SHEET 7 of 10
 CITY OF MOUNTLAKE TERRACE
 SEWERAGE SYSTEM UNIT 6