
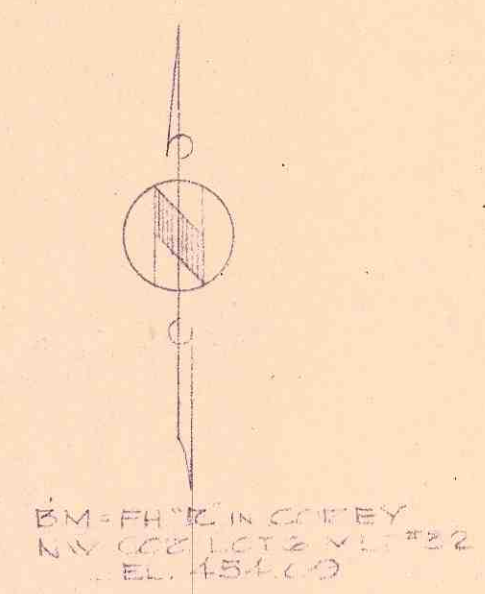
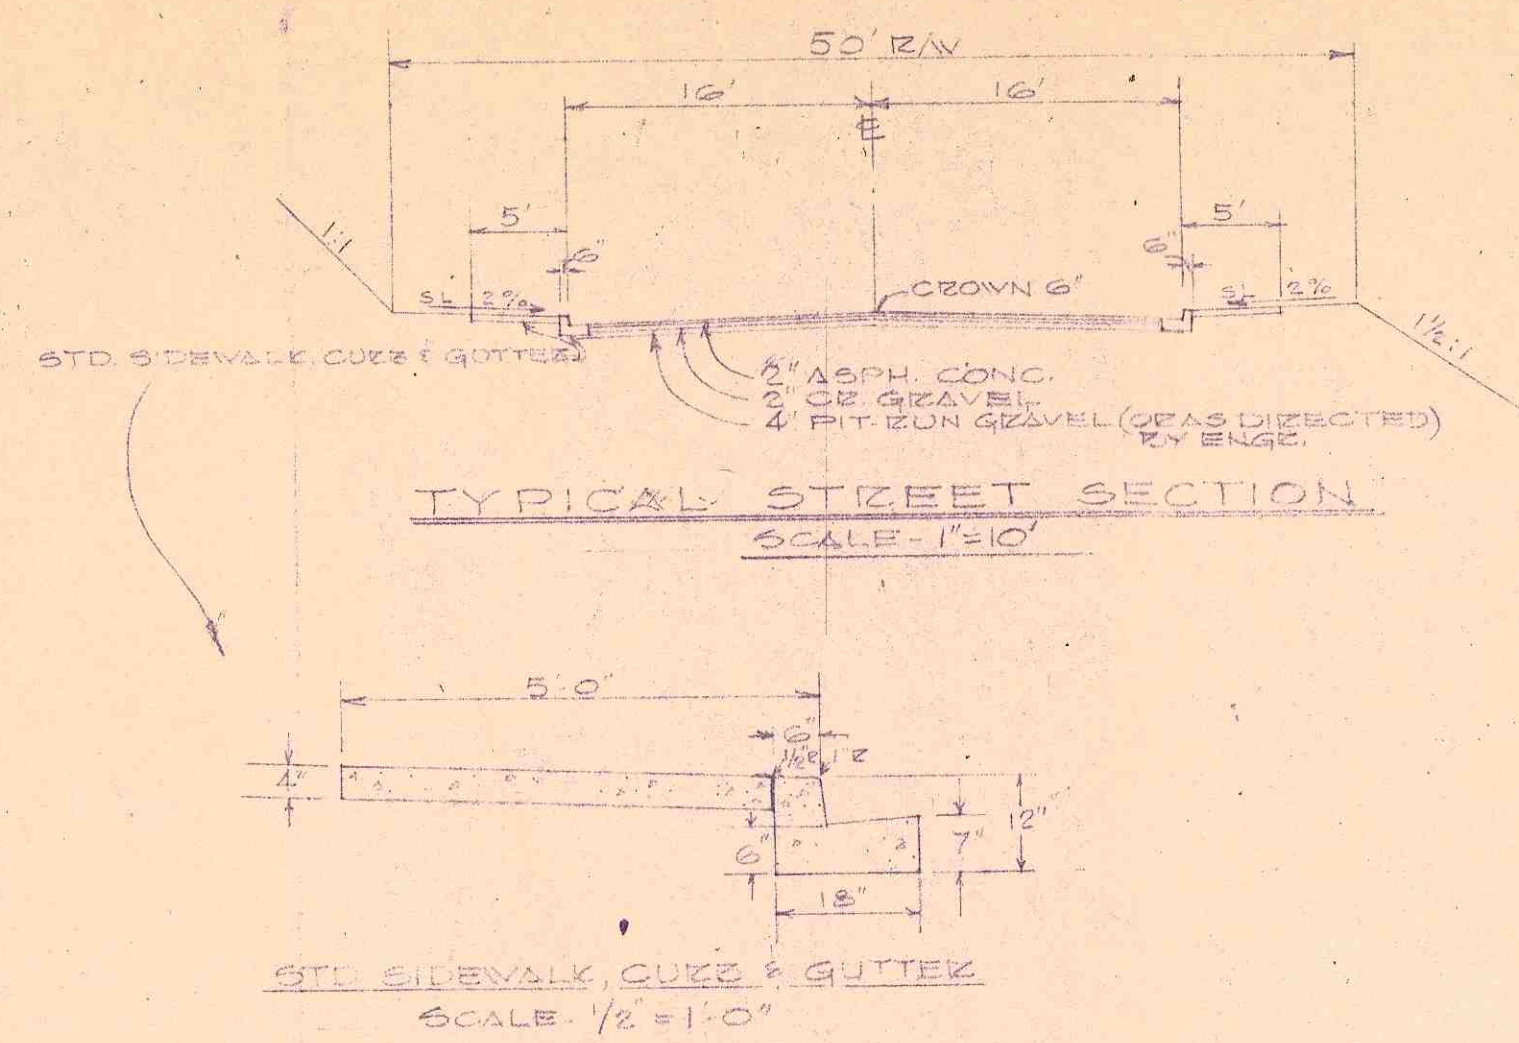



PLAN	DATE	
	BY	
	SURVEYED	
	NOTED	

PROFILE	DATE	
	BY	
	SURVEYED	
	NOTED	

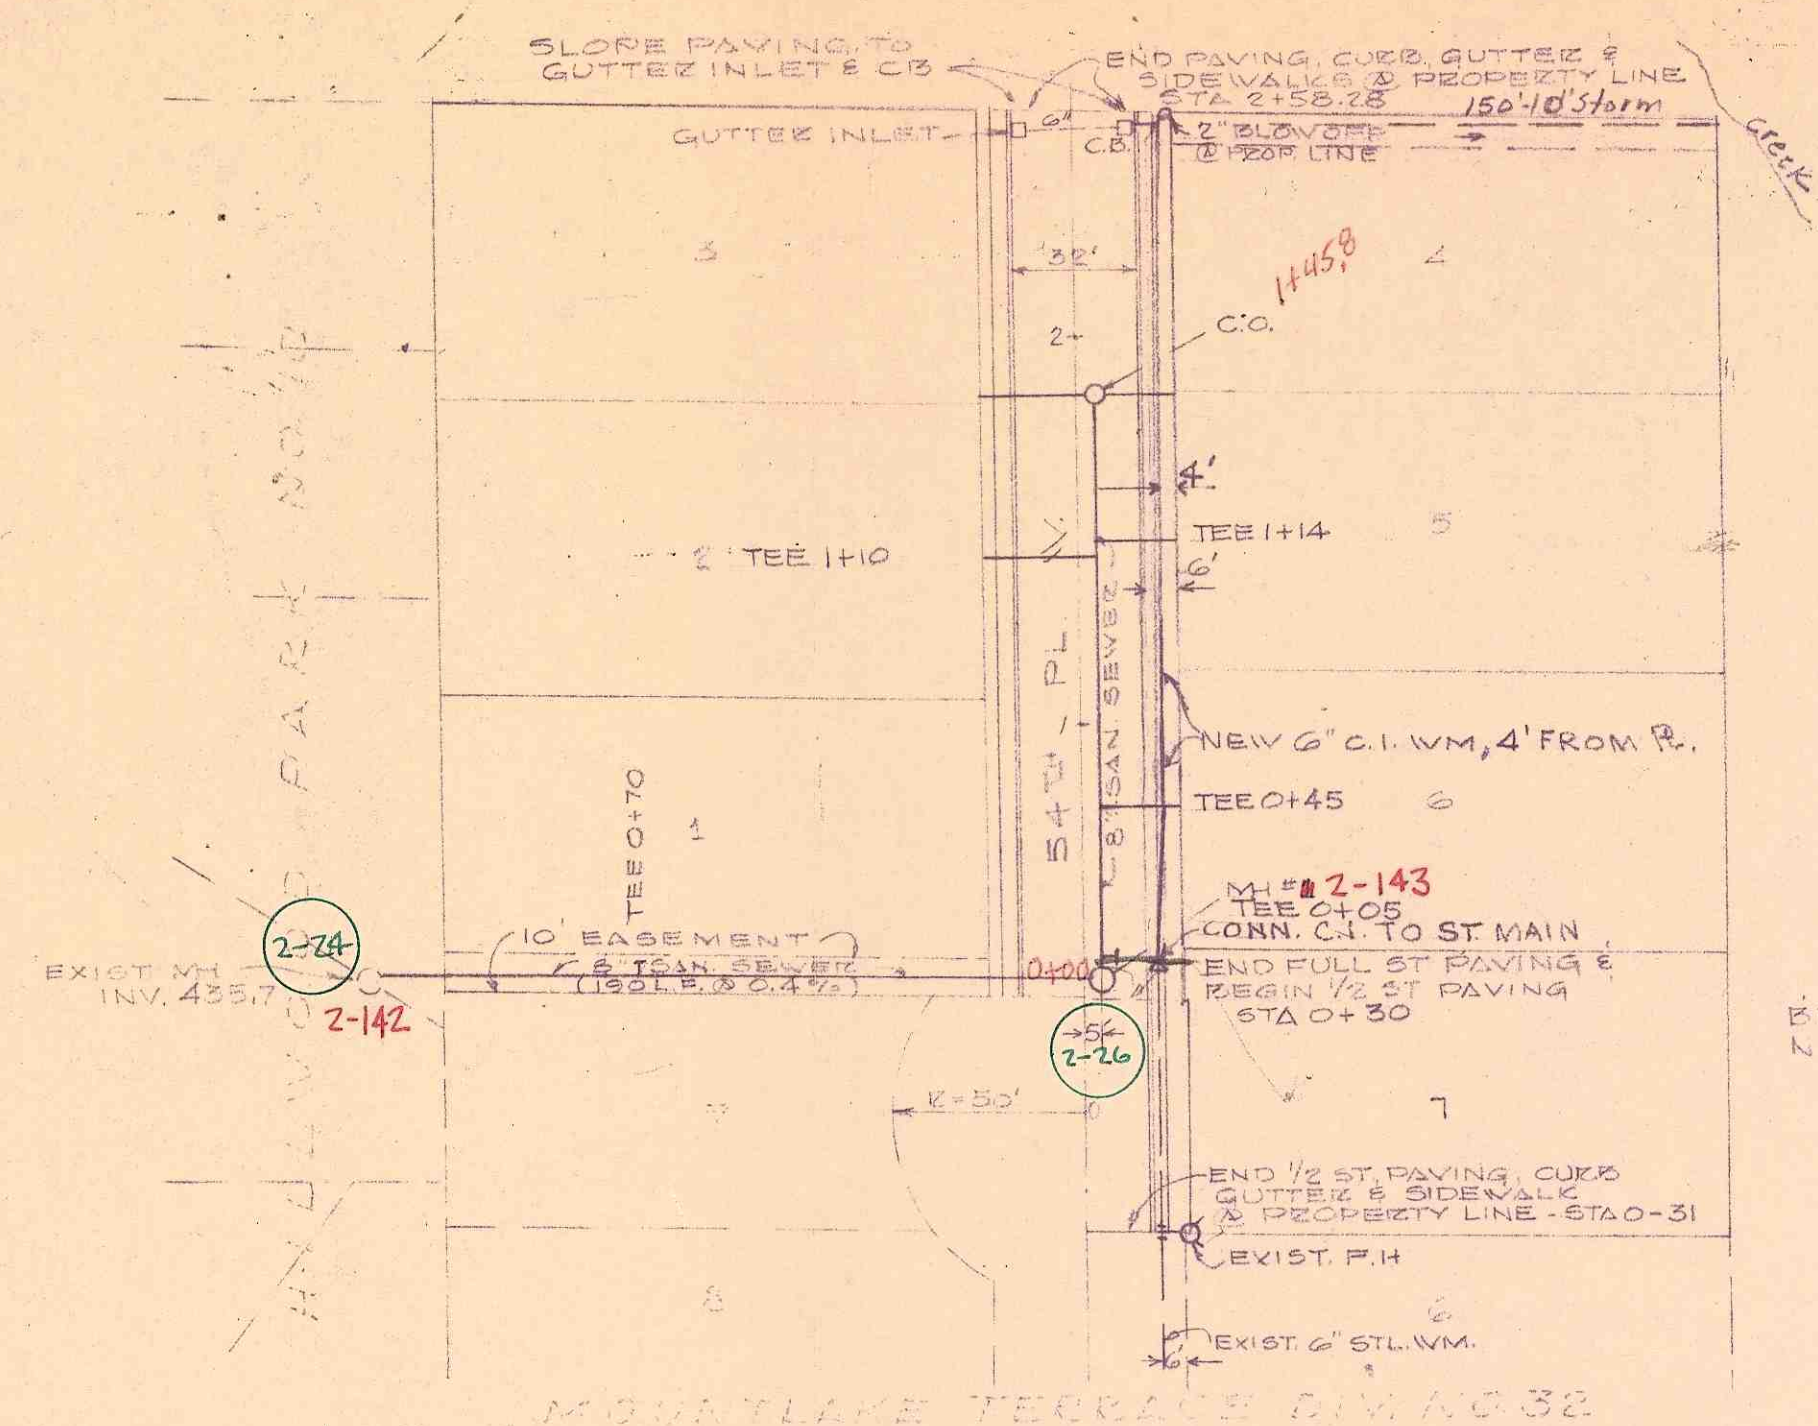

Scan Name: scans06346.pdf  
Scan Date:

NO.	REVISIONS	DATE	BY
CITY OF MOUNTLAKE TERRACE			
STREET PAVING, CURBS, GUTTERS & SIDEWALKS, 8\"/>			
SHAKLET			
REID, MIDDLETON & ASSOCIATES, INC.			
CONSULTING ENGINEERS & LAND SURVEYORS			
324 MAIN STREET EDMONDS, WASHINGTON			

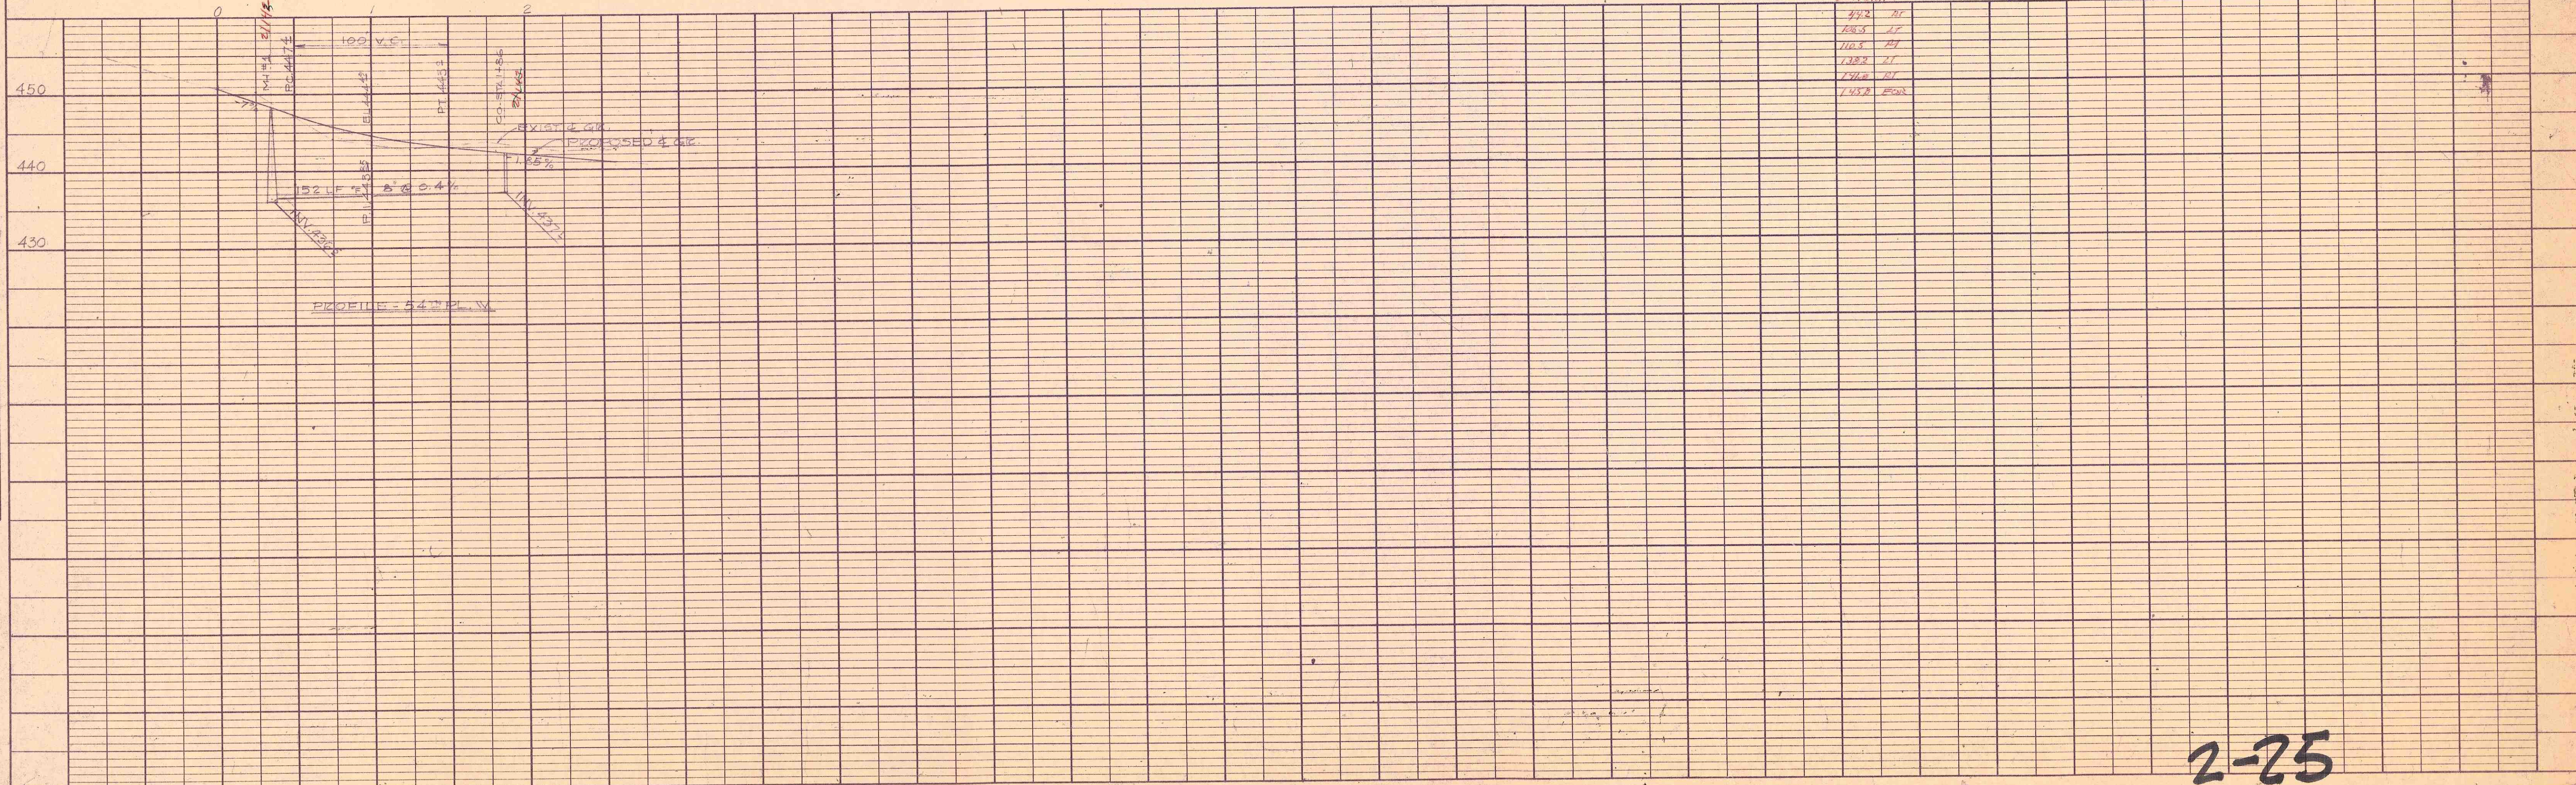

STATION	ELEVATION
144.5	437.5
145.0	437.5
145.5	437.5
146.0	437.5
146.5	437.5
147.0	437.5

2-25  
AS BUILT DRAWING  
REID, MIDDLETON & ASSOCIATES, INC.  
2-23-84