
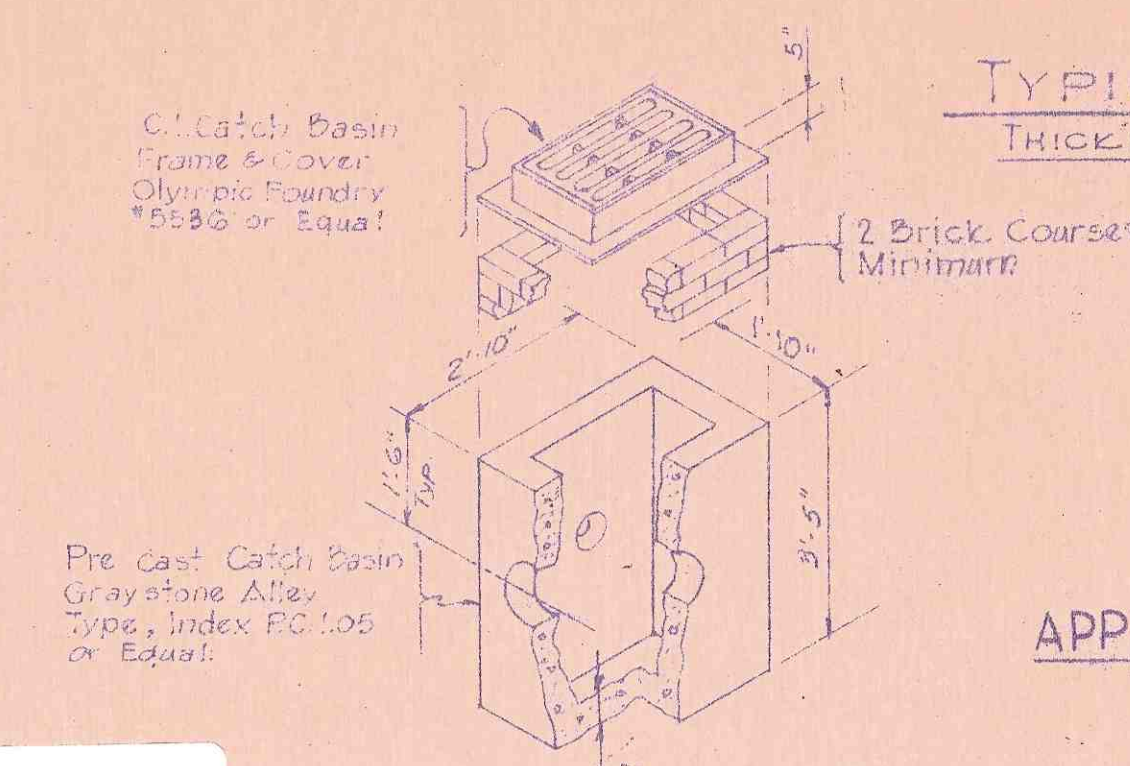
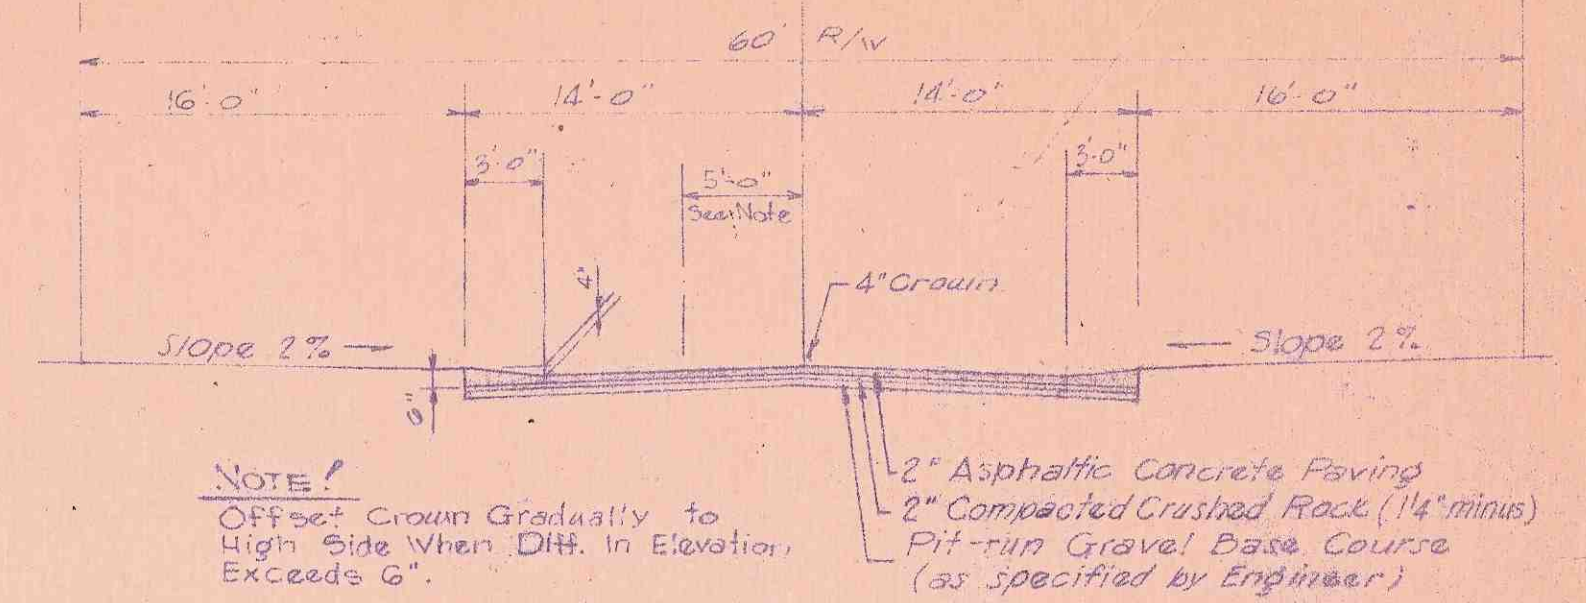


PLAN	SURVEYED	BY	DATE
NOTE BOOK	PLOTTED		
	ALIGNMENT CHECKED		
	RT. OF WAY CHECKED		
NO.			

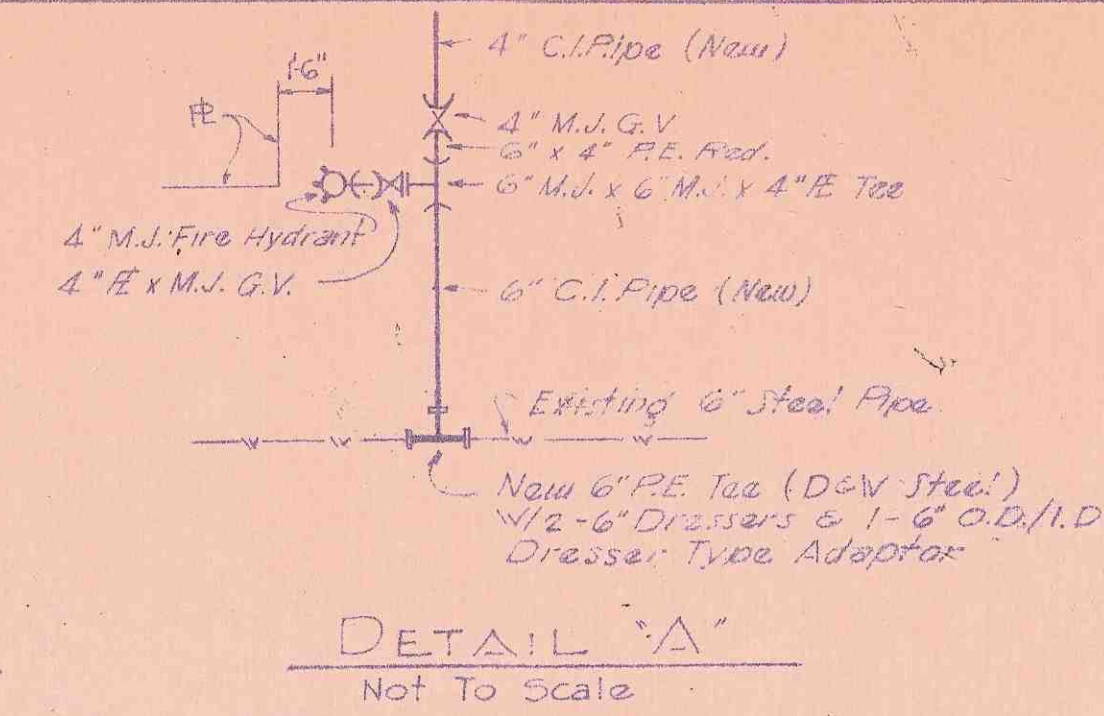

APPROVED BY: James H. Reid
CITY ENGINEER, CITY OF MOUNTLAKE TERRACE

Scan Name: scans06513.pdf
Scan Date:

CATCH BASIN DETAIL

Sewerage Unit 3-17-A-1

SEWAGE SYSTEM, WATERMAINS,
STORM SEWERS & PAVING

BROOKS ADDITION

Scale Horiz 1"=10', Vert 1"=50'

5.121A

PLATE 1. PLAN - PROFILE - P.R.S.
CLEARPRINT PAPER CO., S.F. CAL.
NO. 1000H-3

AS BUILT DRAWING
SEWERS

REID, MIDDLETON & ASSOCIATES
Consulting Engineers - Land Surveyors
324 MAIN ST. EDMONDS, WASH.

FB 34 P 24