
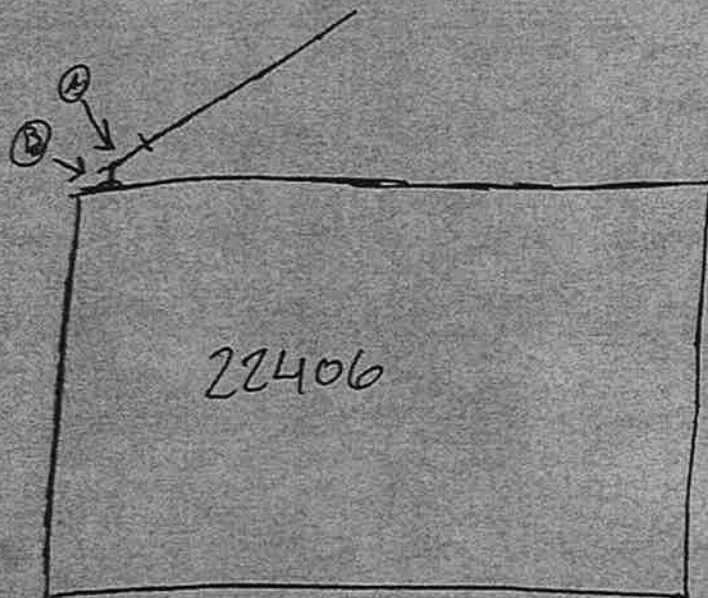


# AS Built for 22406 59<sup>th</sup> PLW

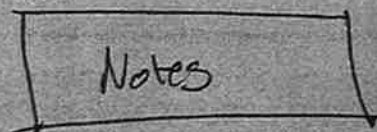

(A) 4" Sch 40 WYE  
16" in depth

(B) 4" clearest to grade  
2 1/2' N° off SW° corner of home  
12" W° off SW° corner of home

\* All material Sch 40  
Strongback fence's