

The City of Mountlake Terrace

APPLICATION  
for  
SIDE SEWER PERMIT  
OUTSIDE ☐ INSIDE ☐ REPAIRS ☐

CARD No.

EASEMENT No. 1385322

OWNER Joseph Ranzou

CONTRACTOR DURRATT CONSTRUCTION

PERMIT No. 1878

HOUSE No. 22312 58 WEST.

STREET  
AVENUE LOT No. 10 OF THE SECTION 28

BLOCK No.


NAME ADD.

CITY OF  
MOUNTLAKE TERRACE

MAR 7 1960

Plan Approved

J. M. Ahee

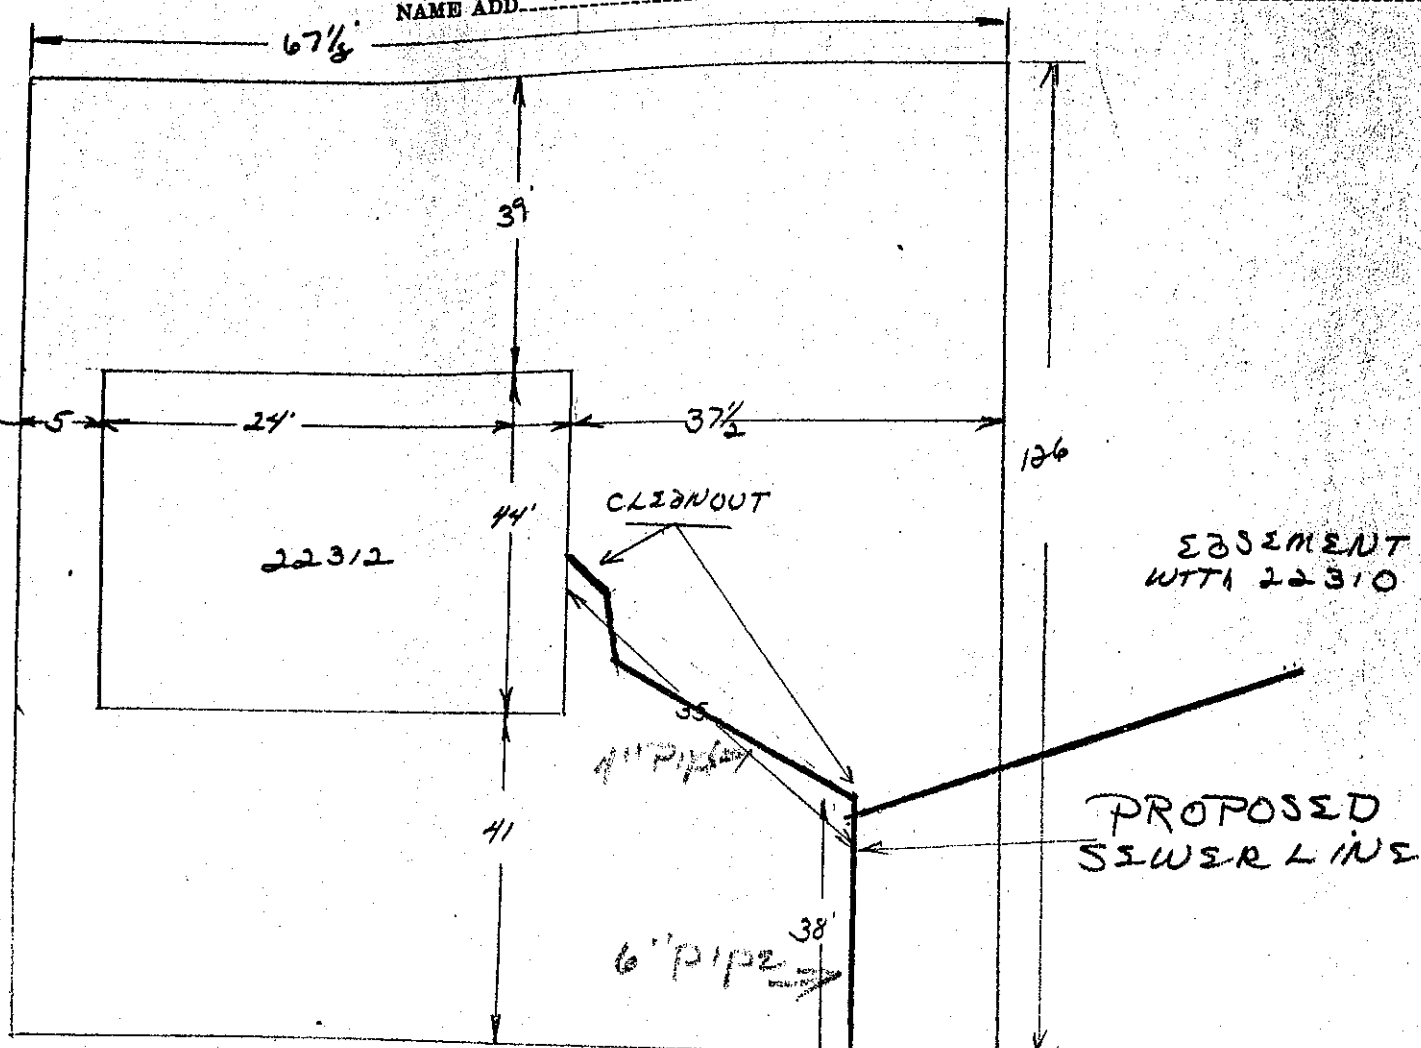

EASEMENT  
WITH 22310

PROPOSED  
SEWER LINE

6\"/>

Date

58 WEST.

Approved:

BACKFILL WORK ORDER ISSUED

DEPOSIT, \$ 10.00

3-7-60

SEWER WORK ORDER ISSUED

73908

DATE 3-8-60

BY Scott M. Holton INST. CON.