

APPLICATION

The City of Mountlake Terrace


SIDE SEWER PERMIT

CARD No. _____

OUTSIDE ☐ INSIDE ☐ REPAIRS ☐

EASEMENT No. _____

OWNER Parkwood Homes Inc CONTRACTOR Lynnwood Septic PERMIT No. 3947
 HOUSE No. 4406 2195W STREET 15 AVENUE LOT No. 15 BLOCK No. 14477
 NAME ADD. Parkwood Lane

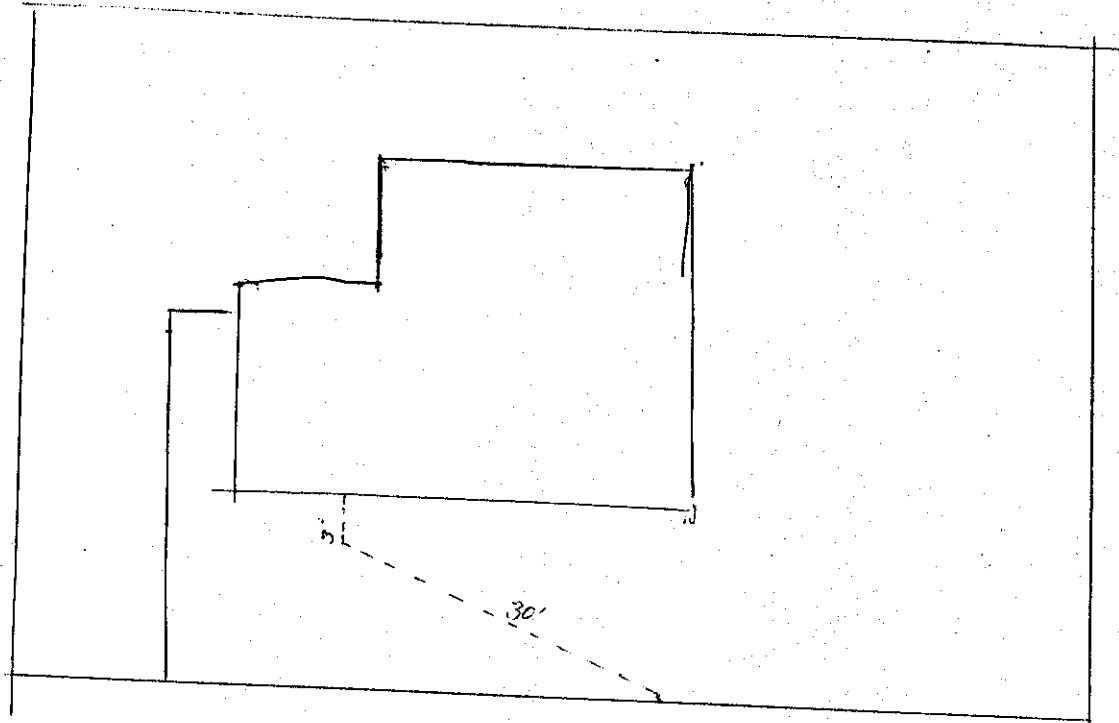

CITY OF
MOUNTLAKE TERRACE

JUN 3 1965
 Plan Approved [Signature]

BACKFILL WORK ORDER ISSUED _____ DEPOSIT, \$ _____
 SEWER WORK ORDER ISSUED _____

Approved: _____
 DATE _____ BY _____