

The City of Mountlake Terrace

# APPLICATION

for

SIDE SEWER PERMIT

OUTSIDE ☐ INSIDE ☐ REPAIRS ☐

CARD No.

EASEMENT No.

OWNER

Hewey T. Hoop

CONTRACTOR

Self

PERMIT No.

1146

HOUSE No.

24302-56th Ave. W

STREET

AVENUE LOT No.


21

BLOCK No.

F

NAME ADD

PLAT OF Mountlake Terrace

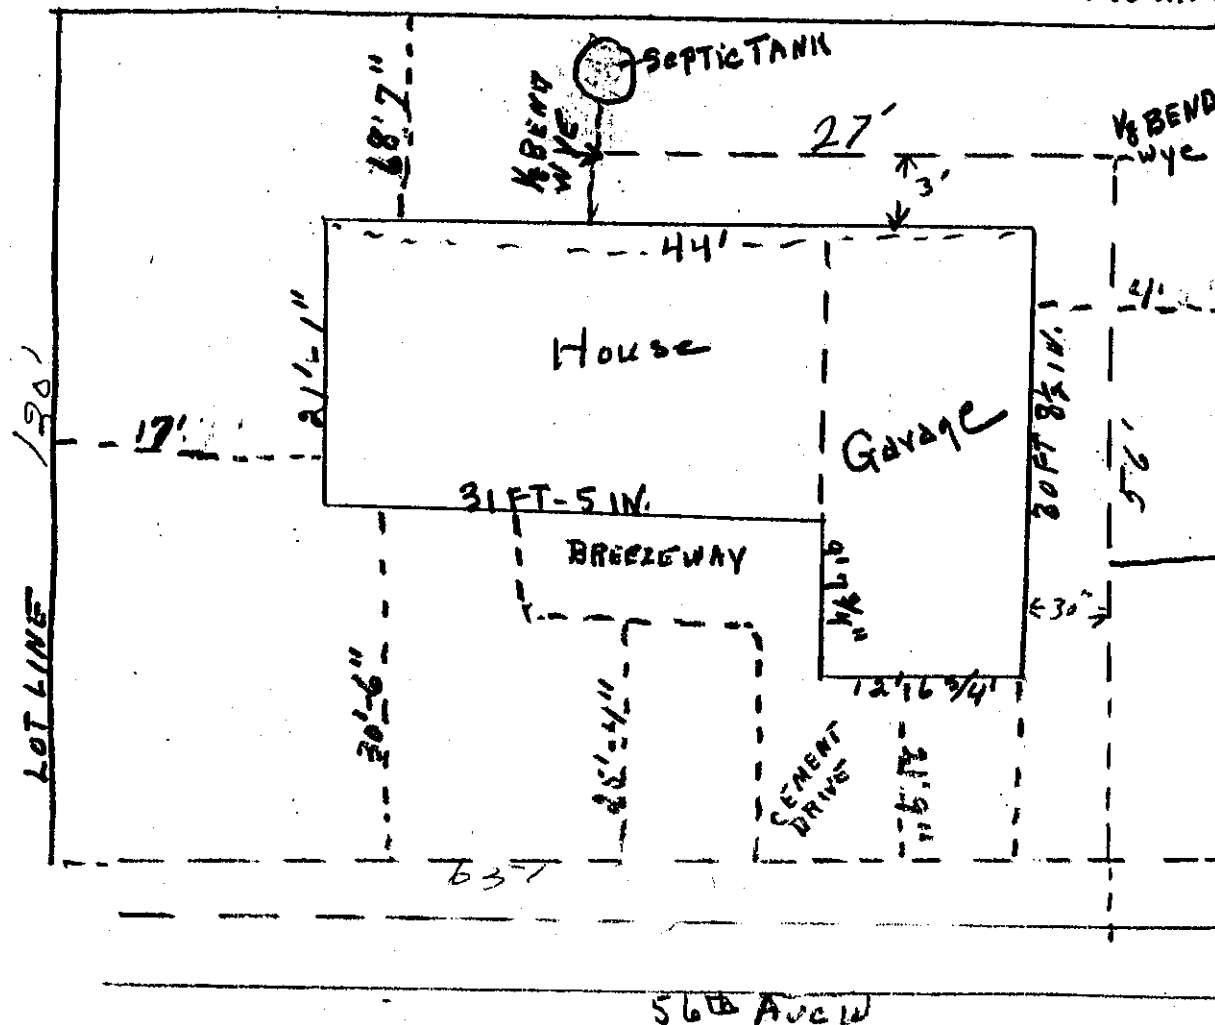

CITY OF  
MOUNTLAKE TERRACE

NOV 30 1959

Plan Approved

J. Fairman  
SMH.

PROPERTY LINE

SEWER MAIN

56th Ave W

Date

Approved:

BACKFILL WORK ORDER ISSUED

DEPOSIT, \$ 10.00

SEWER WORK ORDER ISSUED

11/13/59  
# 480

DATE

11-30-59 BY Scott M. Holton INS  
1-6-60 INST CON SMH N.C.