



DATUM: CITY OF LYNNWOOD
 INV. 5.3 M.H. 680' W. & 44TH AVE. W.
 & 5' S. & 212TH ST. SW. ELEV. 412.74

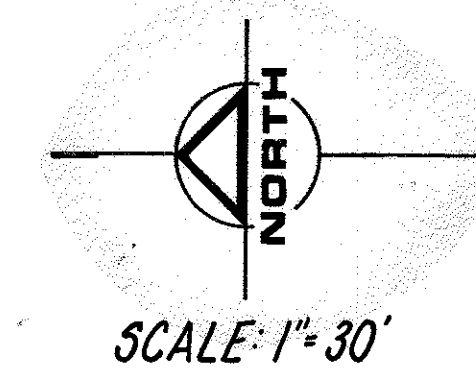

GENERAL NOTES

1. LOCATIONS SHOWN OF EXISTING UTILITIES ARE APPROXIMATE ONLY AND IT SHALL BE THE RESPONSIBILITY OF THE CONTRACTOR TO VERIFY EXACT LOCATIONS SO AS TO AVOID DAMAGE OR DISTURBANCE.
2. ALL WORK AND MATERIALS SHALL CONFORM TO THE STANDARDS OF THE CITY OF MOUNTLAKE TERRACE AND DIVISION III OF THE STANDARD SPECIFICATIONS FOR MUNICIPAL PUBLIC WORKS CONSTRUCTION, WASH. STATE CHAPTER, A.P.W.A., 1977, AS APPROVED BY THE STATE OF WASH., DEPARTMENT OF SOCIAL AND HEALTH SERVICES.
3. MANHOLES SHALL BE STANDARD 48" DIA. PRECAST WITH ECCENTRIC CONE.
4. ALL TRENCHES SHALL BE WATER SETTLED PRIOR TO TESTING OF SEWER FOR ACCEPTANCE.
5. ALL SANITARY SEWER PIPE TO BE JOHNS-MANVILLE, J.M. RINGITE, P.V.C., S.D.R. 35 WITH CLASS "B" BEDDING TO TOP OF PIPE OR EQUAL.
6. CONTRACTOR TO OBTAIN NECESSARY PERMITS FOR WORK IN PUBLIC RIGHT-OF-WAY AND COORDINATE TRAFFIC CONTROL WITH THE CITY OF MOUNTLAKE TERRACE.

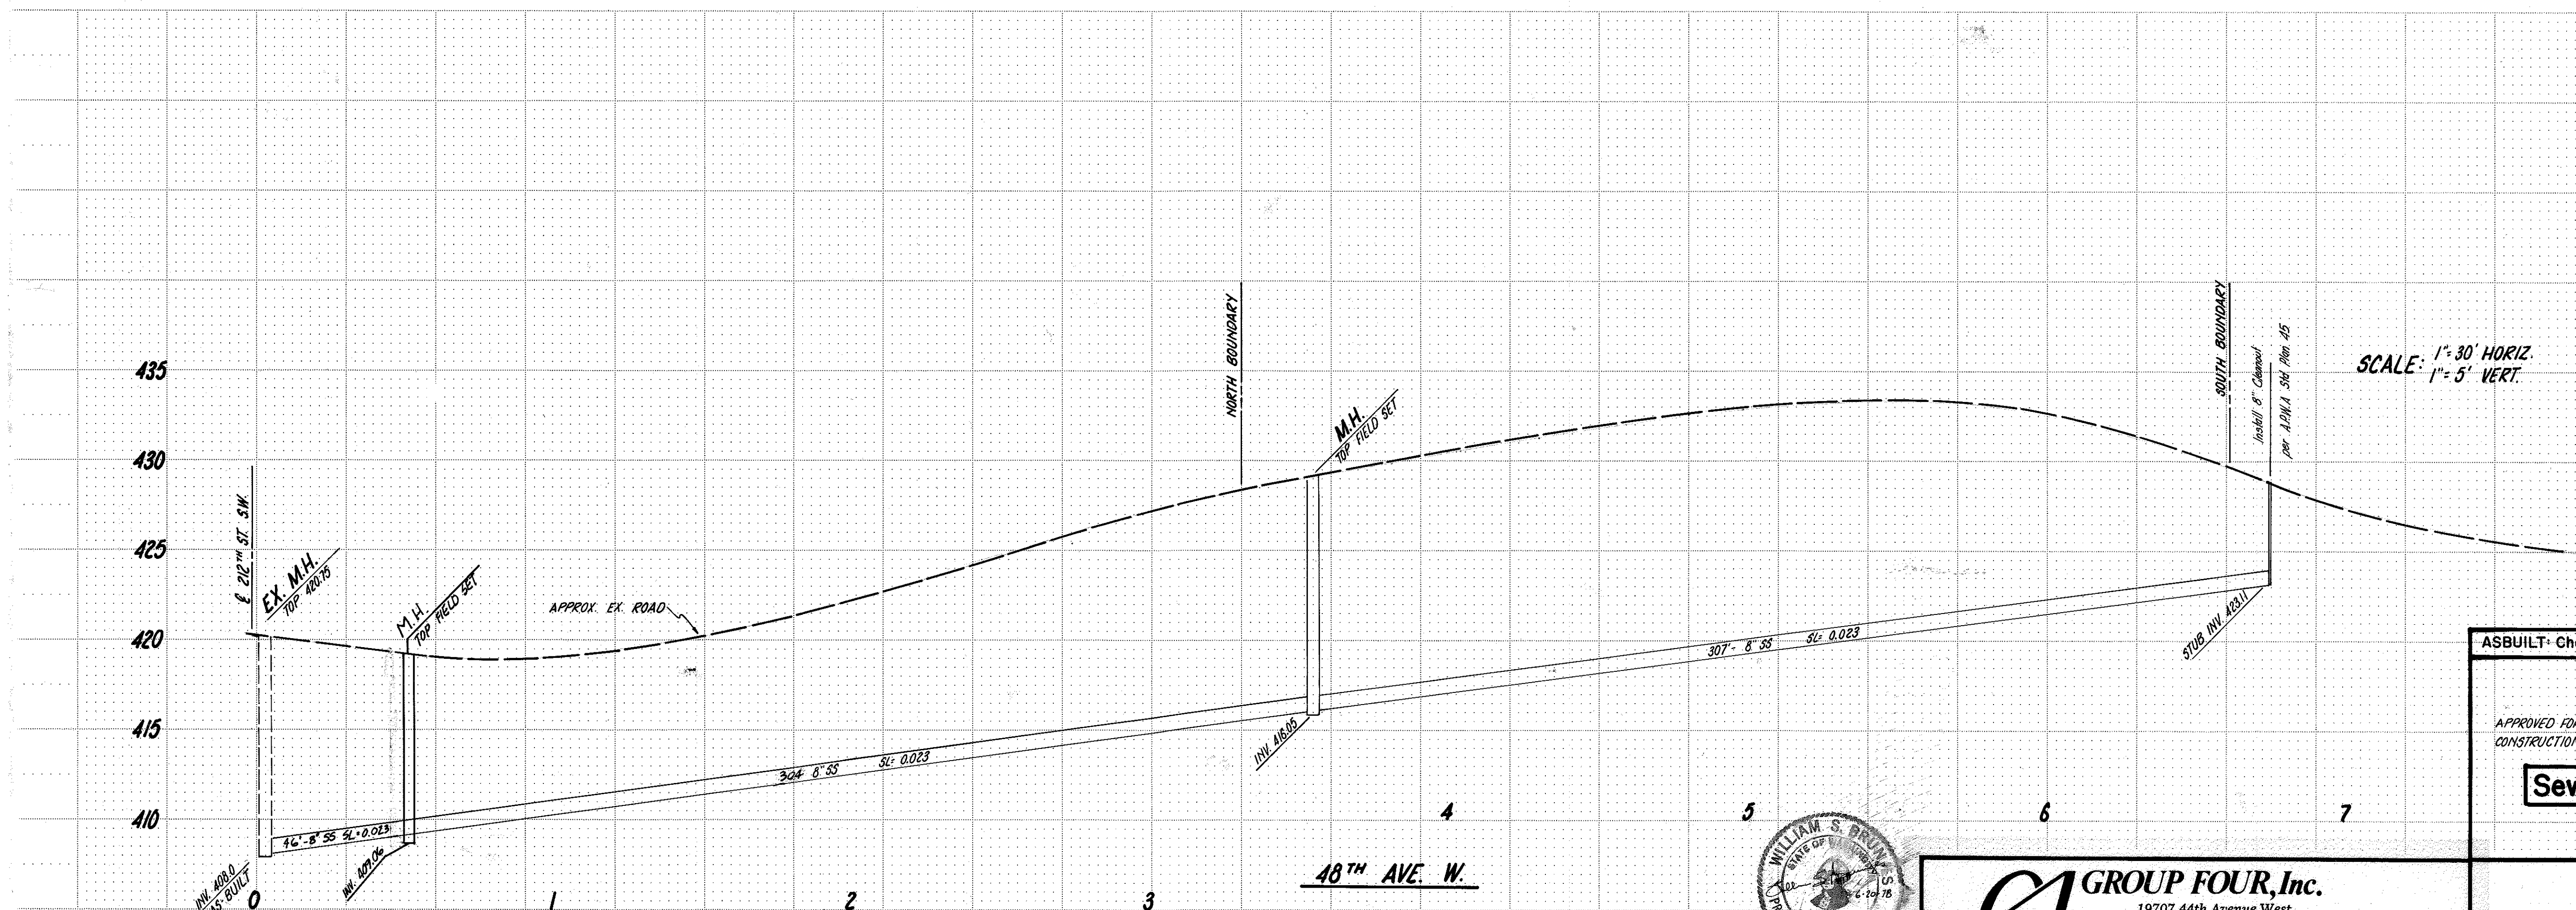

SCALE: 1" = 30' HORIZ.
 1" = 5' VERT.

ASBUILT: Changes from approved plan copied: W. Van Ry Jan. 20, 1983

APPROVED FOR
 CONSTRUCTION

Sewerage Unit 8-6A

Rev. App'd 9/18/10 JEB
 REVISED PER CONTRACTOR 8-17-78 J.H.K.
 ADDED CO. TO PLAN 7-20-78 R.C.N.


SANITARY SEWER EXTENSION
 FOR

48TH AVE. W.

8-6A

MOUNTLAKE TERRACE

WASHINGTON

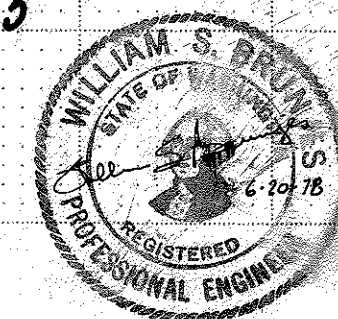

GROUP FOUR, Inc.
 19707 44th Avenue West
 Lynnwood, Washington 98036 • 206.775-4581
 SURVEYING ENGINEERING PLANNING MANAGEMENT
 DRAWN BY R.C.N. 6-14-78 CHECKED BY J.B. DE APPROVED BY W.B.