
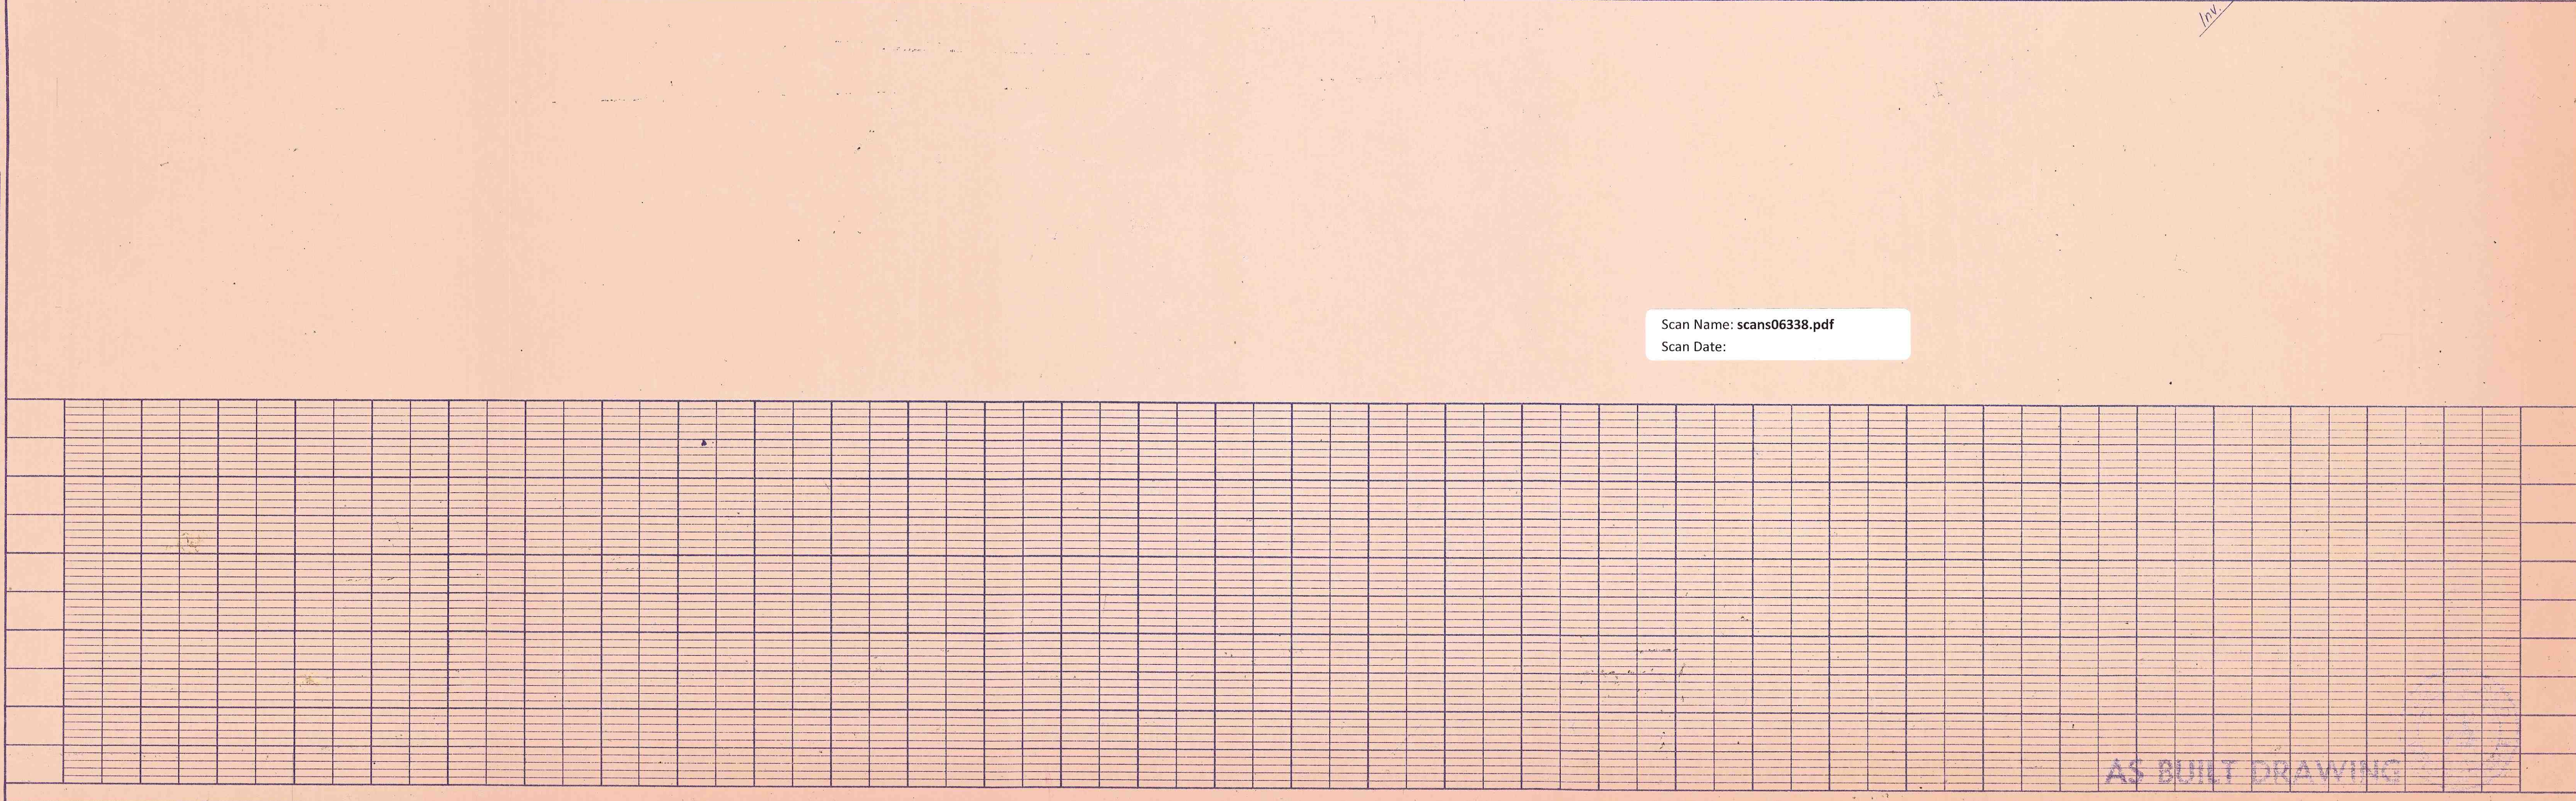


PLAN	REVISION	DATE
	BY	DATE
NOTE BOOK	NO.	DATE
	NO.	DATE

DATE	BY
DATE	BY

DATE	BY
DATE	BY

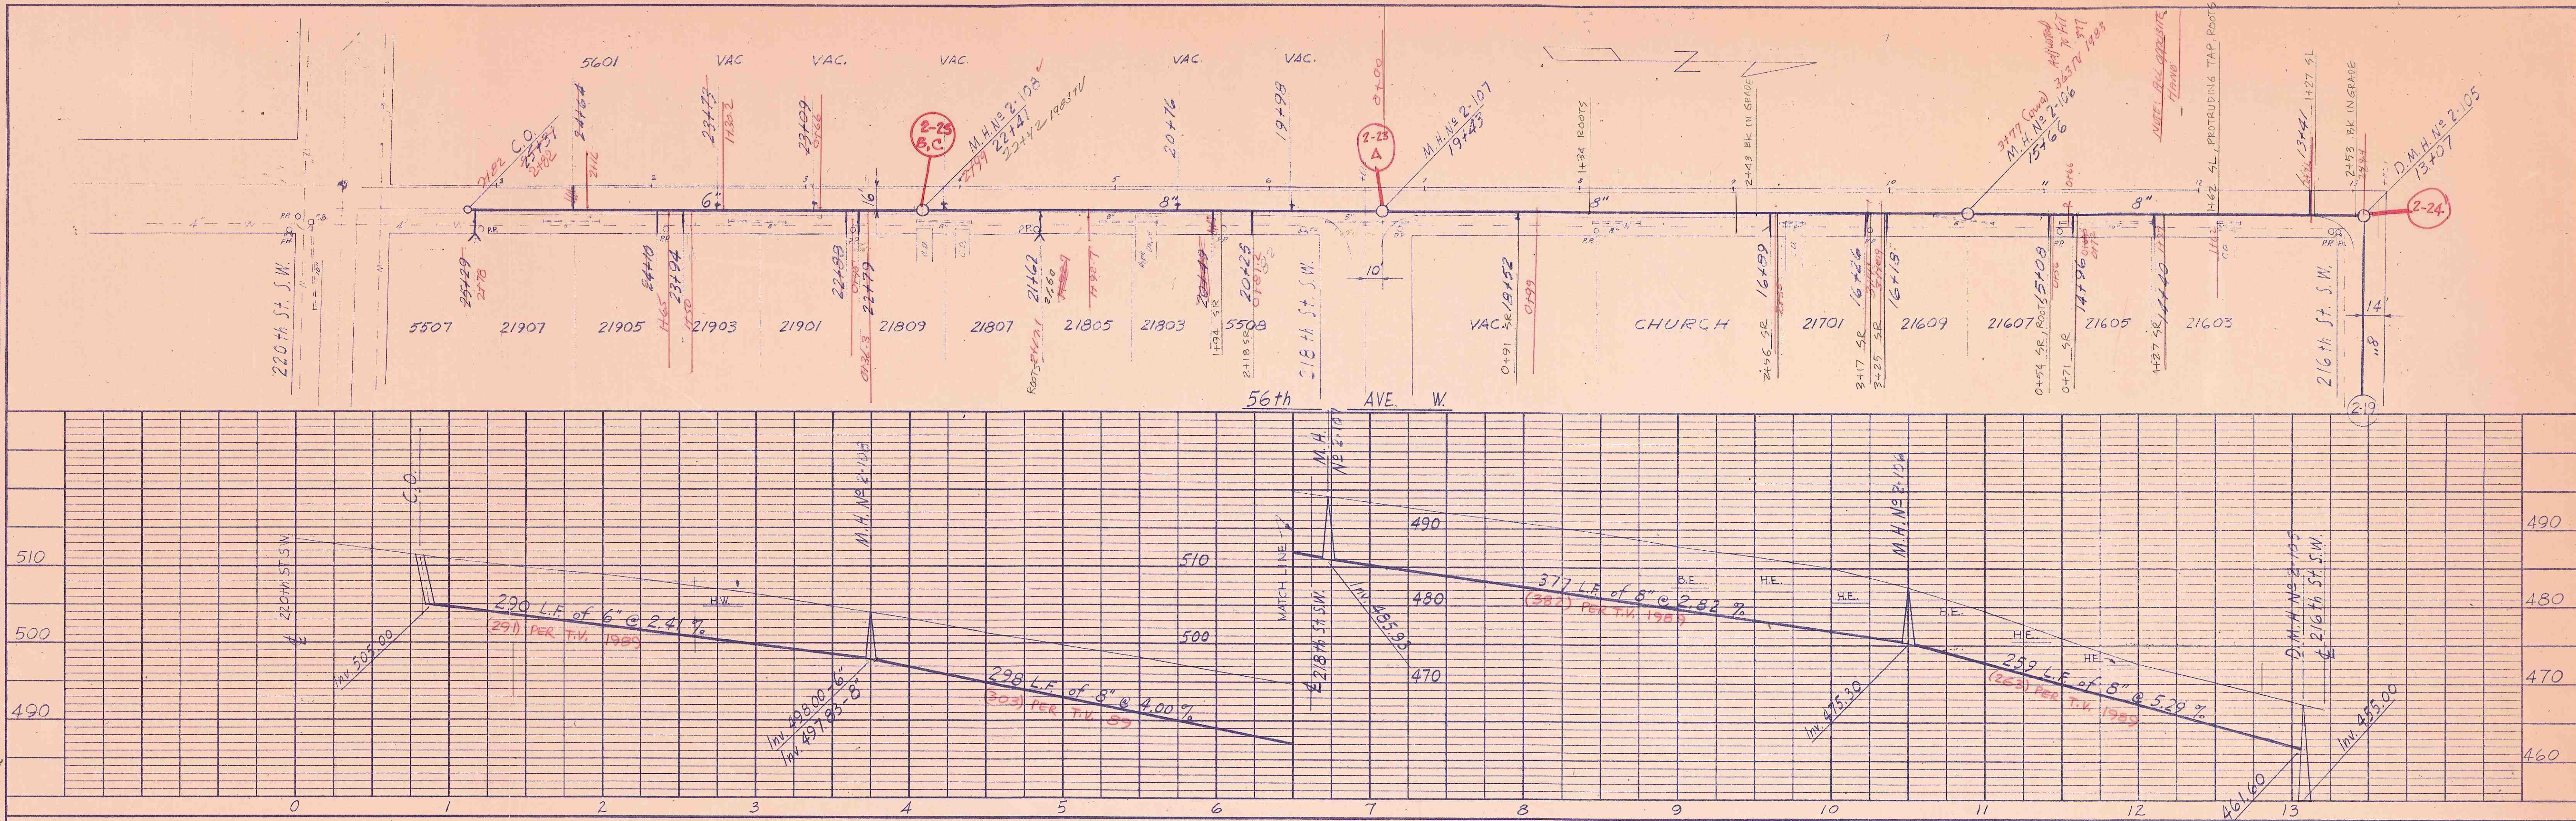

Scan Name: scans06338.pdf
Scan Date:

AS BUILT DRAWING

PLATE 2-PLAN-PROFILE-F.A.S.
CLEARPRINT PAPER CO., S.F. CAL.
No. 1000H2

JAMES H. REID & ASSOCIATES
CONSULTING ENGINEERS, 324 MAIN ST., EDMONDS, WASH.

DESIGN	DRAWN	CHECKED	DATE	H. SCALE 1"=50'	FILE NO. 5.50/2-23
LN.	HH:DP	LN.	3-30-59	V. SCALE 1"=10'	SHEET 23 OF 23
CITY OF MOUNTLAKE TERRACE SEWERAGE SYSTEM UNIT 2					