


PLAN	DATE
BY	
CHECKED	
NOTED	
NO.	

PROFILE	DATE
BY	
CHECKED	
NOTED	
NO.	

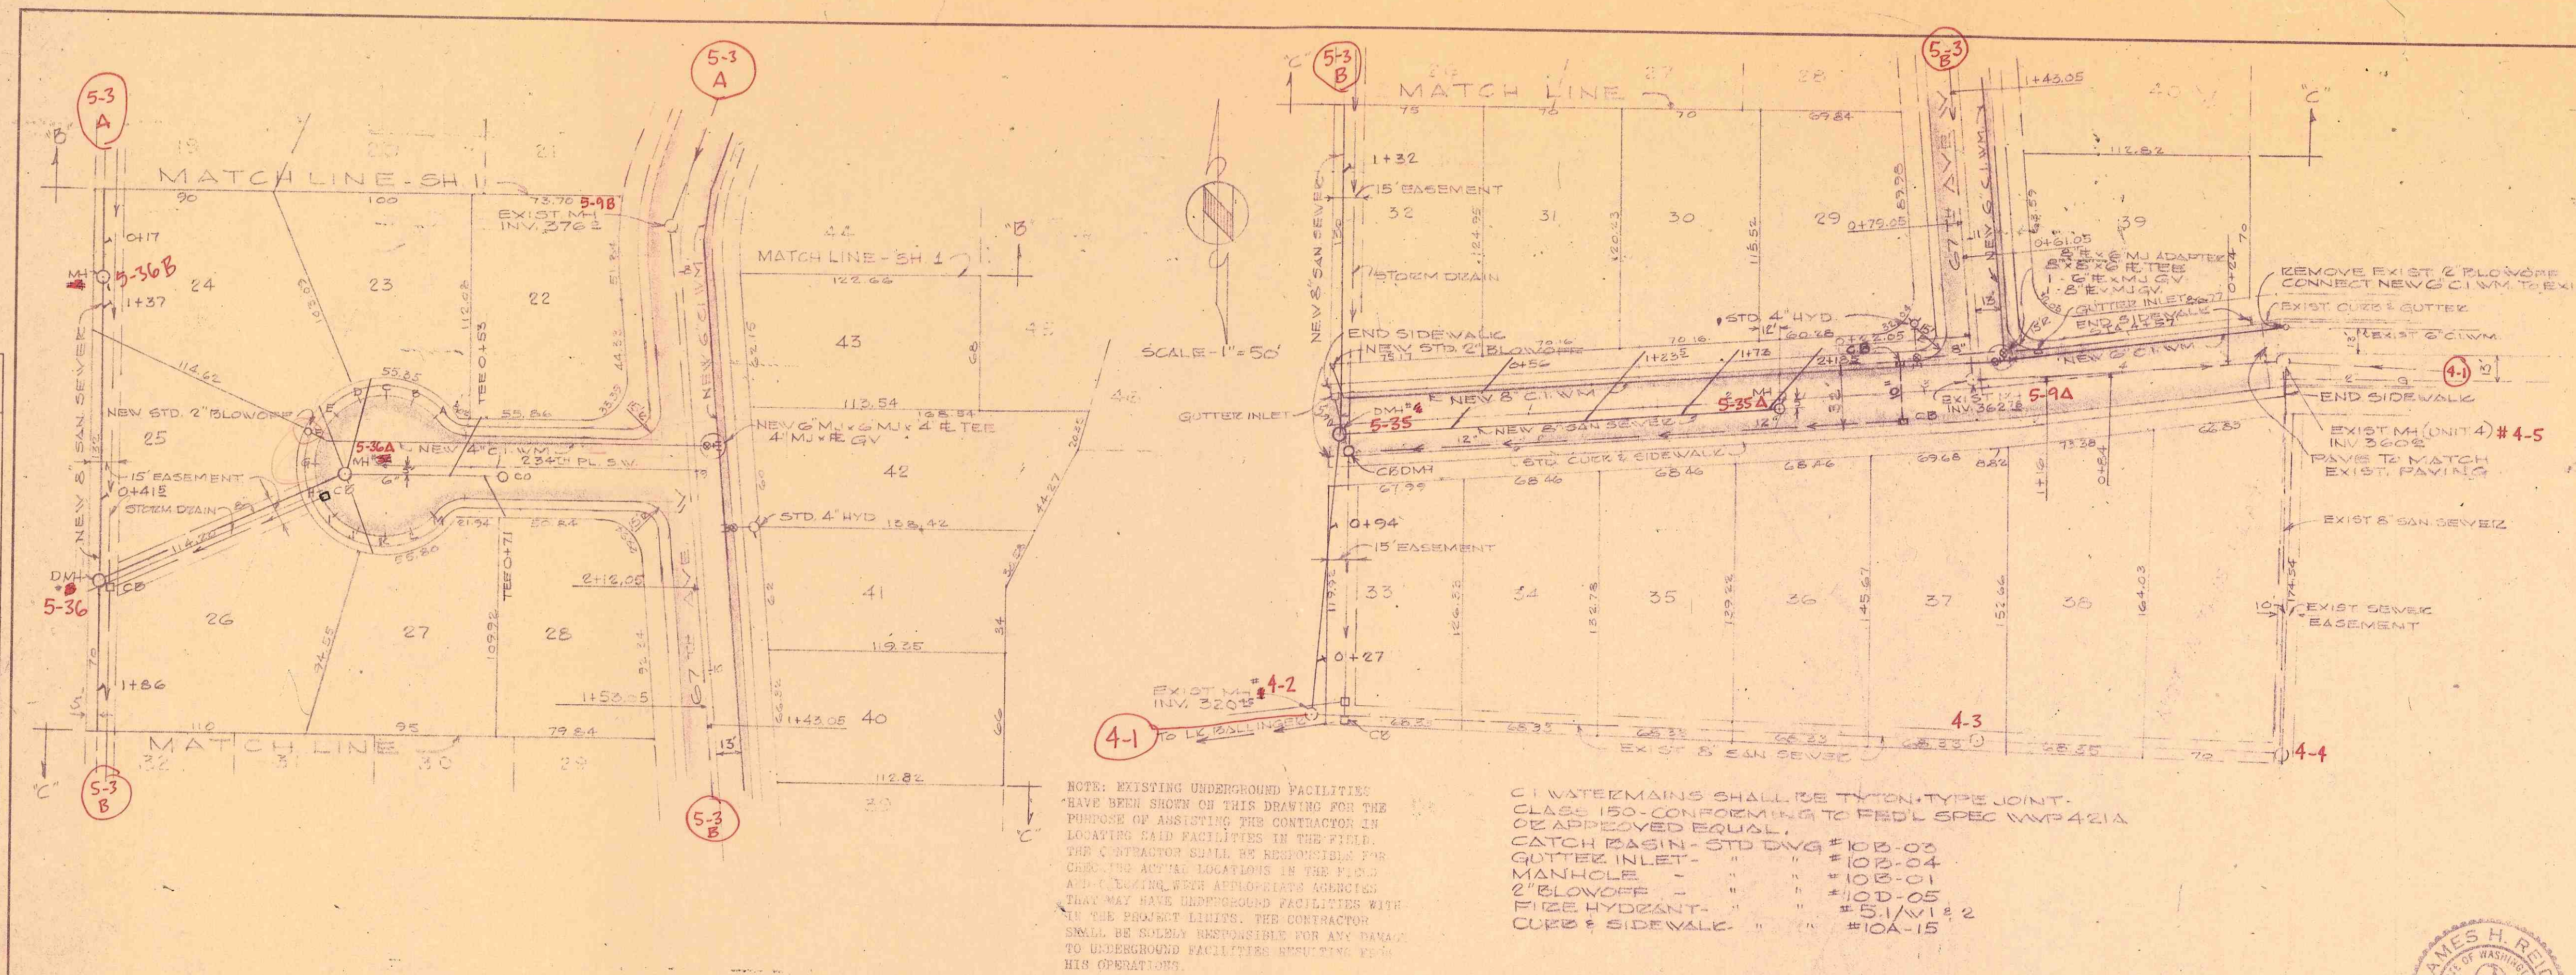

NOTE: EXISTING UNDERGROUND FACILITIES HAVE BEEN SHOWN ON THIS DRAWING FOR THE PURPOSE OF ASSISTING THE CONTRACTOR IN LOCATING SAID FACILITIES IN THE FIELD. THE CONTRACTOR SHALL BE RESPONSIBLE FOR CHECKING THE ACTUAL LOCATIONS IN THE FIELD AND FOR OBTAINING NECESSARY PERMITS FROM ANY AGENCIES THAT MAY HAVE JURISDICTION OVER THE PROJECT LIMITS. THE CONTRACTOR SHALL BE SOLELY RESPONSIBLE FOR ANY DAMAGE TO UNDERGROUND FACILITIES SUSTAINED BY HIS OPERATIONS.

- CITY WATERMAINS SHALL BE TYPE "ON" TYPE JOINT, CLASS 150, CONFORMING TO FED. SPEC. WWP 421A OR APPROVED EQUAL.
- CATCH BASIN - STD. DWG. #103-03
 - GUTTER INLET - " " #103-04
 - MANHOLE - " " #103-01
 - 2" BLOWOFF - " " #103-05
 - PIPE HYDRANT - " " #51-W1-2
 - CURB & SIDEWALK - " " #10A-15

NOTE: FINAL PROFILES FOR SEWER LINES CONNECTING TO MAIN SEWER ON WEST PROPERTY LINE TO BE DETERMINED AFTER GRADING OF CUL DE SACS.



1	ADDED PROFILE 234TH PL. SW. SEWER LATERALS	3/12/63	RE
NO.	REVISIONS	DATE	BY
CITY OF MOUNTLAKE TERRACE			
CURBS, SIDEWALKS, & STREET PAVING			
4" C & S C.I. WATERMAINS, STORM DRAIN, & SANITARY SEWERS			
234TH PL. SW. & 235TH ST. SW.			
BALLINGER TERRACE, DIV. 3			
REID, MIDDLETON & ASSOCIATES, INC.			
CONSULTING ENGINEERS & LAND SURVEYORS			
324 MAIN STREET EDMONDS, WASHINGTON			
FILE NO.	5.213		
SHEET	2 OF 2		

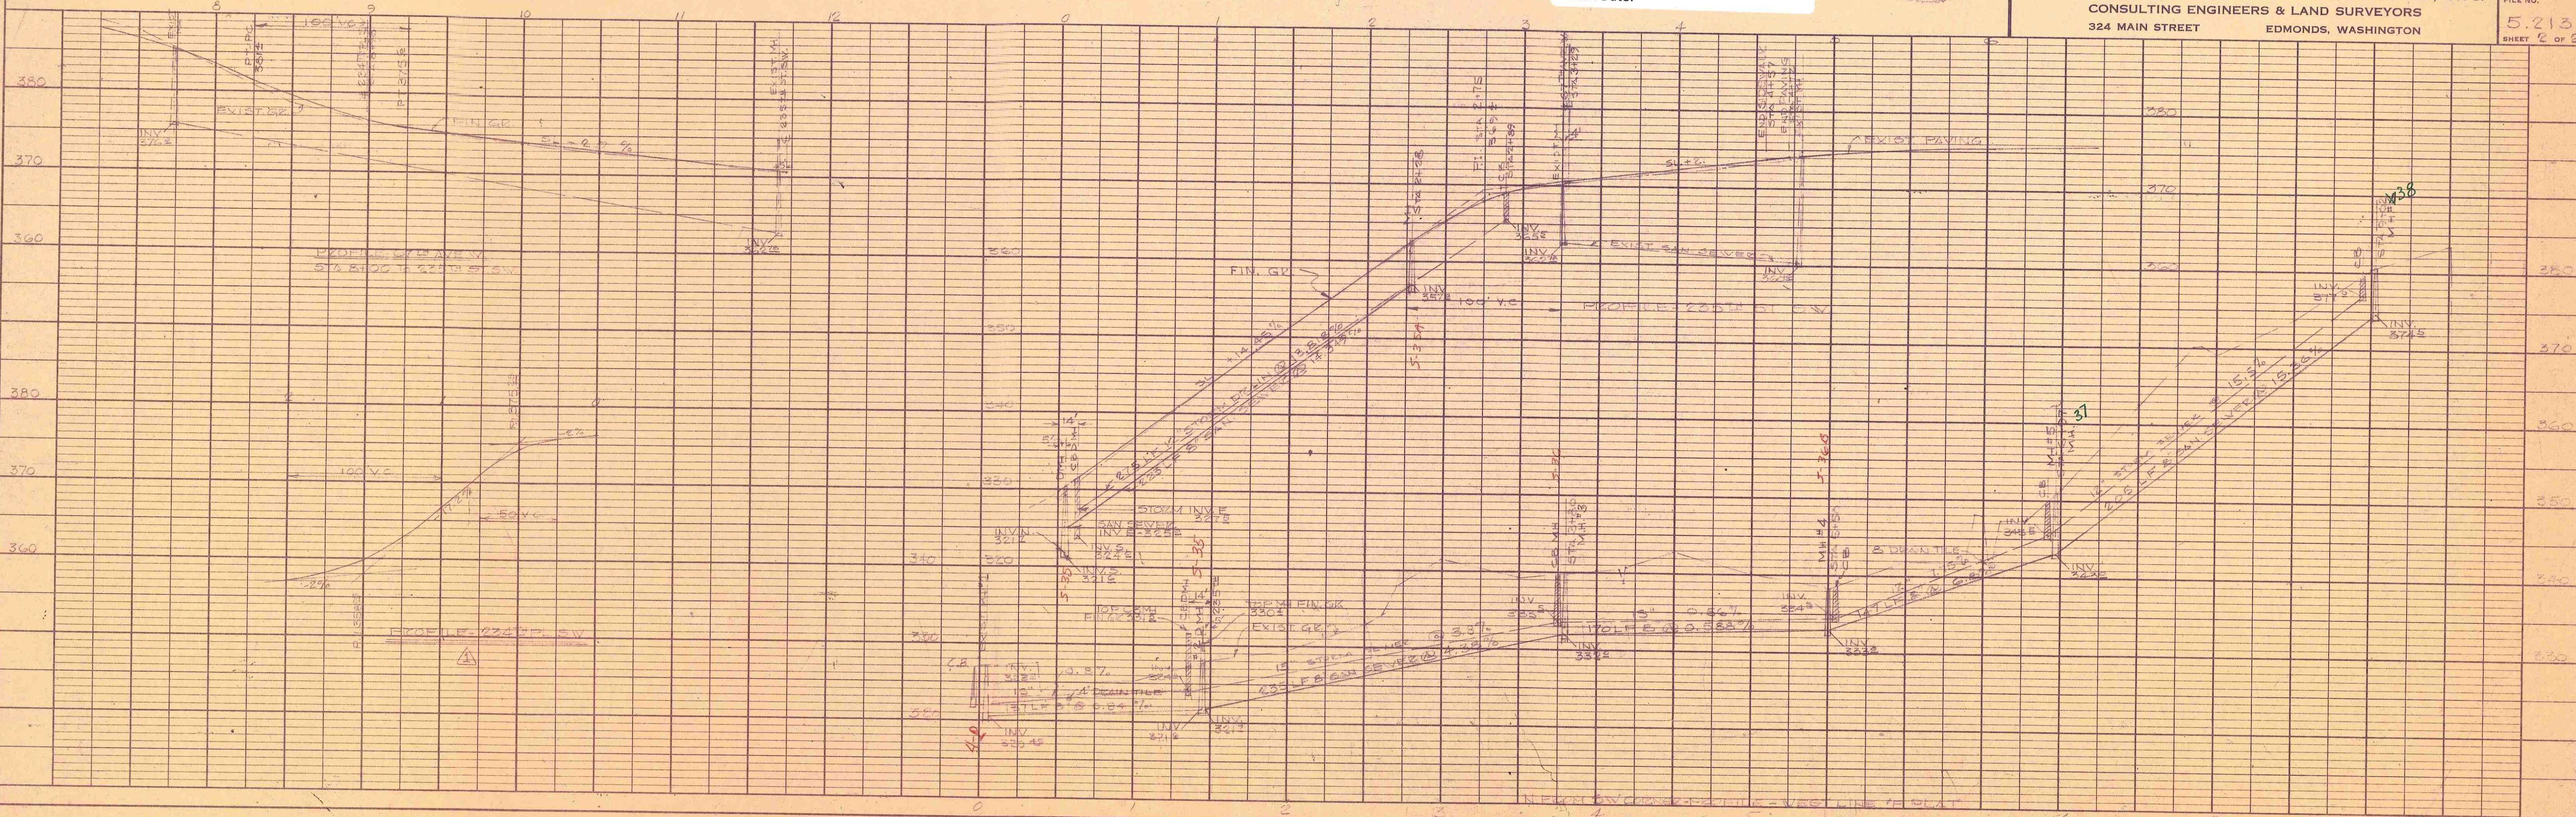


PLATE 1-PLAN-PROFILE D.P.R. & R.E. STANDARD
100% AGEPROOF VELLUM - MADE AND PRINTED IN U.S.A.
EUGENE, DIETZEN CO.

(SEWERS) AS BUILT DRAWING

5-3-B