


N



E-27

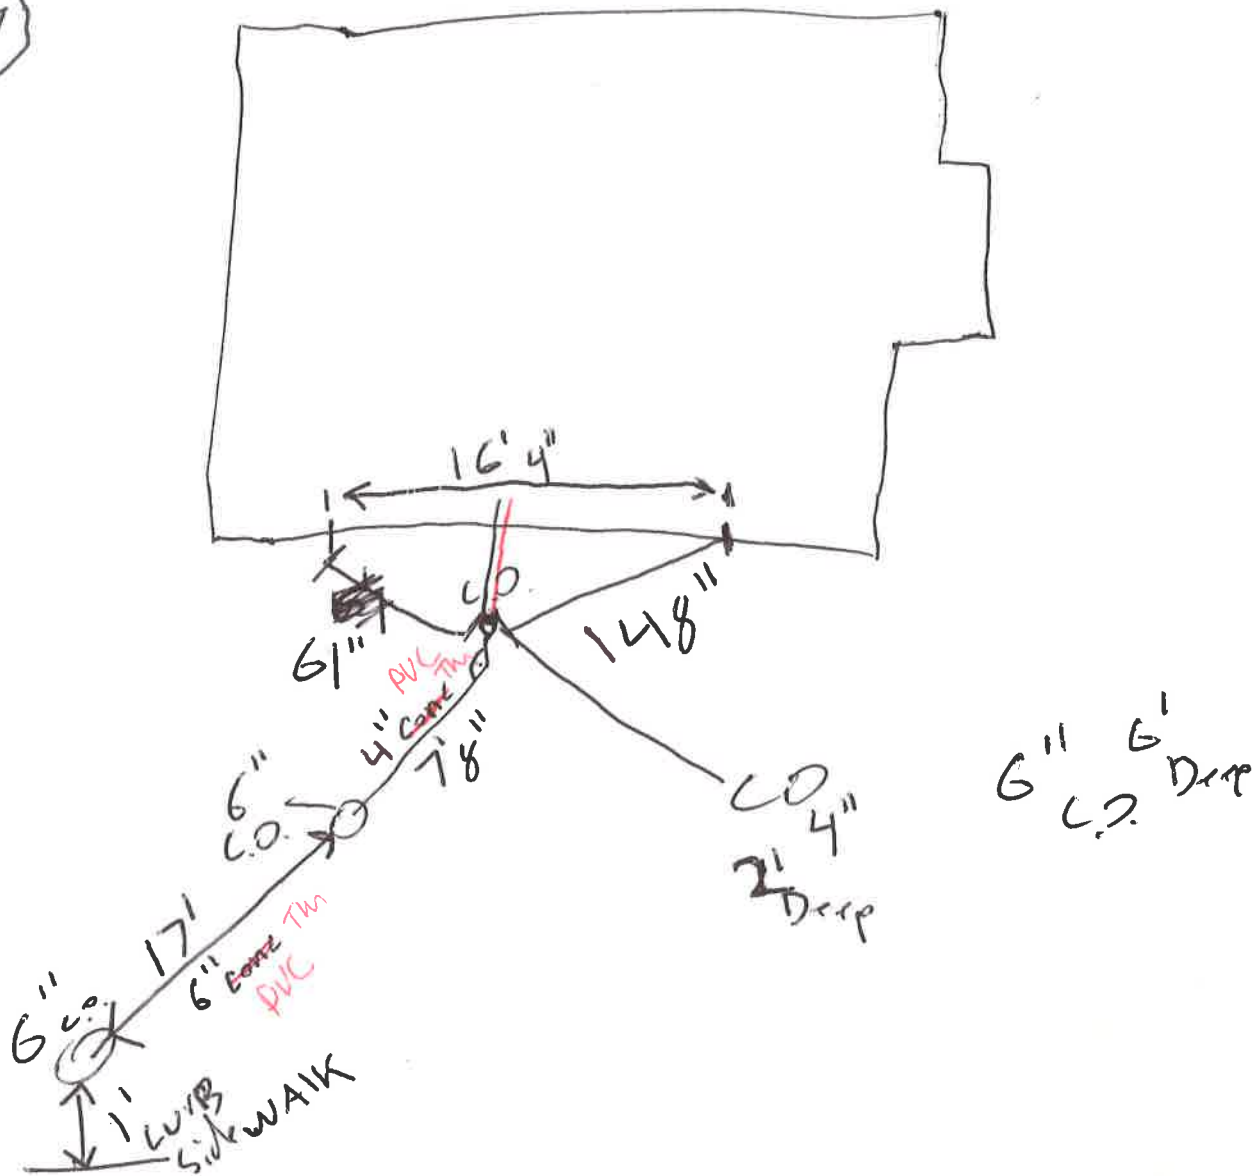

OWNER:

ADDRESS: 21317-48<sup>th</sup> Ave W Bld E #27

DATE: 1/25/18

PERMIT #: U-18-0018

Inspector's Signature: *James A. Moelrich*

## SIDE SEWER DRAWING

1. Drawing must be clearly labeled (streets, north arrow).
2. Indicate location of all piping, cleanouts, manholes or other fixed features.
3. Dimension pipe length and distance from other features.
4. Label diameter, bends, material type of pipe and depth at cleanouts.



CALL BEFORE YOU DIG:  
1-800-424-5555 (or 811)