

The City of Mountlake Terrace

APPLI ION

for

SIDE SEWER PERMIT

OUTSIDE ☐ INSIDE ☐ REPAIRS ☐


CARD No.

BASEMENT No. 1378676

OWNER Pruman Helms CONTRACTOR Kenmore Const Co. PERMIT No. 1510

HOUSE No. 23912 W. 59th STREET 21 AVENUE LOT No. 21 BLOCK No. 21

NAME ADD.

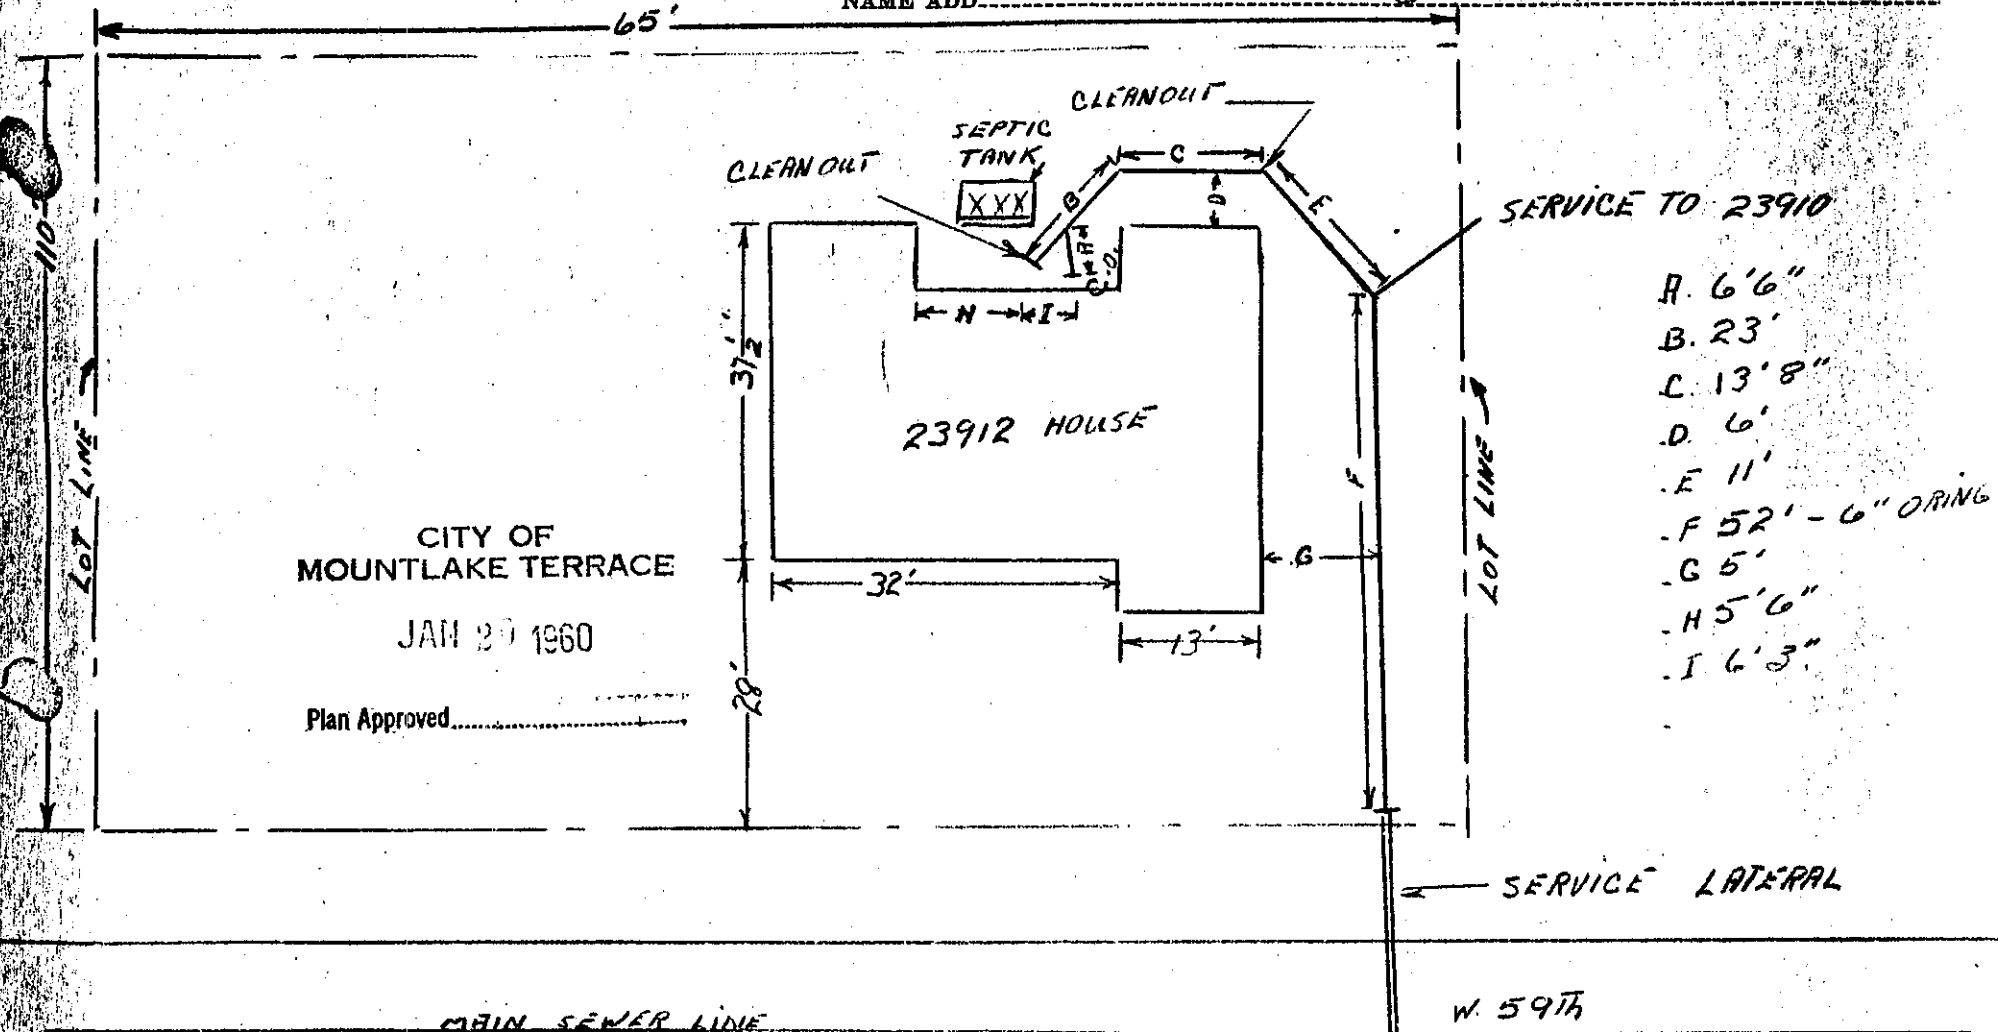

CITY OF
MOUNTLAKE TERRACE

JAN 20 1960

Plan Approved

SERVICE TO 23910

A. 6'6"
B. 23'
C. 13'8"
D. 6'
E. 11'
F. 52' - 6" ORING
G. 5'
H. 5'6"
I. 6'3"

SERVICE LATERAL

W. 59th

MAIN SEWER LINE

Date

Approved:

BACKFILL WORK ORDER ISSUED

DEPOSIT, \$ 10.00

SEWER WORK ORDER ISSUED

Rec # 5794
1-18-60

DATE 1-20-60

BY Scott M. Holton INS+CON