

11MBERLINE PARK
DEAN E. HELBARGER - DEVELOPER

The City of Mountlake Terrace

APPLICATION

CARD No. _____

SIDE SEWER PERMIT


OUTSIDE ☒ INSIDE ☐ REPAIRS ☐

EASEMENT No. _____

OWNER _____ CONTRACTOR UNIVERSAL LITL. CONT.
EDMONDS, ALASKA PERMIT No. 74-14
HOUSE No. 3603 - 225 TH PL SW STREET SIDE SEWER TO LOT LINE 1974 4-41-75
AVENUE LOT No. 30 BLOCK No. _____

NAME ADD

Side Sewer Permit No u-41-75 issued to Lynnwood Septic Tank Co.
5/16/75. Sewer installed, inspected, accepted and asbilt made
5/16/75 by F H Smith. *F H Smith*

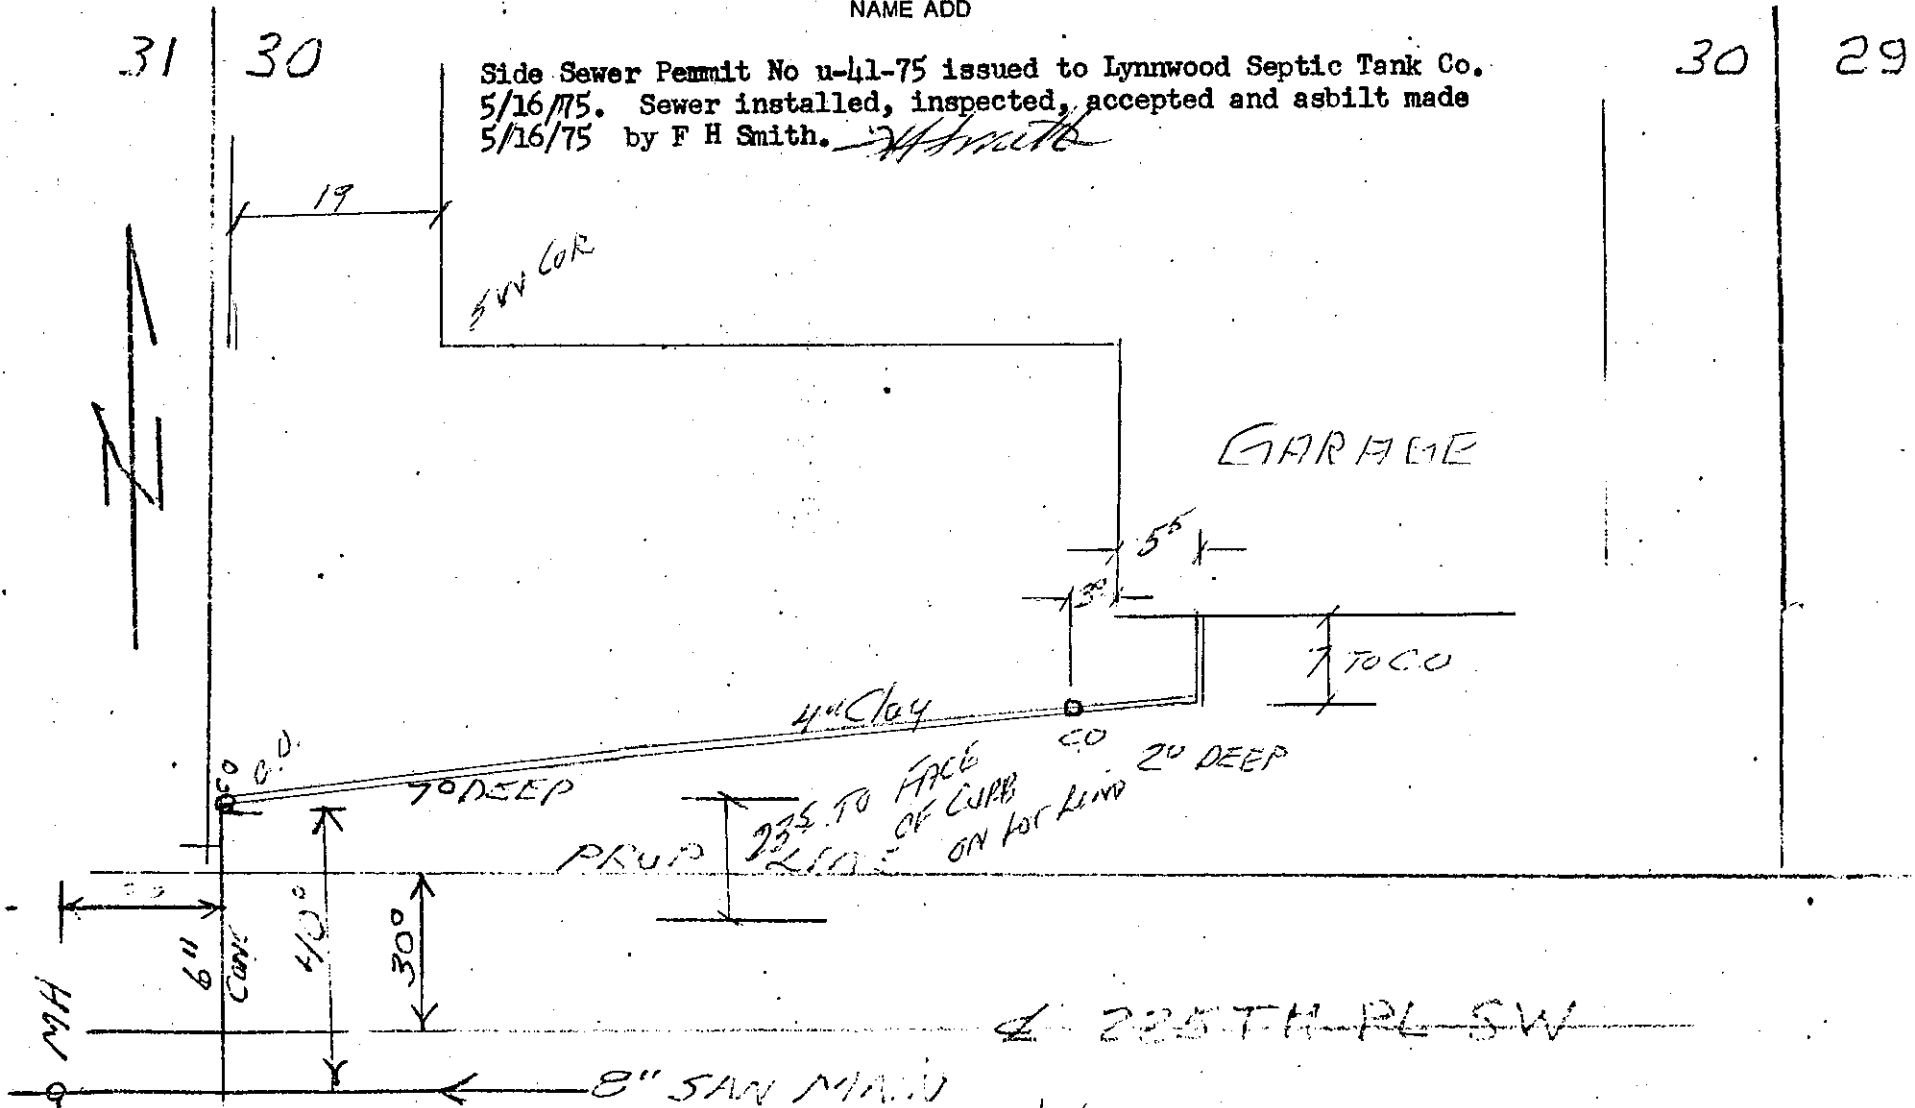

BACKFILL WORK ORDER ISSUED

Date 7-7-74

DEPOSIT, \$

10.00 5/16/75

Approved:

DATE 8-74

BY

F.H. SMITH

SEWER WORK ORDER ISSUED 4-15-74