

APPLICATION

for

SIDE SEWER PERMIT

OUTSIDE ☐ INSIDE ☐ REPAIRS ☐

CARD No. _____

EASEMENT No. _____


The City of Mountlake Terrace

H & H HOMES

OWNER _____ CONTRACTOR Lynnwood Septic Tank PERMIT No. U-44-75

HOUSE No. 6703 224th St SW STREET _____ AVENUE LOT No. 11 Greenridge BLOCK No. _____

NAME ADD _____

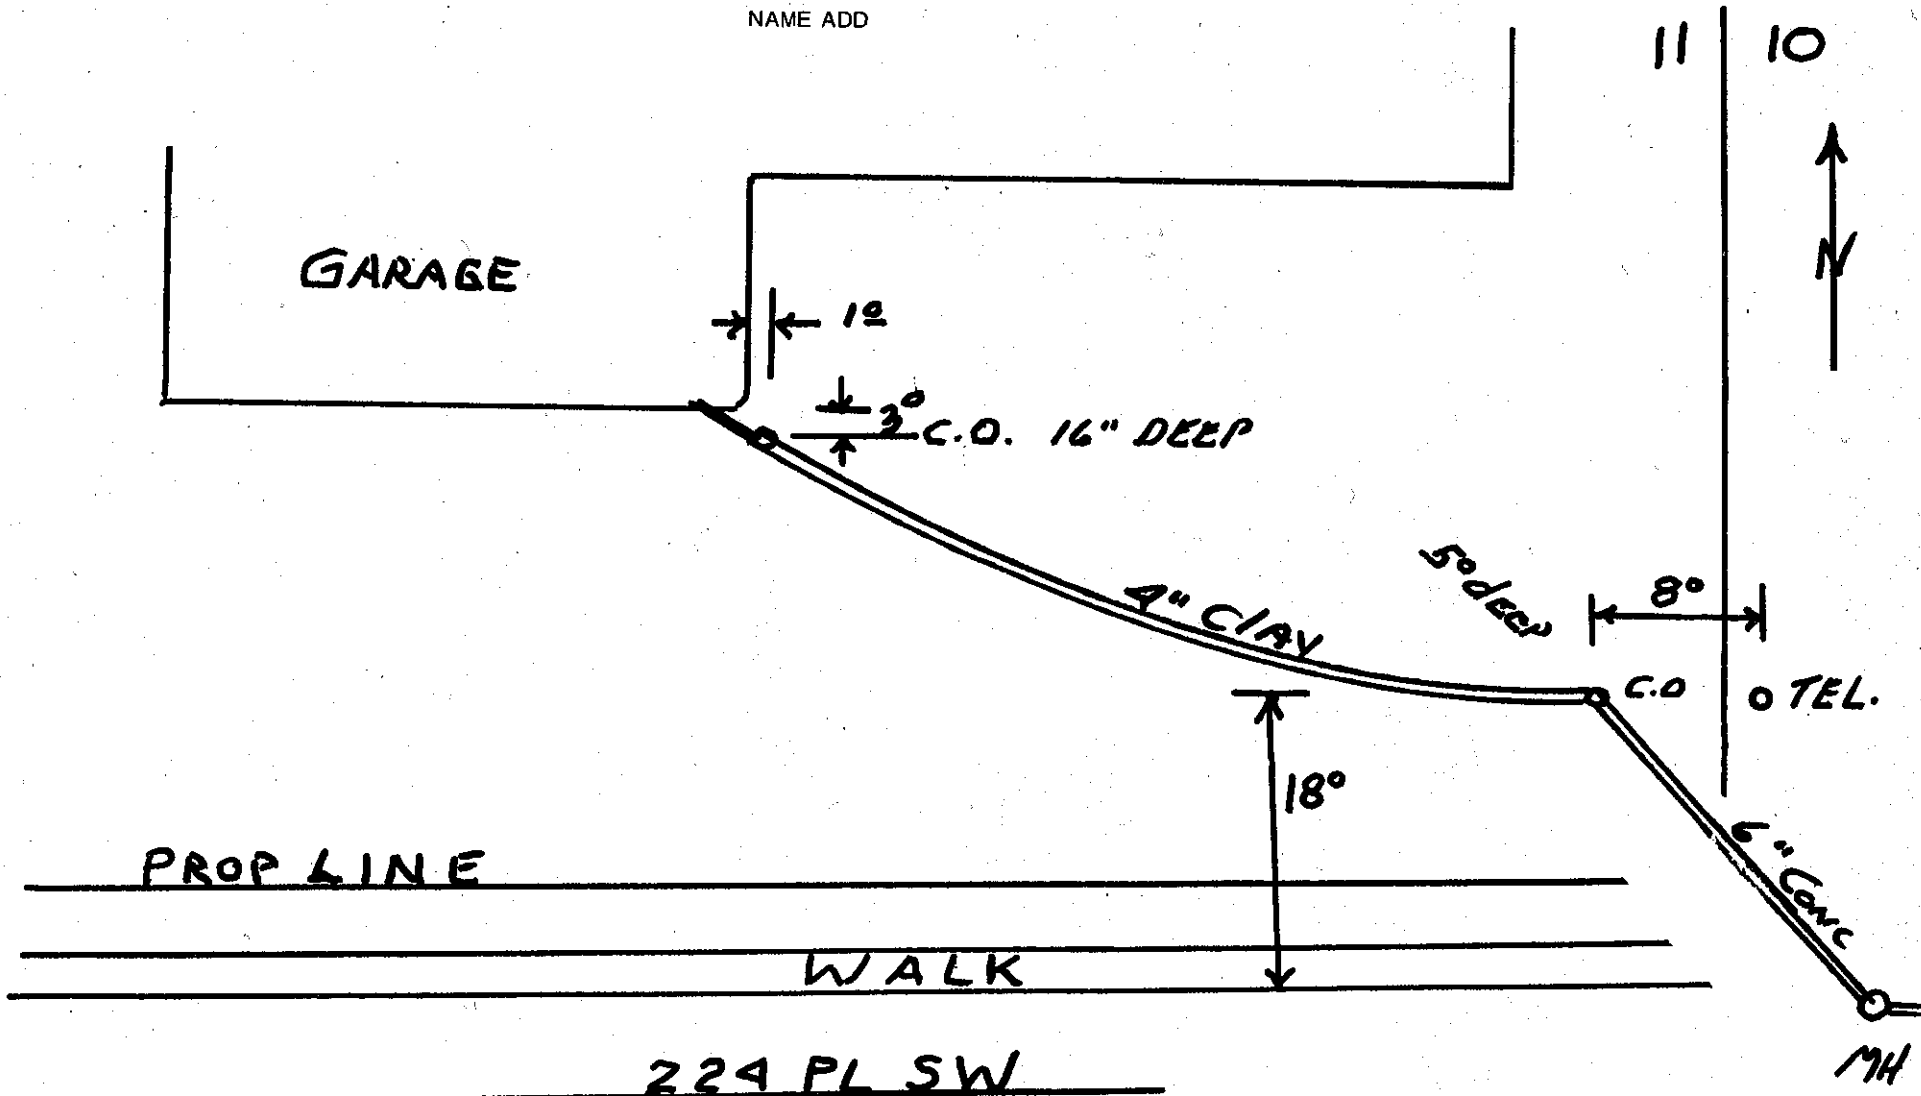

BACKFILL WORK ORDER ISSUED 6-11-75 DEPOSIT, \$ 10 DATE 6-11-75 BY John H. Smith