

APPLI ION

The City of Mountlake Terrace

SIDE SEWER PERMIT

CARD No.

OUTSIDE ☐ INSIDE ☐ REPAIRS ☐

EASEMENT No.

OWNER

Harry Haugen

CONTRACTOR

Lynnwood Septic Tank Co.

PERMIT No.

4081

HOUSE No.

21405-56W

STREET


AVENUE LOT No.

13

BLOCK No.

NAME ADD

Hillwood park #10

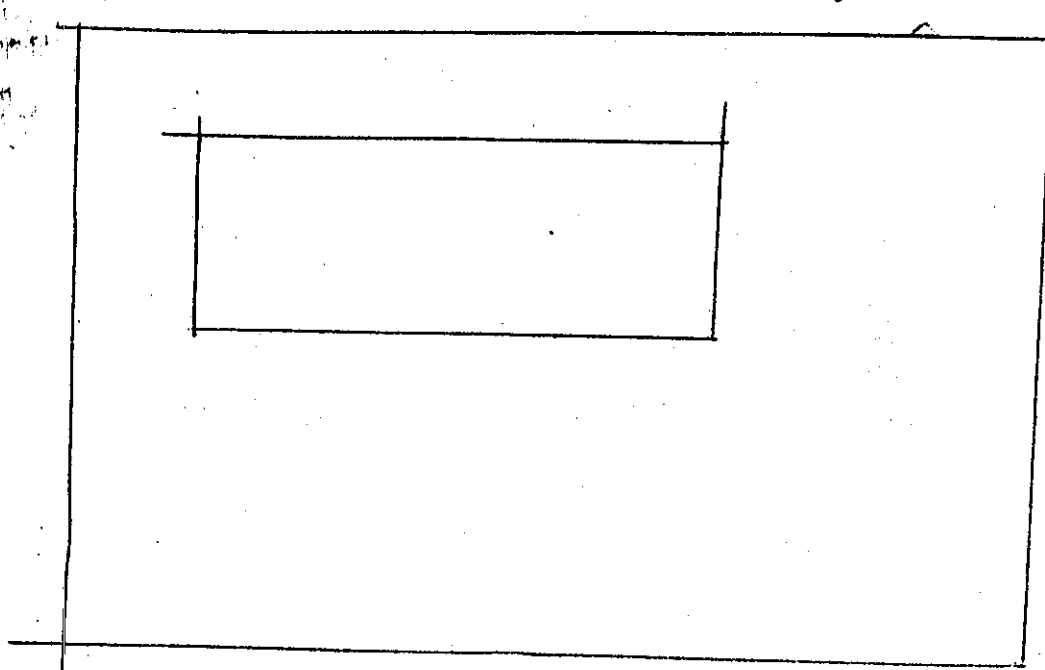

BACKFILL WORK ORDER ISSUED

Date

DEPOSIT, \$

16.00

Approved:

C.B.O. 7/19/60

SEWER WORK ORDER ISSUED

DATE

BY