

# APPLICATION

for

CARD No. \_\_\_\_\_

The City of Mountlake Terrace

SIDE SEWER PERMIT

OUTSIDE ☐ INSIDE ☐ REPAIRS ☐

EASEMENT No. \_\_\_\_\_

OWNER Jim Hollostet

CONTRACTOR North End Septic Tank

PERMIT No. \_\_\_\_\_


HOUSE No. 22311-39 Ave W.

STREET

AVENUE LOT No. 2

BLOCK No. B

NAME ADD Cedar Grove

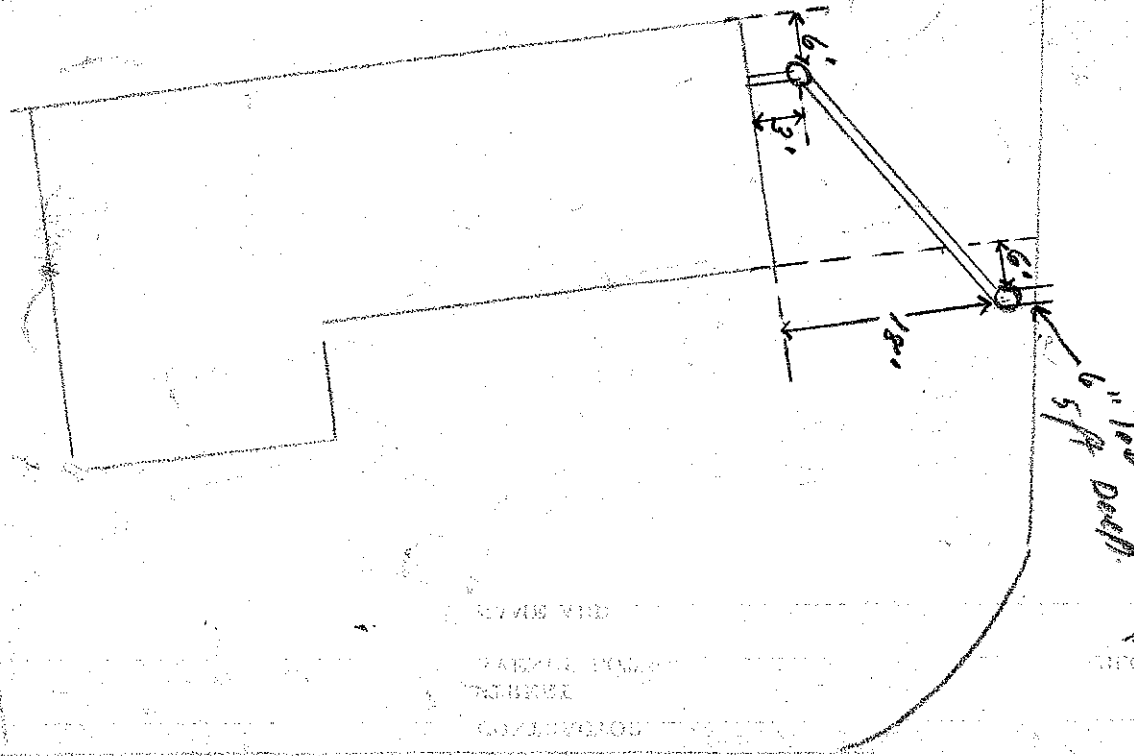

Date \_\_\_\_\_

Approved: ☐

BACKFILL WORK ORDER ISSUED \_\_\_\_\_

DEPOSIT, \$ \_\_\_\_\_

SEWER WORK ORDER ISSUED \_\_\_\_\_

DATE \_\_\_\_\_

BY \_\_\_\_\_

APPLICATION