

TIMBERLINE PARK  
DEAN ECHELBARGER ~ DEVELOPER

The City of Mountlake Terrace

APPLICATION

for

SIDE SEWER PERMIT

OUTSIDE ☒ INSIDE ☐ REPAIRS ☐

EQUIP WITH BACKFLOW VALVE

CARD No. \_\_\_\_\_

EASEMENT No. \_\_\_\_\_


OWNER \_\_\_\_\_ CONTRACTOR UNIVERSAL LIT L CO INC

HOUSE No. 3704 - 225 TH PL SW STREET EDMONDS BLVD PERMIT No. 74-14  
AVENUE LOT No. 1 BLOCK No. 1974

NAME ADD

225 TH PL SW

Side Sewer Permit No U 57 75 issued 7-28-75 to Lynnwood Septic Tank Co.  
Installed and inspected and asbilt made 8/26/75 FHS *[Signature]*

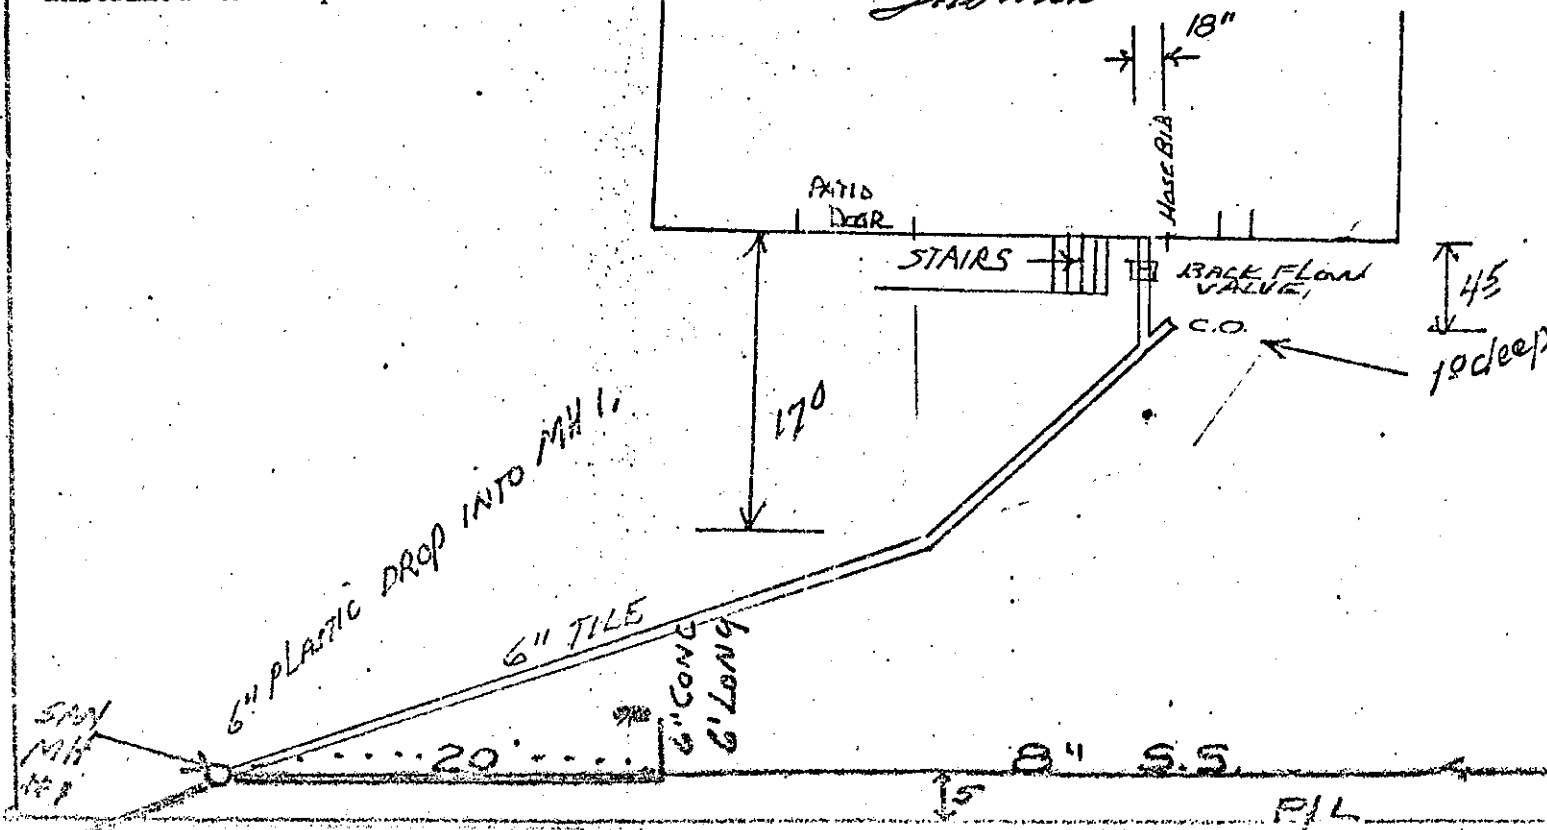

Approved: \_\_\_\_\_