

APPLICATION

for

SIDE SEWER PERMIT

OUTSIDE ☒ INSIDE ☐ REPAIRS ☐

CARD No. _____

EASEMENT No. _____

The City of Mountlake Terrace

OWNER D. L. Hallenrath

CONTRACTOR _____

PERMIT No. 3759


HOUSE No. 31510-54 PL. W.

STREET

AVENUE LOT No. 11

BLOCK No. _____

NAME ADD. MLT DIV # 32

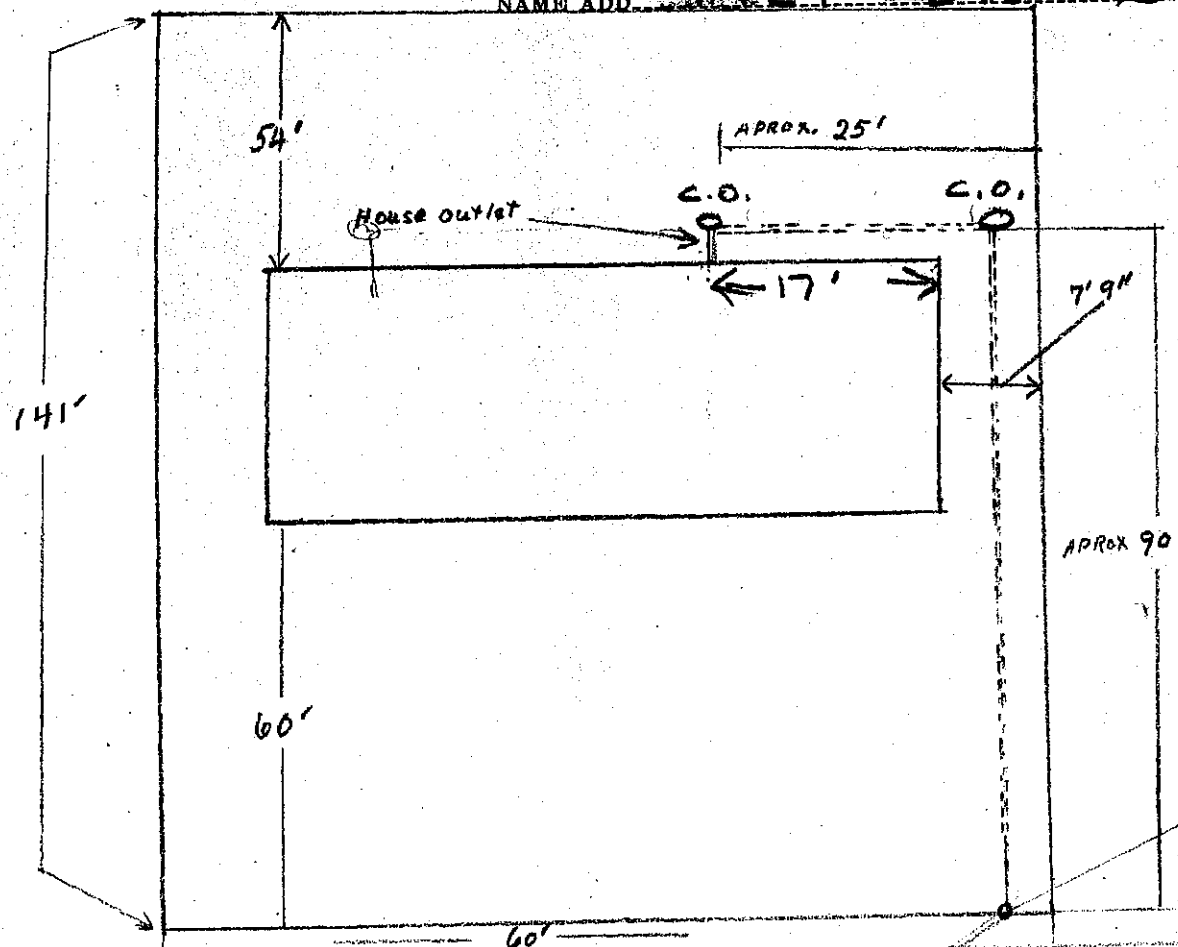

54 PL. W. STREET

SEWER MAIN

NORTH →

Approved: _____

DATE 4-29-64 BY [Signature]

BACKFILL WORK ORDER ISSUED _____

DEPOSIT, \$ _____

SEWER WORK ORDER ISSUED _____