


44TH AVE. W.

OWNER: SCHNEIDER HOMES
 ADDRESS: 4316 216TH ST. S.W.
 CONTRACTOR: SCHNEIDER HOMES
 PERMIT NO.: U-96-022
 ISSUE DATE:
 INSPECTED BY: GAR
 INSPECTION DATE: 7/22/96

216TH ST. S.W.

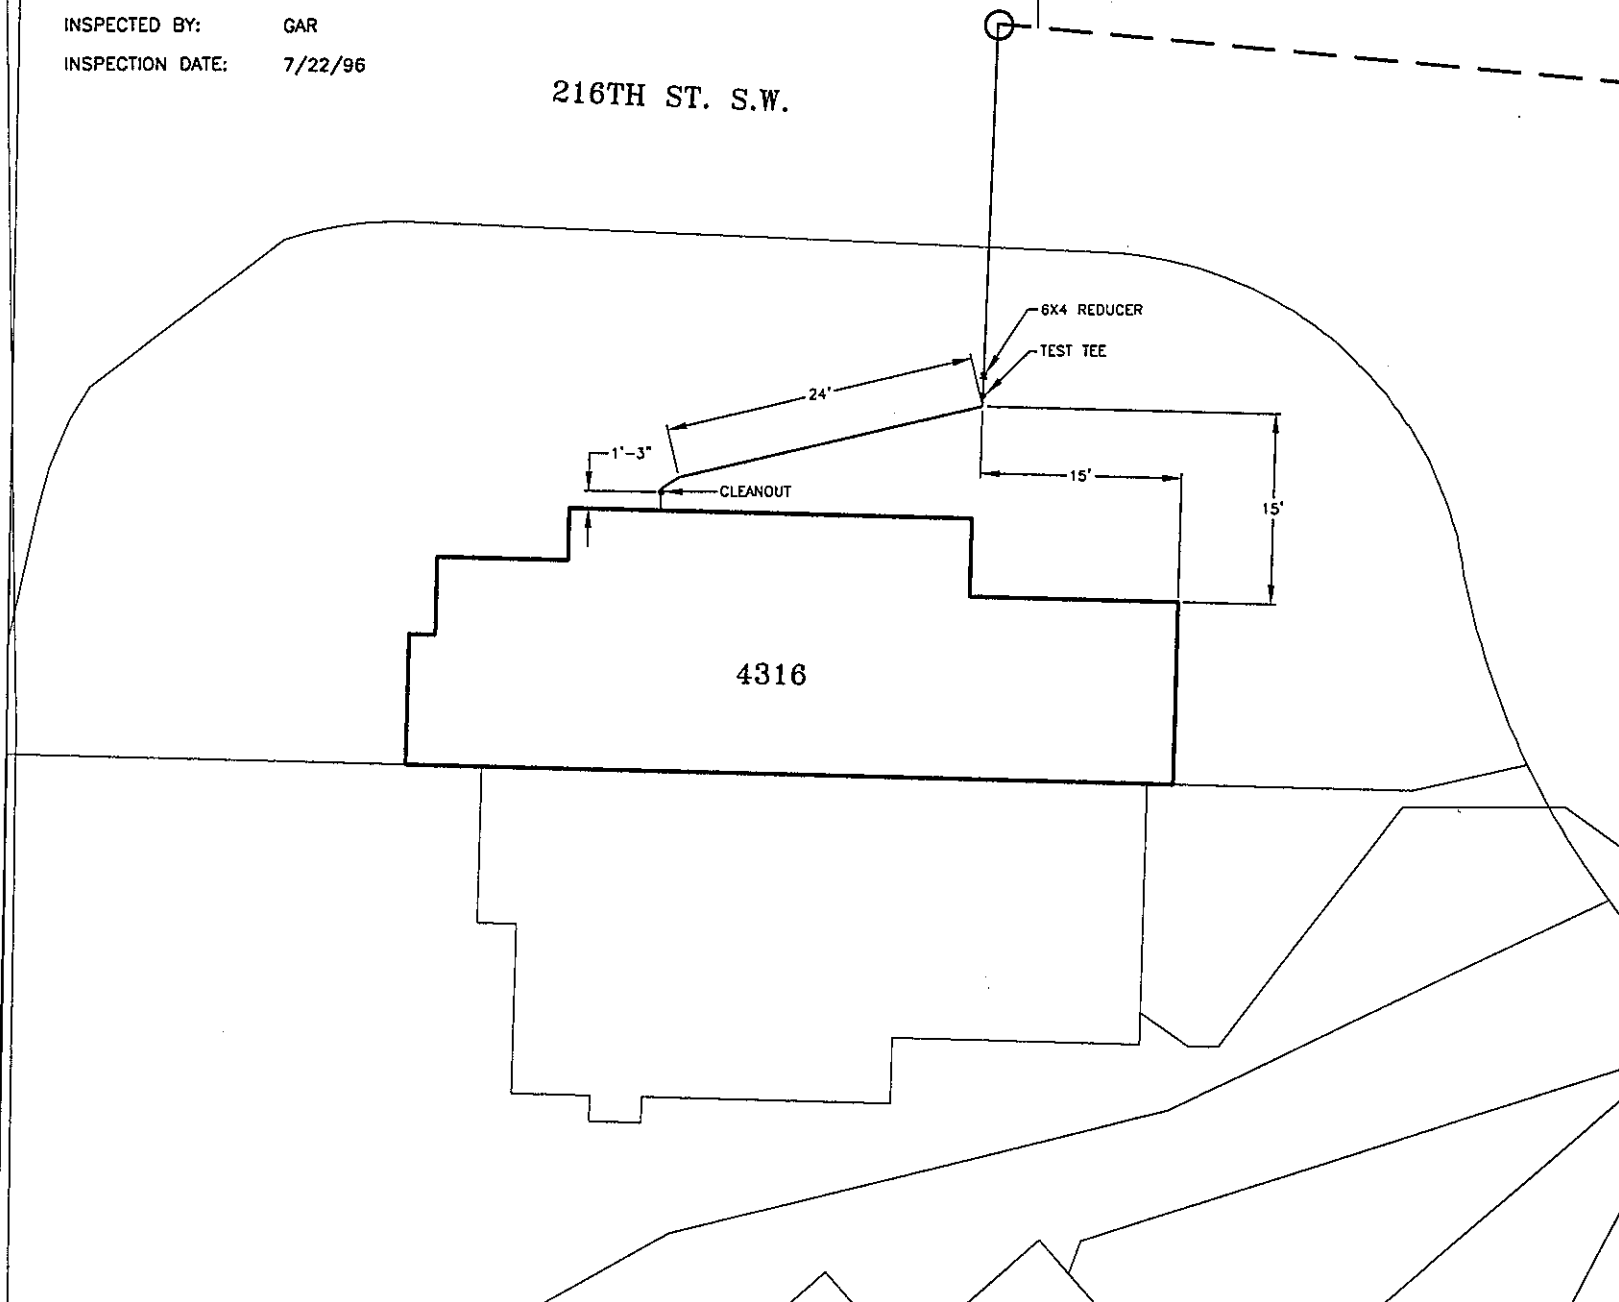

4316

CITY OF MOUNTLAKE TERRACE
 SEWER AS-BUILTS

SIDE SEWER AS-BUILT

ENGINEERING DEPARTMENT
 CITY OF MOUNTLAKE TERRACE
 3100 15TH AVE. S.W.
 MOUNTAIN VIEW, WA 98043
 (206) 778-1181
 FAX (206) 778-8421



DATE:

APPROVED BY:

DESIGNED BY: DWM/ST

DATE:

CHECKED BY:

DATE:

PROJECT ENGINEER:

DESCRIPTION:

FILE NAME:

FILE PATH:

FILE NAME:

FILE PATH: