


DATE	BY	SURVEYED	PLOTTED	GRADES CHECKED	B. M. NOTED	STRUCTURE NOTATIONS CH'KD.	NO.
			13-34-36				10

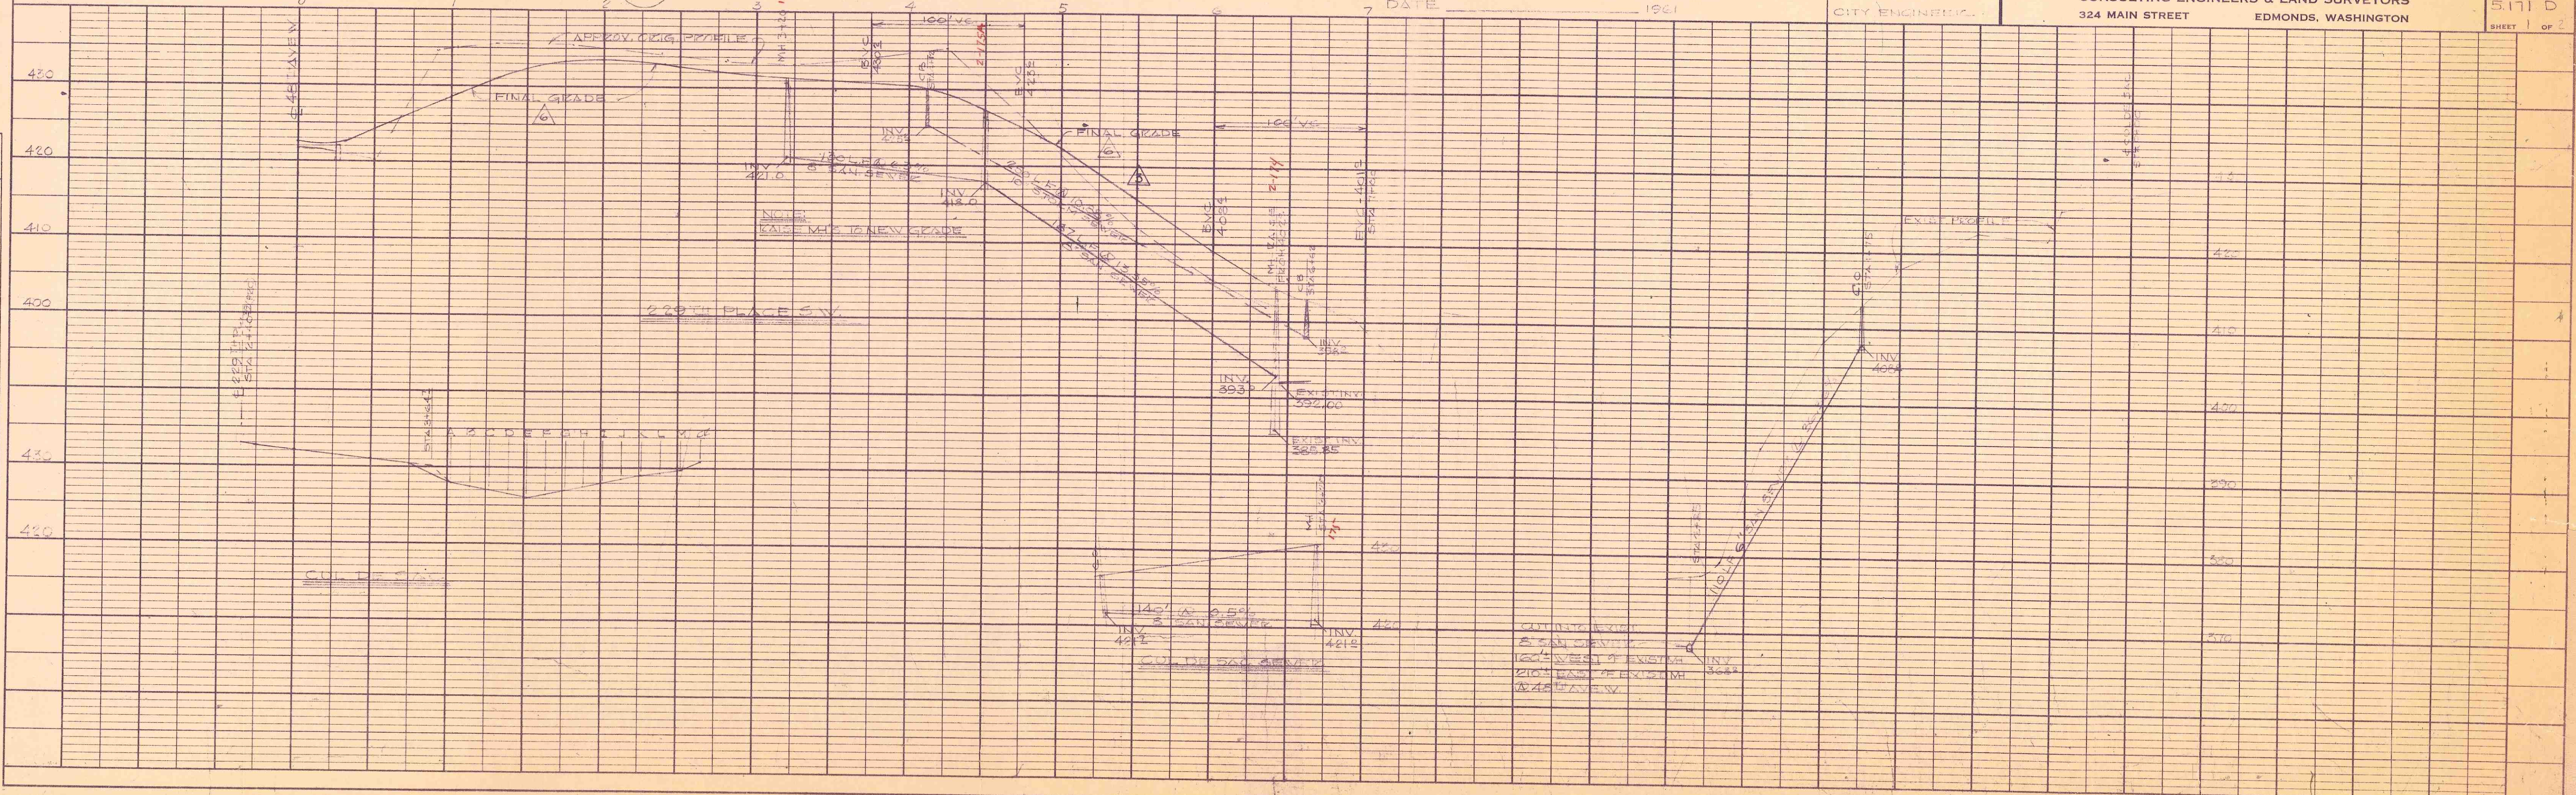

Scan Name: scans06297.pdf
Scan Date:

6	ADDED FIN GLE 29 TO ELV. & COLDTS SAC	7/26/61	th
5	CHZED RADING OF COLDRA. CHANGED TO 31'	7/21/61	th
4	ADDED LOCATION OF SEVLT GAS MAINS	6/10/61	th
3	CHZED FIN GLE & STORM SEWER	6/14/61	th
2	RECORDED & RELOCATED SYSTEM, SAN SEWER & L ^{TS} 10 FT	6/5/61	th
1	ADDED STORM SEWER PROFILE & C.B.	4/25/61	th
NO.	REVISIONS	DATE	BY
CITY & MOUNTAIN TRAIL & C.E.		SCALE AS NOTED	
CURBS & PAVING		DATE 4/12/61	
6" x 4" OF WATER MAINS		DESIGN E.L.C.	
8" CANTARY SEWER &		DRAWN	th
STORM SEWER		CHECKED	th
WOODLAK DIV. & DIVISION #2		FB 2	
REID, MIDDLETON & ASSOCIATES, INC.		FILE NO.	5171 D
CONSULTING ENGINEERS & LAND SURVEYORS			
324 MAIN STREET			
EDMONDS, WASHINGTON			
		SHEET	1

PLATE 1-PLAN-PROFILE O. P. R. & R. E. STANDARD
100% AGEPROOF VELLUM—MADE AND PRINTED IN U. S. A.
EUGENE DIETZEN CO.

AS BUILT DRAWING

5.171 D.

2-10-F