

APPLICATION

for

SIDE SEWER PERMIT

CARD No. _____

The City of Mountlake Terrace



OUTSIDE ☐ INSIDE ☐ REPAIRS ☐

EASEMENT No. _____

OWNER Harry Hanger CONTRACTOR Lynnwood Septic Tank Co. PERMIT No. 4082

HOUSE No. 5506 - 2145 W STREET 14 AVENUE LOT No. 14 BLOCK No. _____

NAME ADD. Hillwood park #10

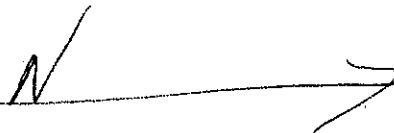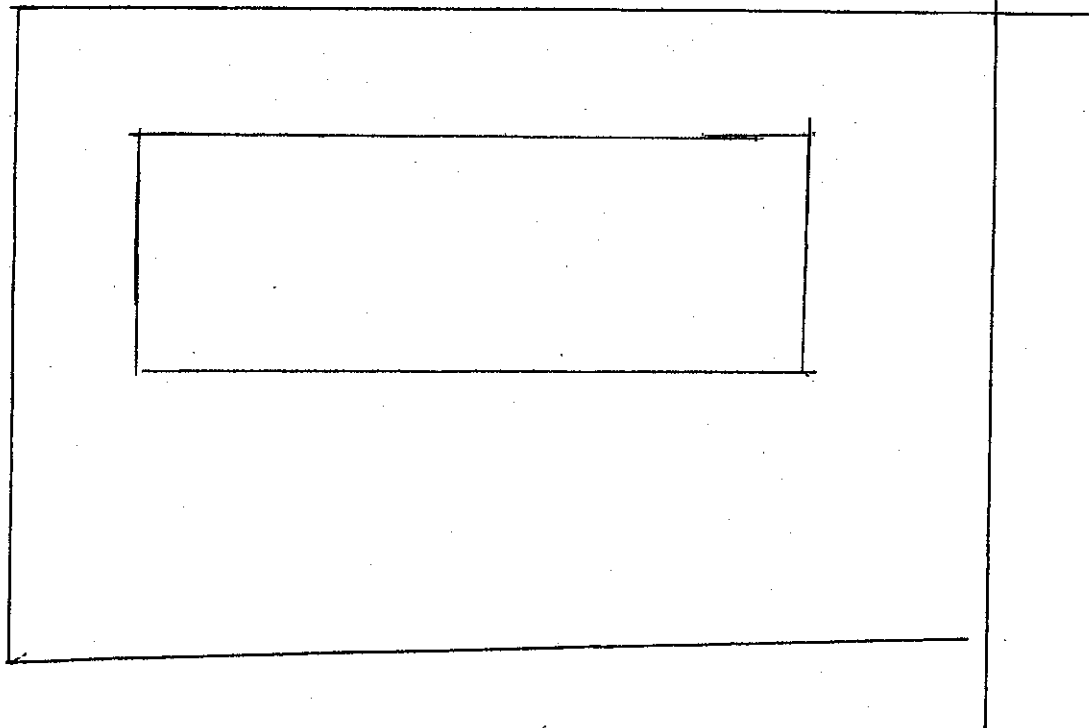

Date

BACKFILL WORK ORDER ISSUED _____ DEPOSIT, \$ 10.00

SEWER WORK ORDER ISSUED _____

Approved: RBQ 7/12/66

DATE _____ BY _____