

# APPLICATION

for

CARD No. \_\_\_\_\_

The City of Mountlake Terrace

SIDE SEWER PERMIT

OUTSIDE ☐ INSIDE ☐ REPAIRS ☐


EASEMENT No. \_\_\_\_\_

SPARKMAN MCLEAN

OWNER Jack Fitzpatrick CONTRACTOR Lynnwood Septic Tank Co PERMIT No. 3997

HOUSE No. 7003- 228th pl SW STREET \_\_\_\_\_ AVENUE LOT No. 3 BLOCK No. 3

NAME ADD. Lake Ballinger House #3

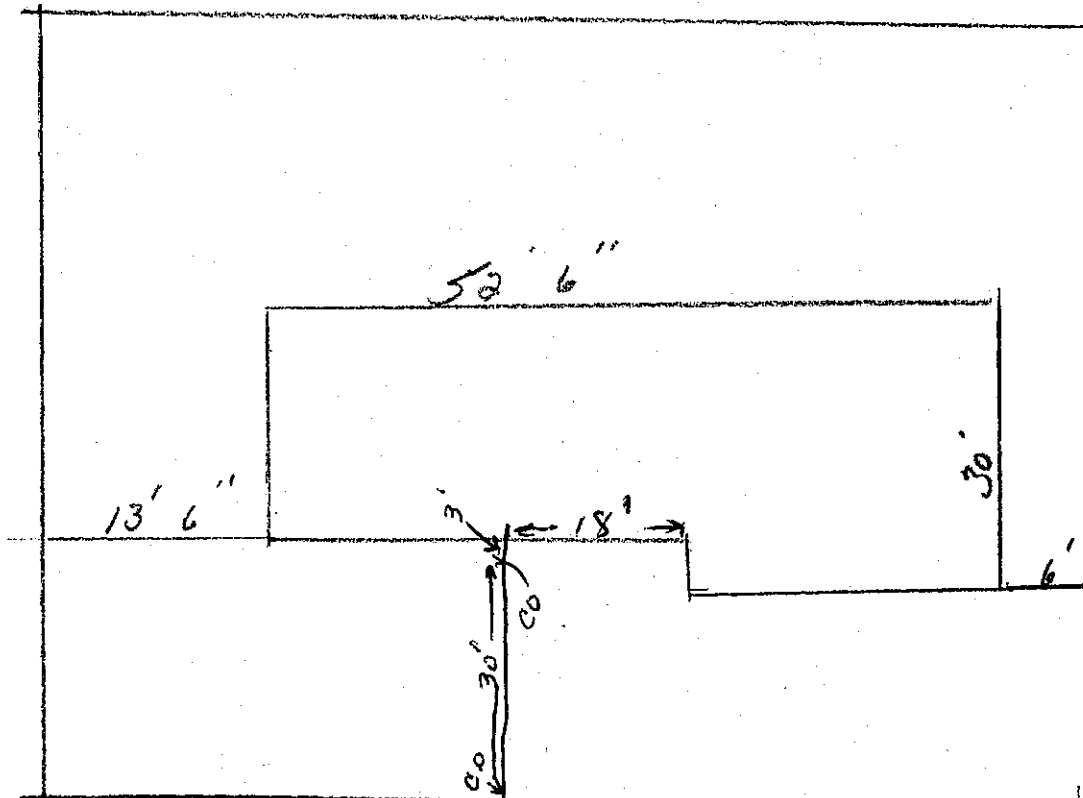

7003- 228th pl SW

CITY OF  
MOUNTLAKE TERRACE

OCT 20

Plan Approved John Hunter

Date

Approved:

BACKFILL WORK ORDER ISSUED \_\_\_\_\_ DEPOSIT, \$ \_\_\_\_\_

SEWER WORK ORDER ISSUED \_\_\_\_\_

DATE 10/21/65 BY John Hunter