


WOODLARK DIVISION A

53

DO

WOODLARK

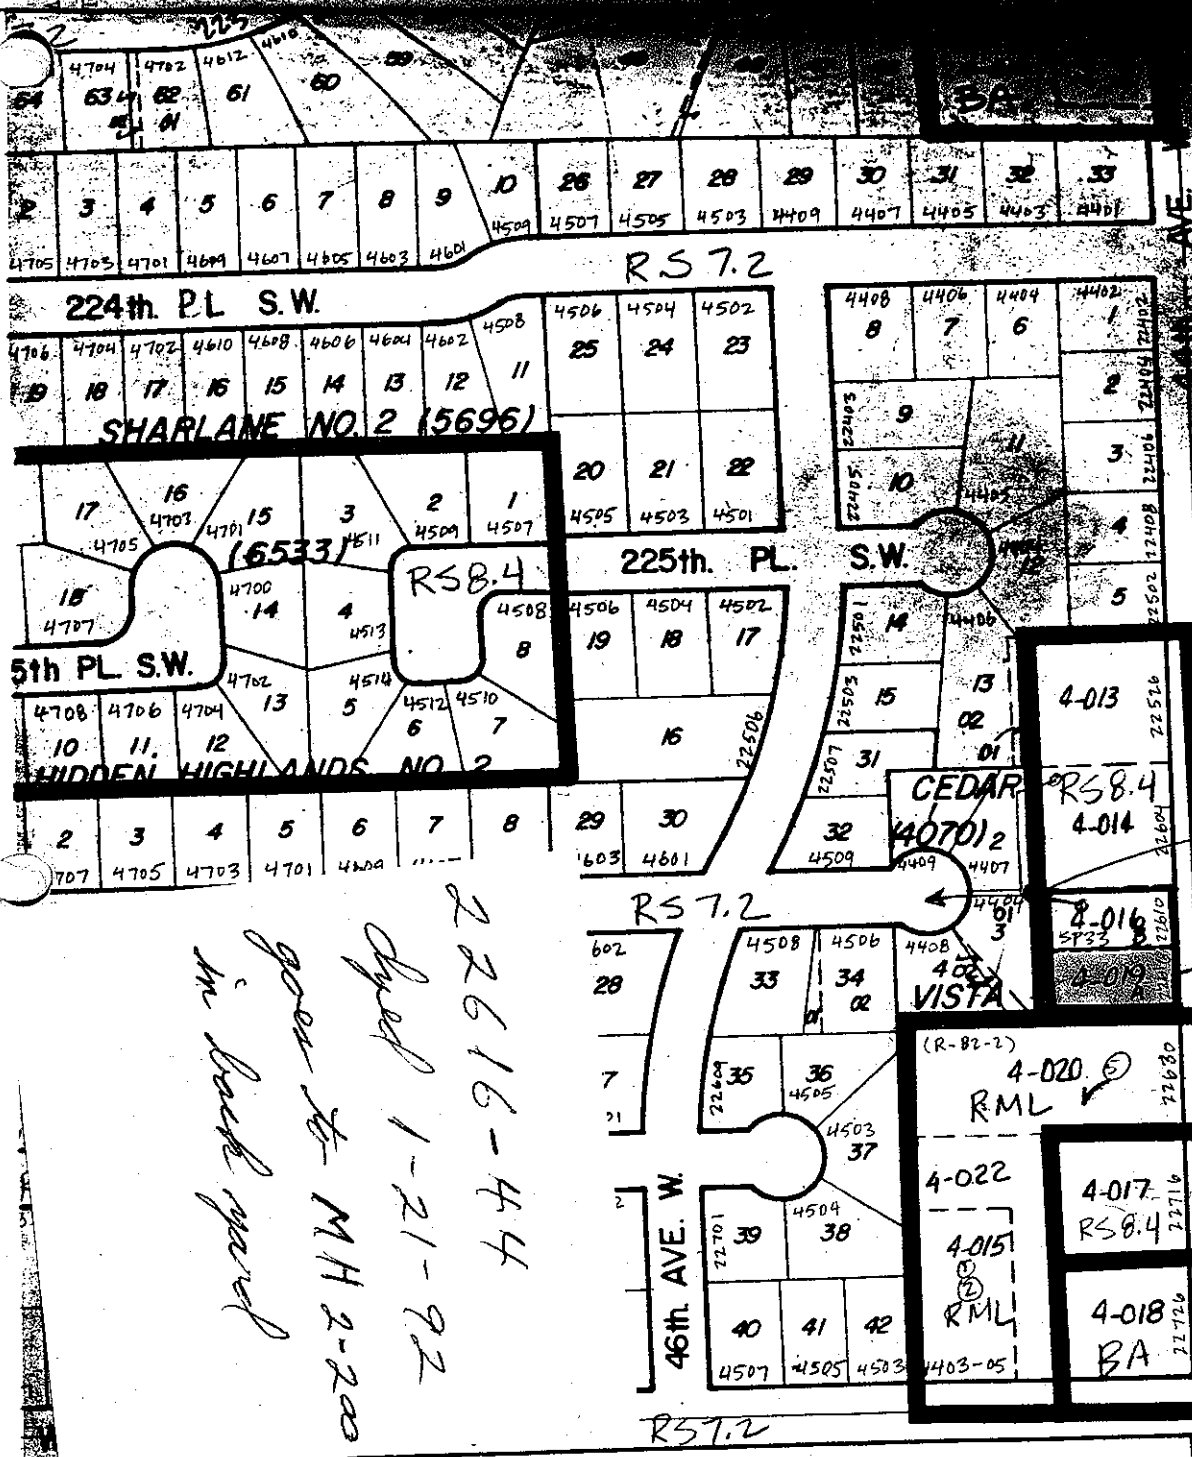

WOODLARK - DIV. B
(6/60)

MH 2-200

PAYING SEWER
CHARGE - NO
SIDE SEWER
RECORD
DRAWING
IN FILE

Hellock reports
DIE TEST
compr 22616
is on sewer
to manhole
in backyard
o 4404-22616
WOR

WOODLARK - DIVISION A (6/59)

D.D.R. May, '76

22616 44th

28 27
33 34
1992