

The City of Antlake Terrace

for
SIDE SEWER PERMIT
OUTSIDE ☒ INSIDE ☐ REPAIRS ☐

CARD No. _____

EASEMENT No. _____

OWNER _____

CONTRACTOR Lin Homes Lynnwood Septic Tank


U 23 77
PERMIT No. _____

HOUSE No. 4508 225th St SW

STREET
AVENUE LOT No. 8

BLOCK No. _____

NAME ADD Hidden Highlands No 2

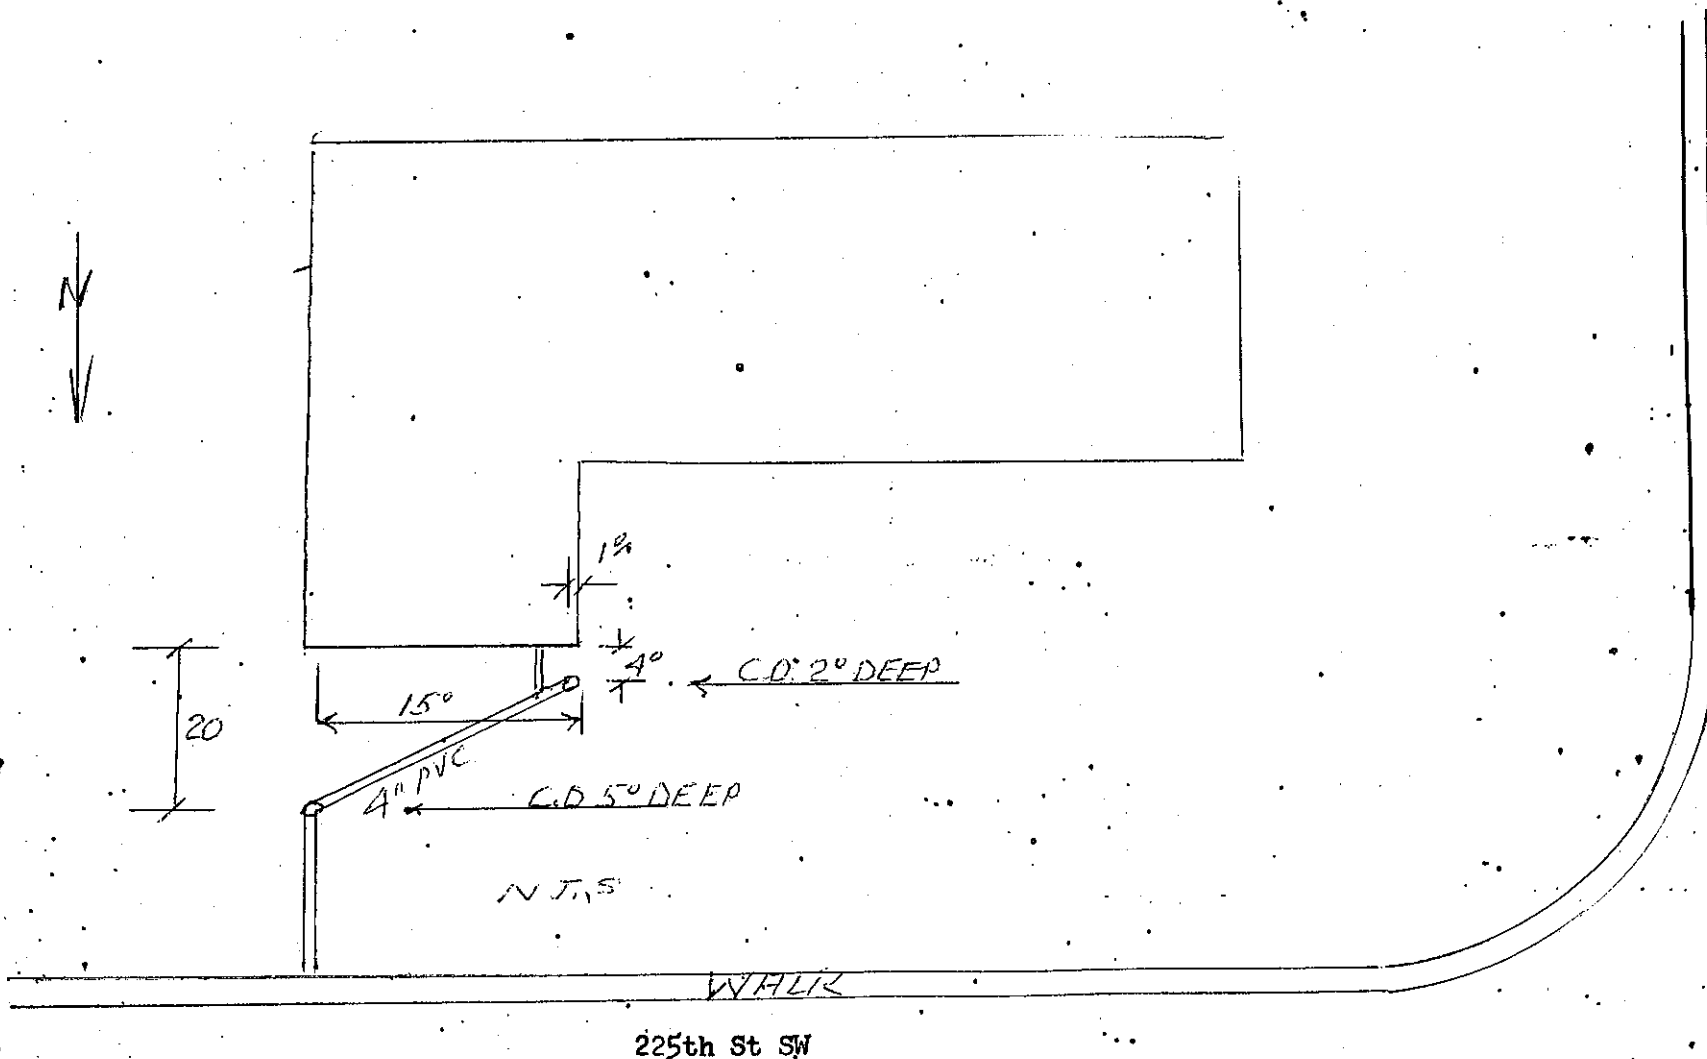

BACKFILL WORK ORDER ISSUED 3 22 77 Date 20.00
SEWER WORK ORDER ISSUED 3 18 77 DEPOSIT, \$ _____

Approved: _____

DATE 3 22 77

BY _____