


SIDE SEWER AS BUILT



CENTERLINE 214th St SW



8" SEWER MAIN

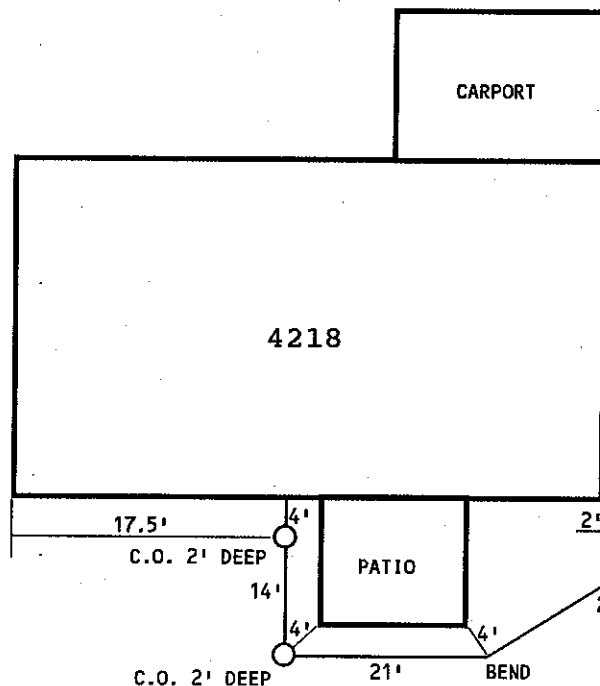

8" SIDE SEWER

C.O. 5' DEEP

4" P.V.C.

77'

11'

C.O. 3' DEEP

24'

BEND

21'

C.O. 2' DEEP

14'

4'

17.5'

C.O. 2' DEEP

CARPORT

4218

PATIO

OWNER Dahl Massey

ADDRESS 4218 214th St. SW

CONTRACTOR Weber Services

PERMIT NO. U-90-16

RECEIPT NO. 800

WORK ORDER ISSUED 7-29-90

BY B.W.

BACKFILL APPROVED 8-2-90

BY B.V.

AS BUILT 8-14-90

BY D.M.S.