

**for**

## The City of Mountlake Terrace

## SIDE SEWER PERMIT


OUTSIDE ☐ INSIDE ☐ REPAIRS ☐

EASEMENT No.-----

OWNER Kirkwood Homes, Inc. CONTRACTOR Synovate Septic Tank, Inc. PERMIT No. \_\_\_\_\_

HOUSE No. 7103 - 210 511 AVENUE LOT No. 14 2nd Street A BLOCK No. \_\_\_\_\_

NAME ADD-----

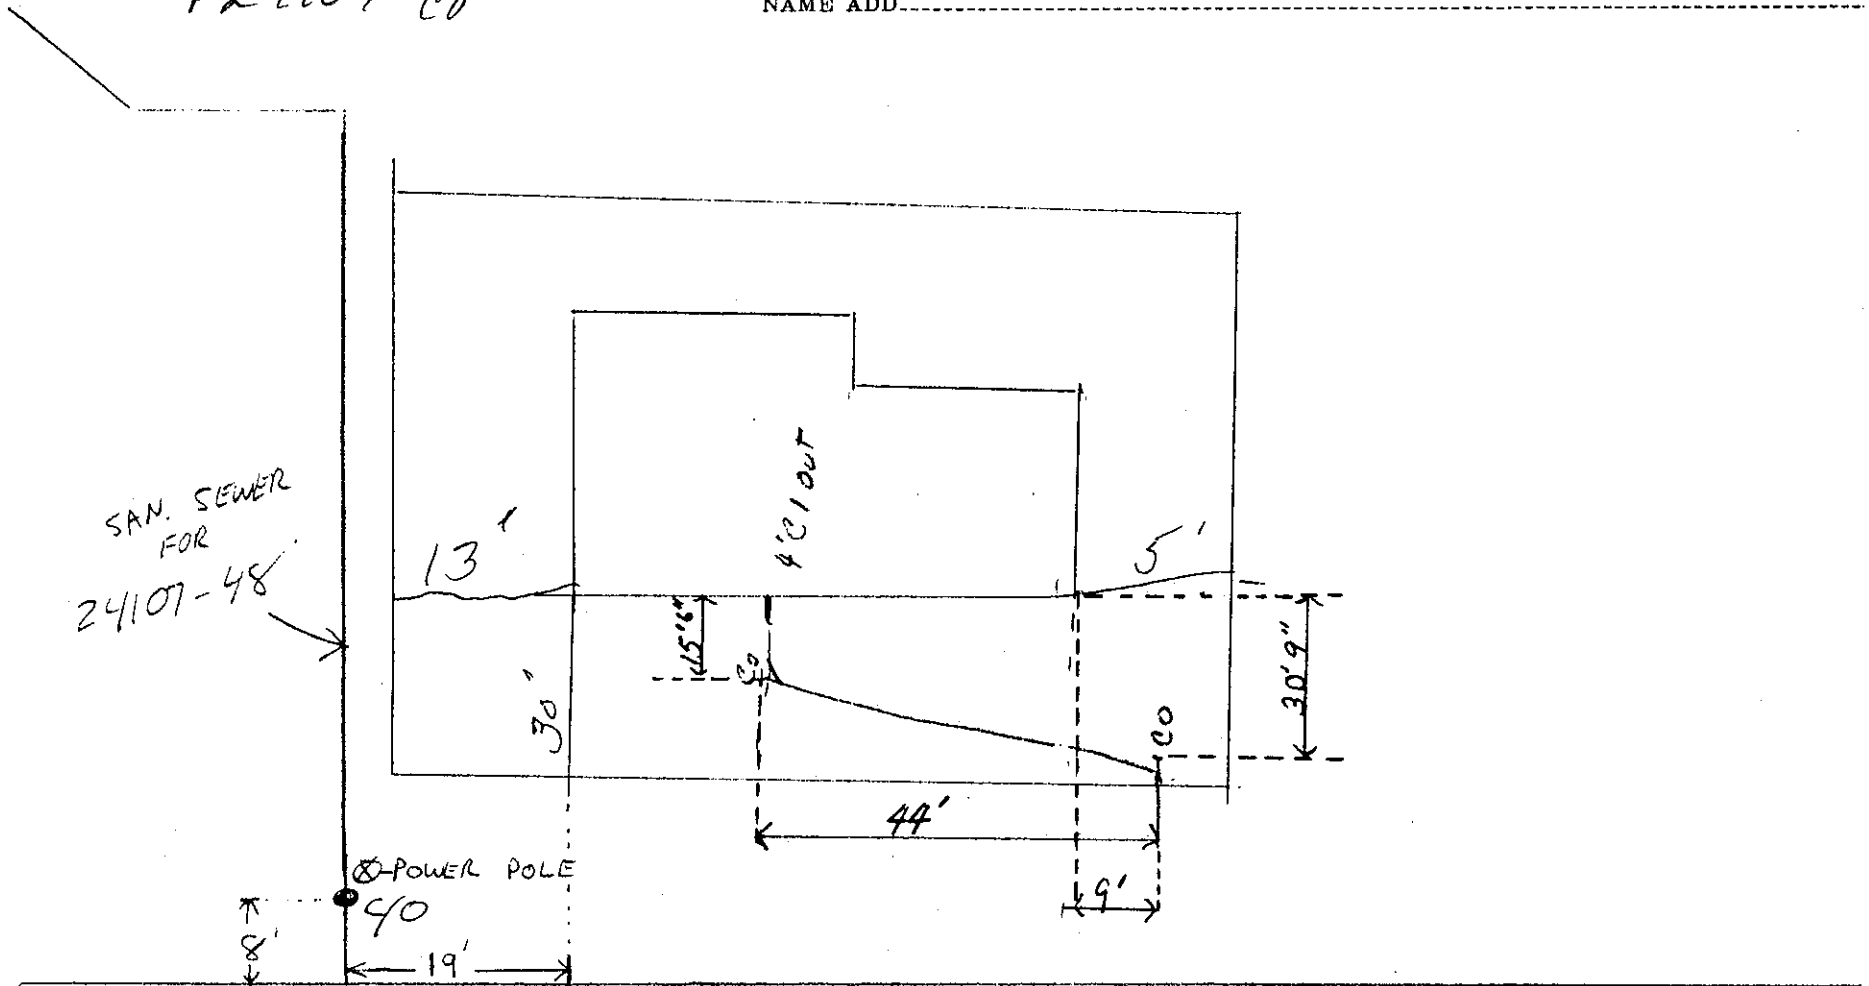

242 ND

Date \_\_\_\_\_

Approved:

BACKFILL WORK ORDER ISSUED..... DEPOSIT, \$.....

SEWER WORK ORDER ISSUED-----

DATE 9-26-78 BY [signature]