
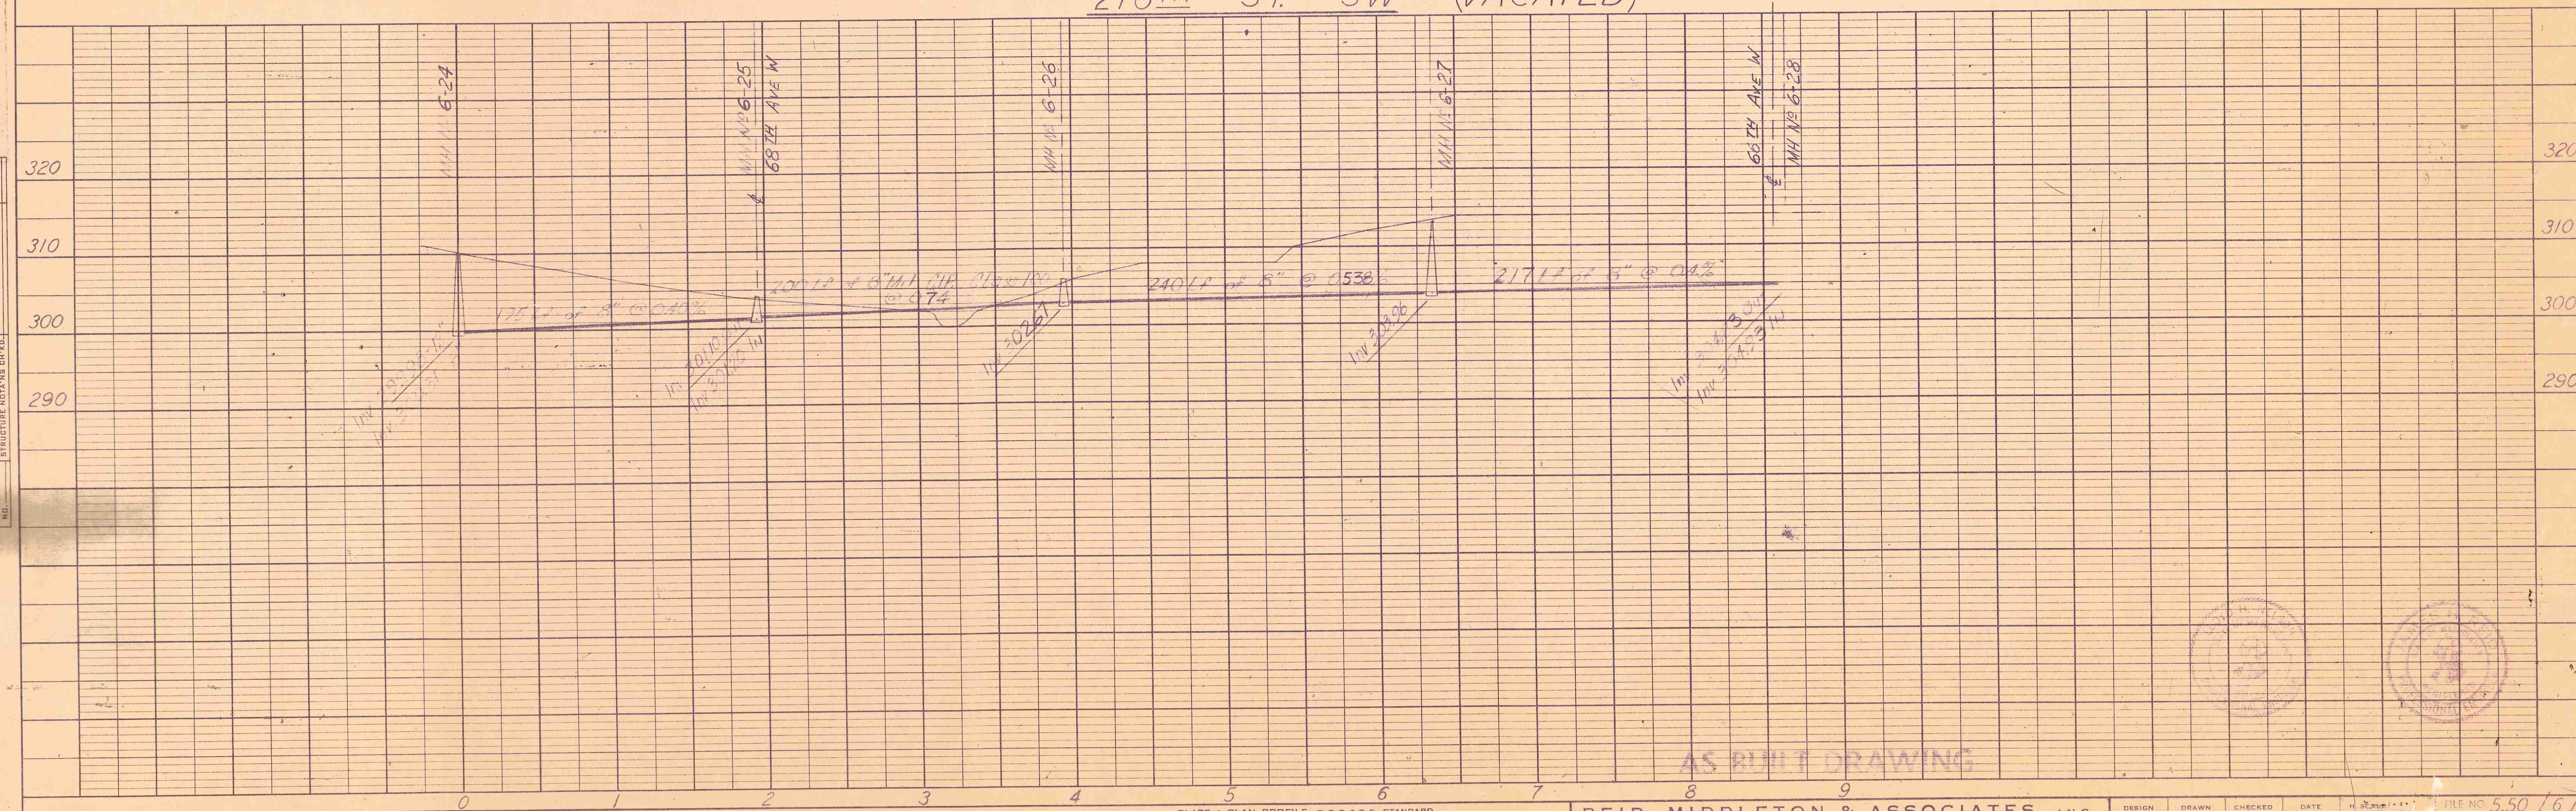
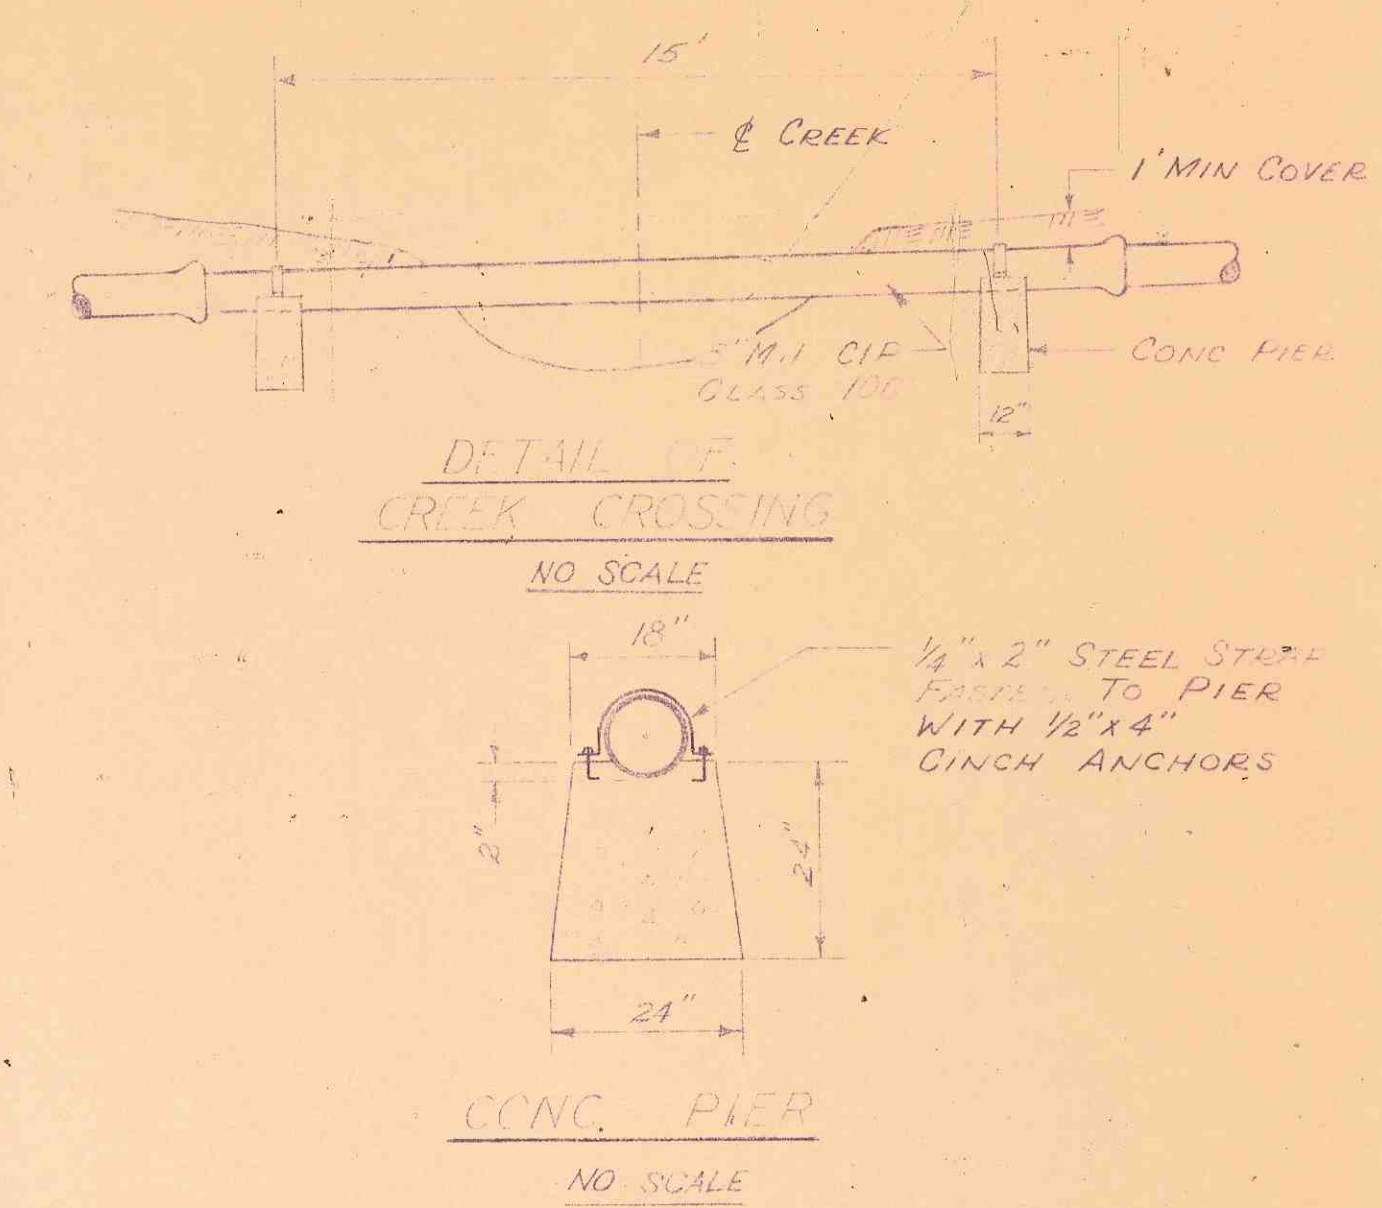


PLAN	DATE	7/1/71
	BY	FD
	SURVEYED	
	PLOTTED	
NOTE BOOK	NOTE BOOK	NO. 253
	GRADES CHECKED	
	STRUCTURE NOTATIONS CHYD.	
	NO.	

PROFILE	DATE	
	BY	
	SURVEYED	
	PLOTTED	
NOTE BOOK	NOTE BOOK	
	GRADES CHECKED	
	STRUCTURE NOTATIONS CHYD.	
	NO.	

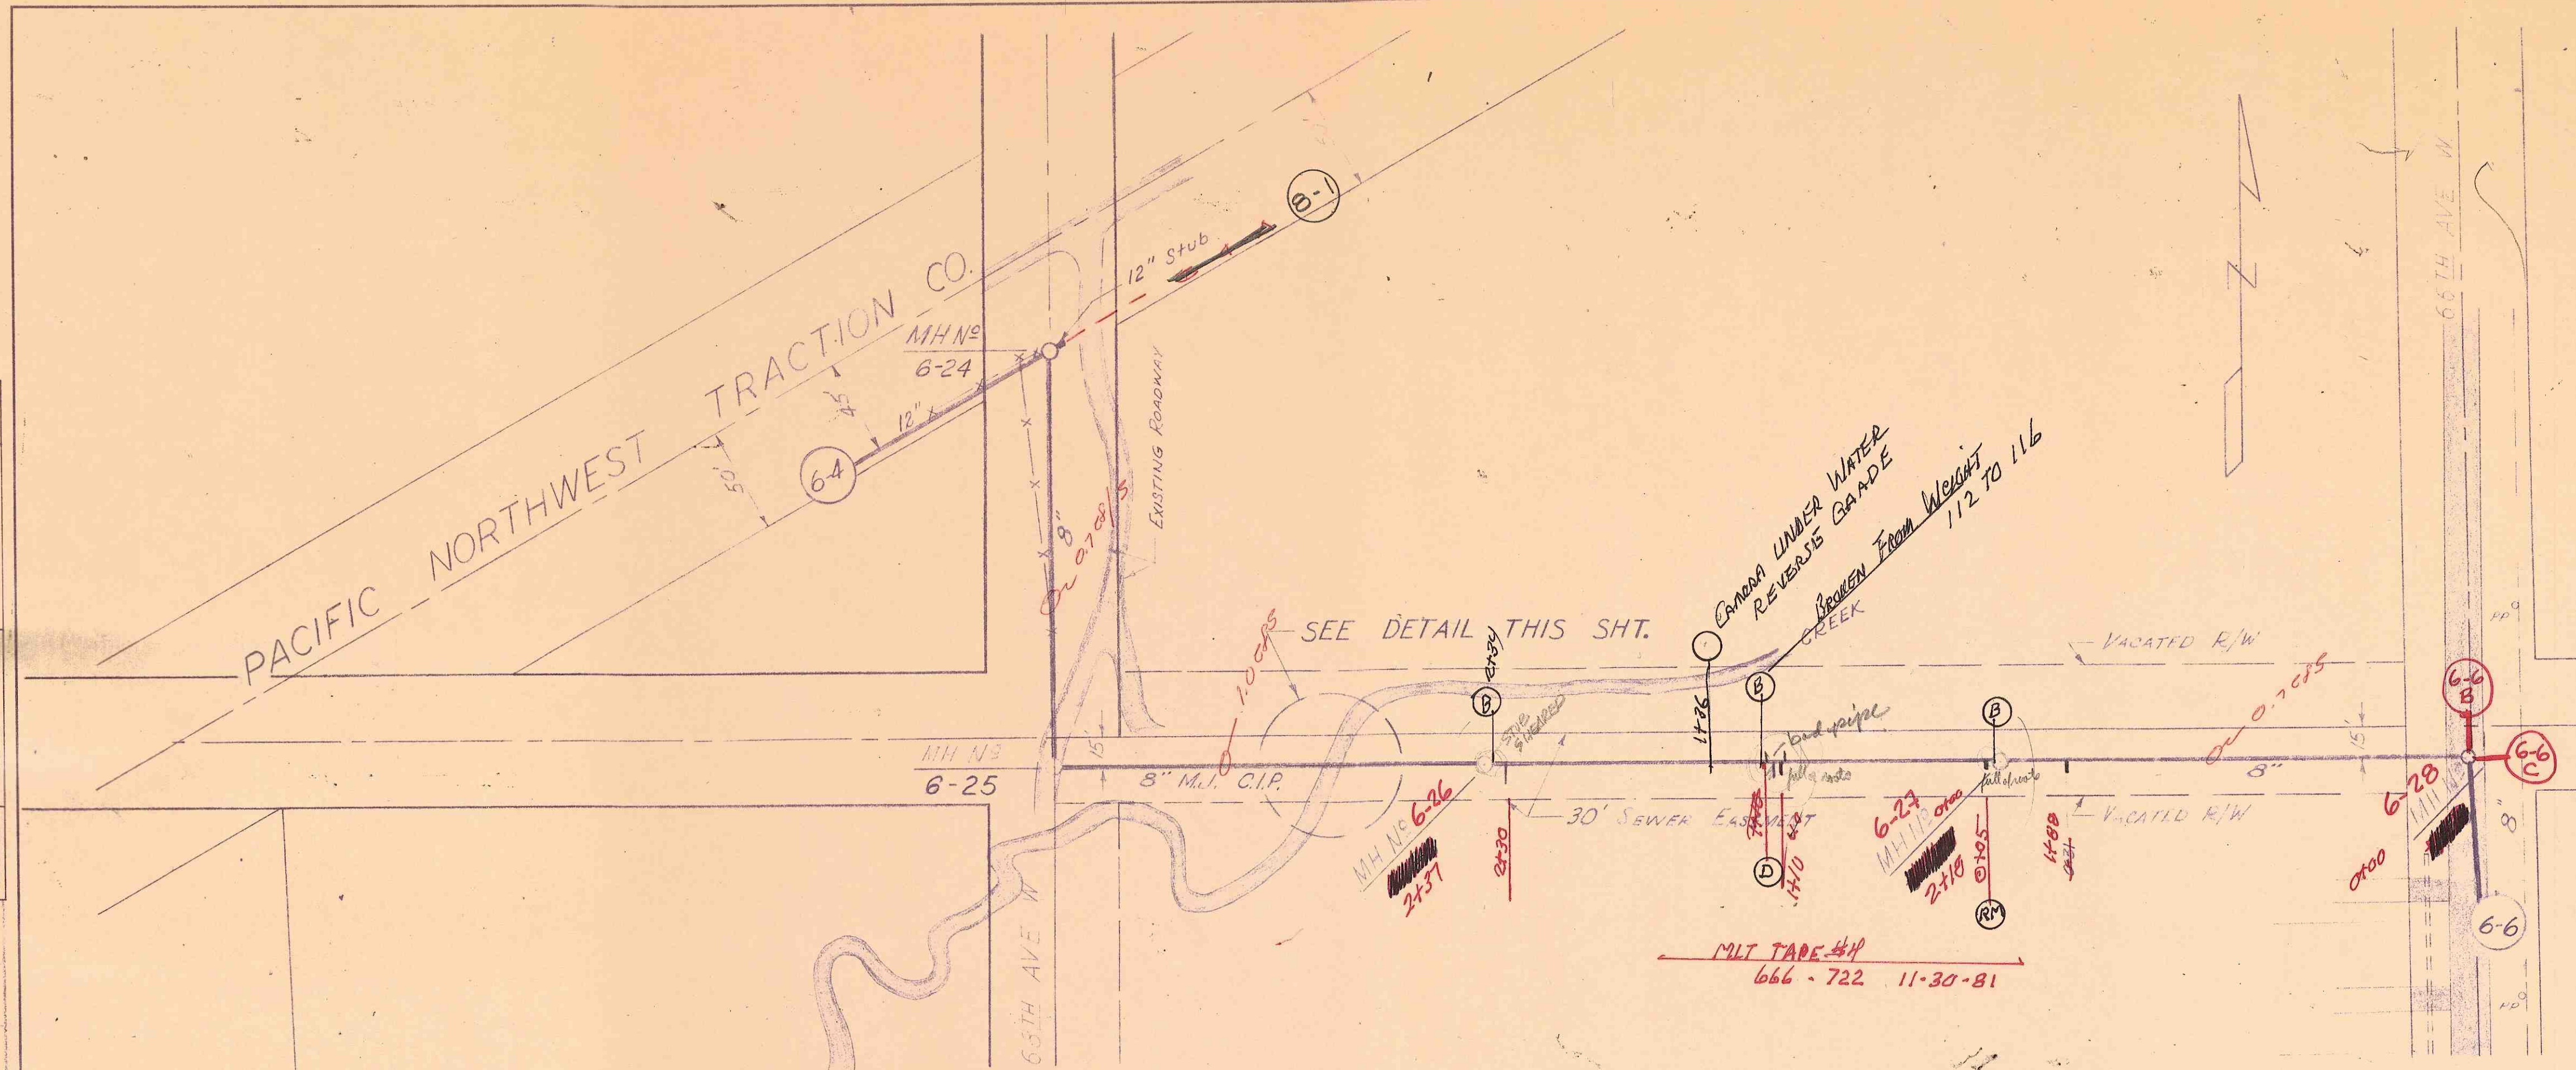

AS BUILT DRAWING

PLATE 1-PLAN-PROFILE O.P.R. & R.E. STANDARD  
100% AGEPROOF VELLUM - MADE AND PRINTED IN U.S.A.  
EUGENE DIETZEN CO.

REID, MIDDLETON & ASSOCIATES, INC.  
CONSULTING ENGINEERS & LAND SURVEYORS, 324 MAIN ST., EDMONDS, WASH.

DESIGN	DRAWN	CHECKED	DATE	FILE NO.
LHN	AS	LHN	7-7-61	5.50 / 61
SHEET				5 OF 10

SEWERAGE SYSTEM UNIT 6