

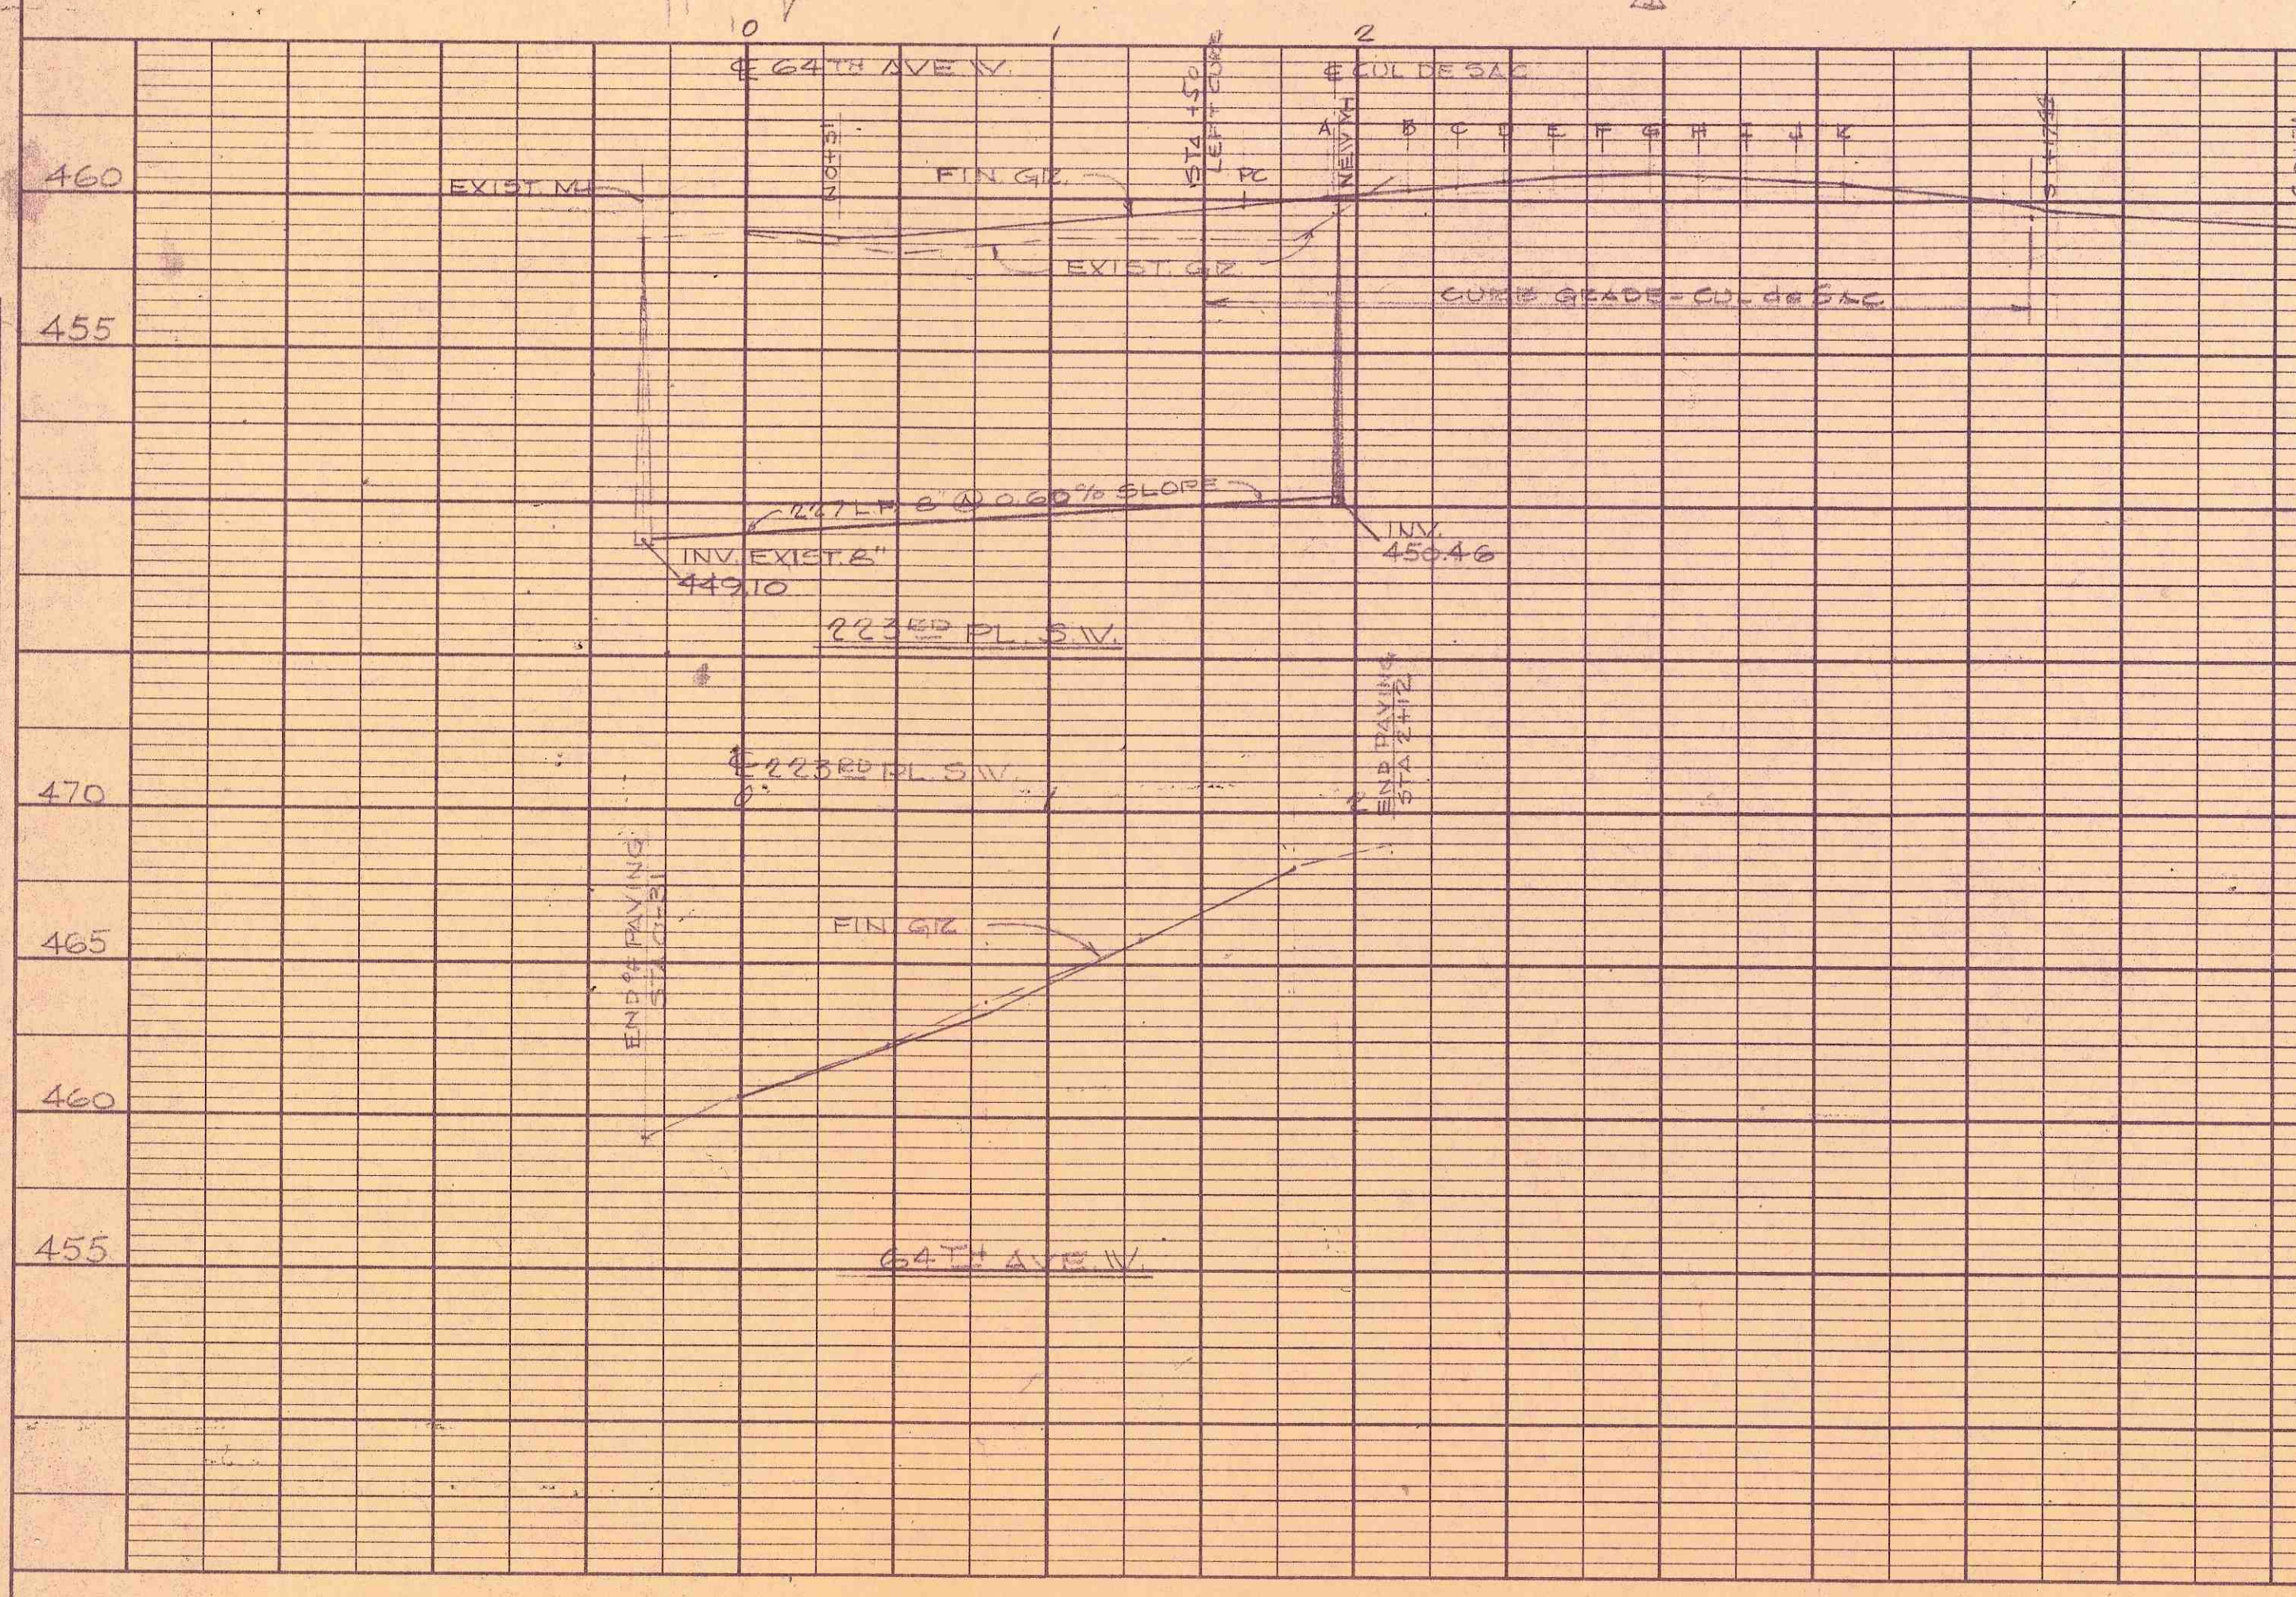



PROFILE		BY	DATE
SURVEYED.....			
PLOTTER.....			
GRADES CHECKED.....			
B. M. NOTED.....			
STRUCTURE NOTING CH'KD.....			
NO.			

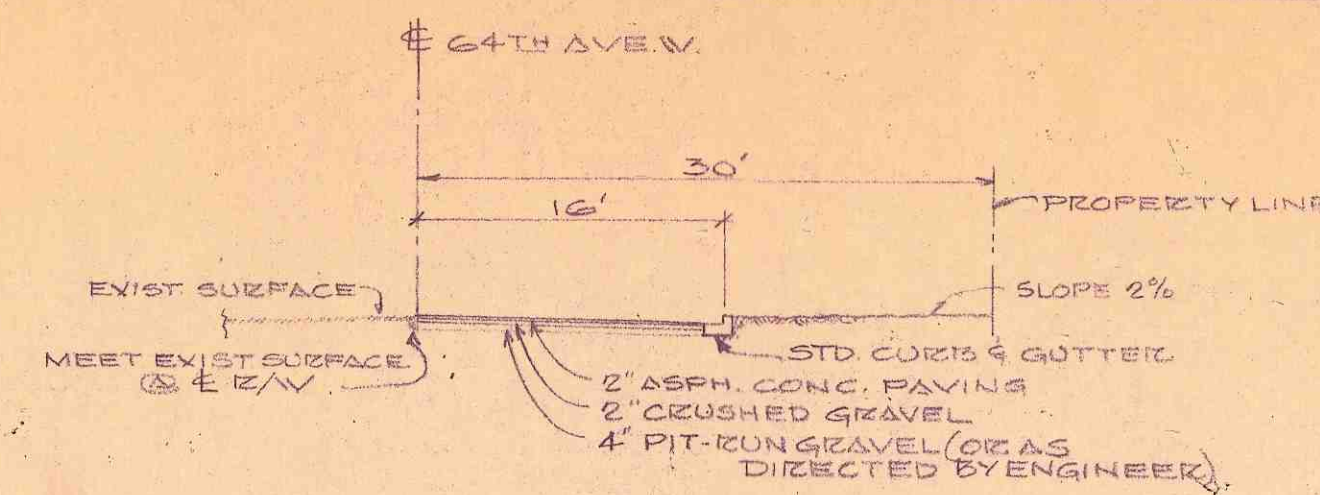

NOT AS
BUILT

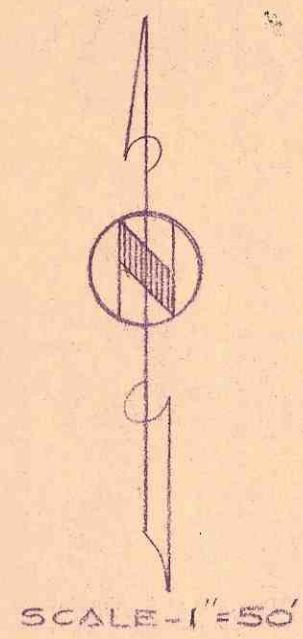



TYPICAL CROSS-SECTION FOR
PAVING ON 64TH AVE. W.
SCALE - 1" = 10'

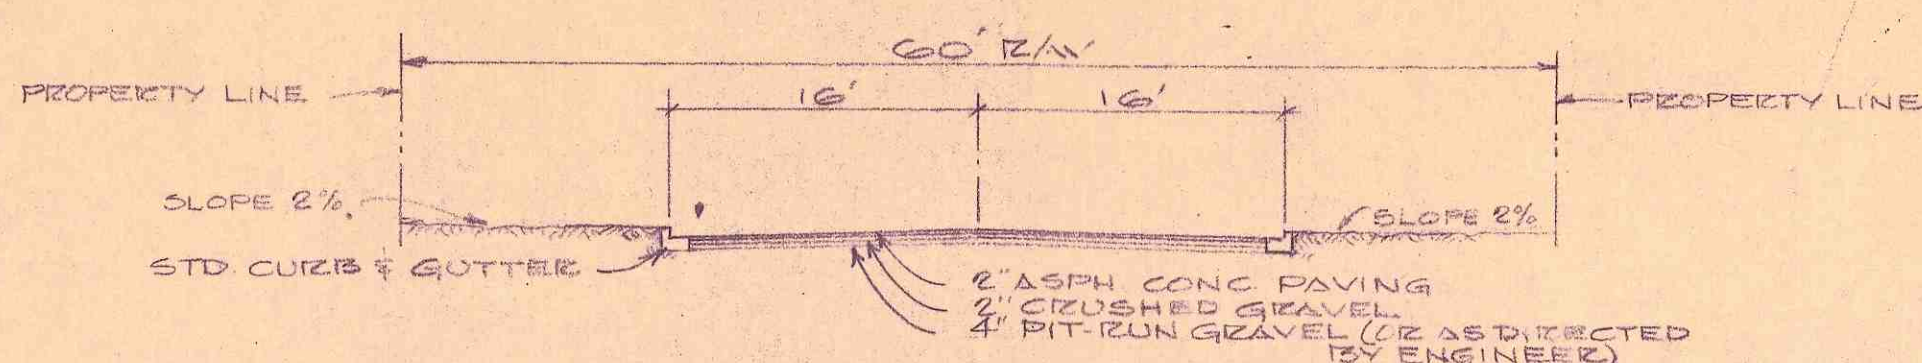
 


TYPICAL CROSS-SECTION

SCALE-1"=10'

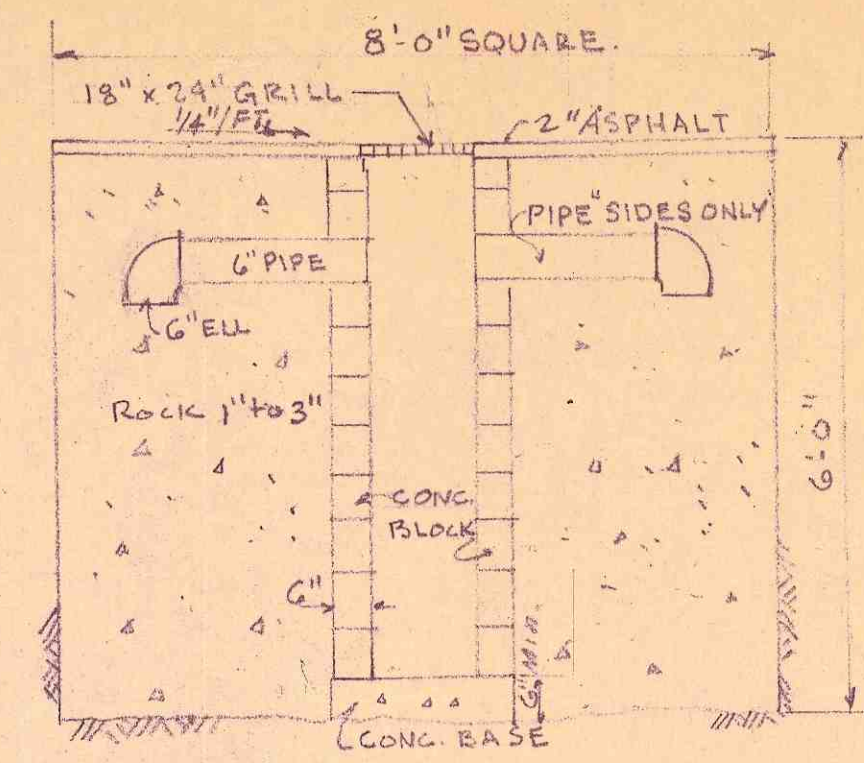

DRY WELL DETAIL 
NOT TO SCALE

	DEY WELL AND WALL ADDED	4110.61	E.O.
	CHANGE PROPERTY LINES	316.61	D.F.W.
NO.	REVISIONS	DATE	BY
CITY OF MOUNTLAKE TERRACE			
CURBS & PAVING, 12" SANITARY SEWER, STORM DRAIN, 4" C.I. WATERMAIN FOR DORZO-LYNN PARK			SCALE AS NOTED
			DATE 3/11
			DESIGN E.L.C.
			DRAWN 
			CHECKED E.L.
			FR 98
REID, MIDDLETON & ASSOCIATES, INC. CONSULTING ENGINEERS & LAND SURVEYORS 324 MAIN STREET EDMONDS, WASHINGTON			FILE NO. 5.163 SHEET

AS BUILT DRAWING

Scan Name: scans06502.pdf
Scan Date:

AS BUILT DRAWING # 5.1630

3-17-A