

THE CITY OF MOUNTLAKE TERRACE

APPLICATION

FOR

SIDE SEWER PERMIT

OUTSIDE ☐ INSIDE ☐ REPAIRS ☐

CARD No. \_\_\_\_\_

EASEMENT No. \_\_\_\_\_

OWNER Pacesetter Const.

CONTRACTOR Lynnwood Septic Tank


PERMIT No. 4150

HOUSE No. 6808-226 PL SCW

STREET AVENUE LOT No. 27

BLOCK No. \_\_\_\_\_

NAME ADDR Lake Ballinger Homes #3

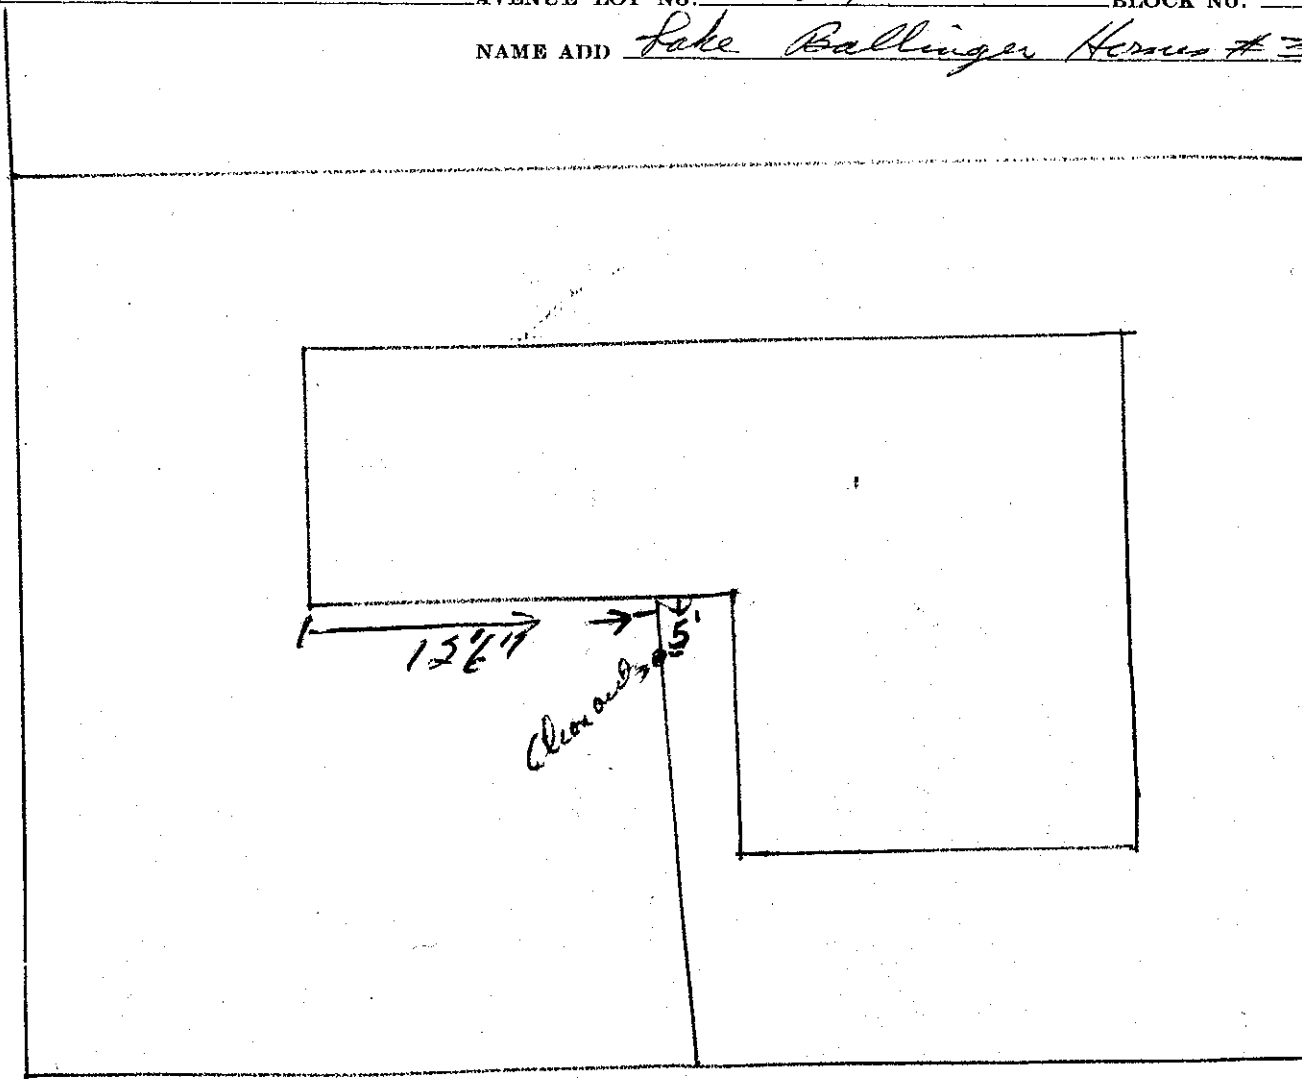

DATE 3-9-67

BACKFILL WORK ORDER ISSUED \_\_\_\_\_

DEPOSIT. \$ 10.00

APPROVED: \_\_\_\_\_

SEWER WORK ORDER ISSUED \_\_\_\_\_

J.H.

DATE \_\_\_\_\_ BY \_\_\_\_\_