

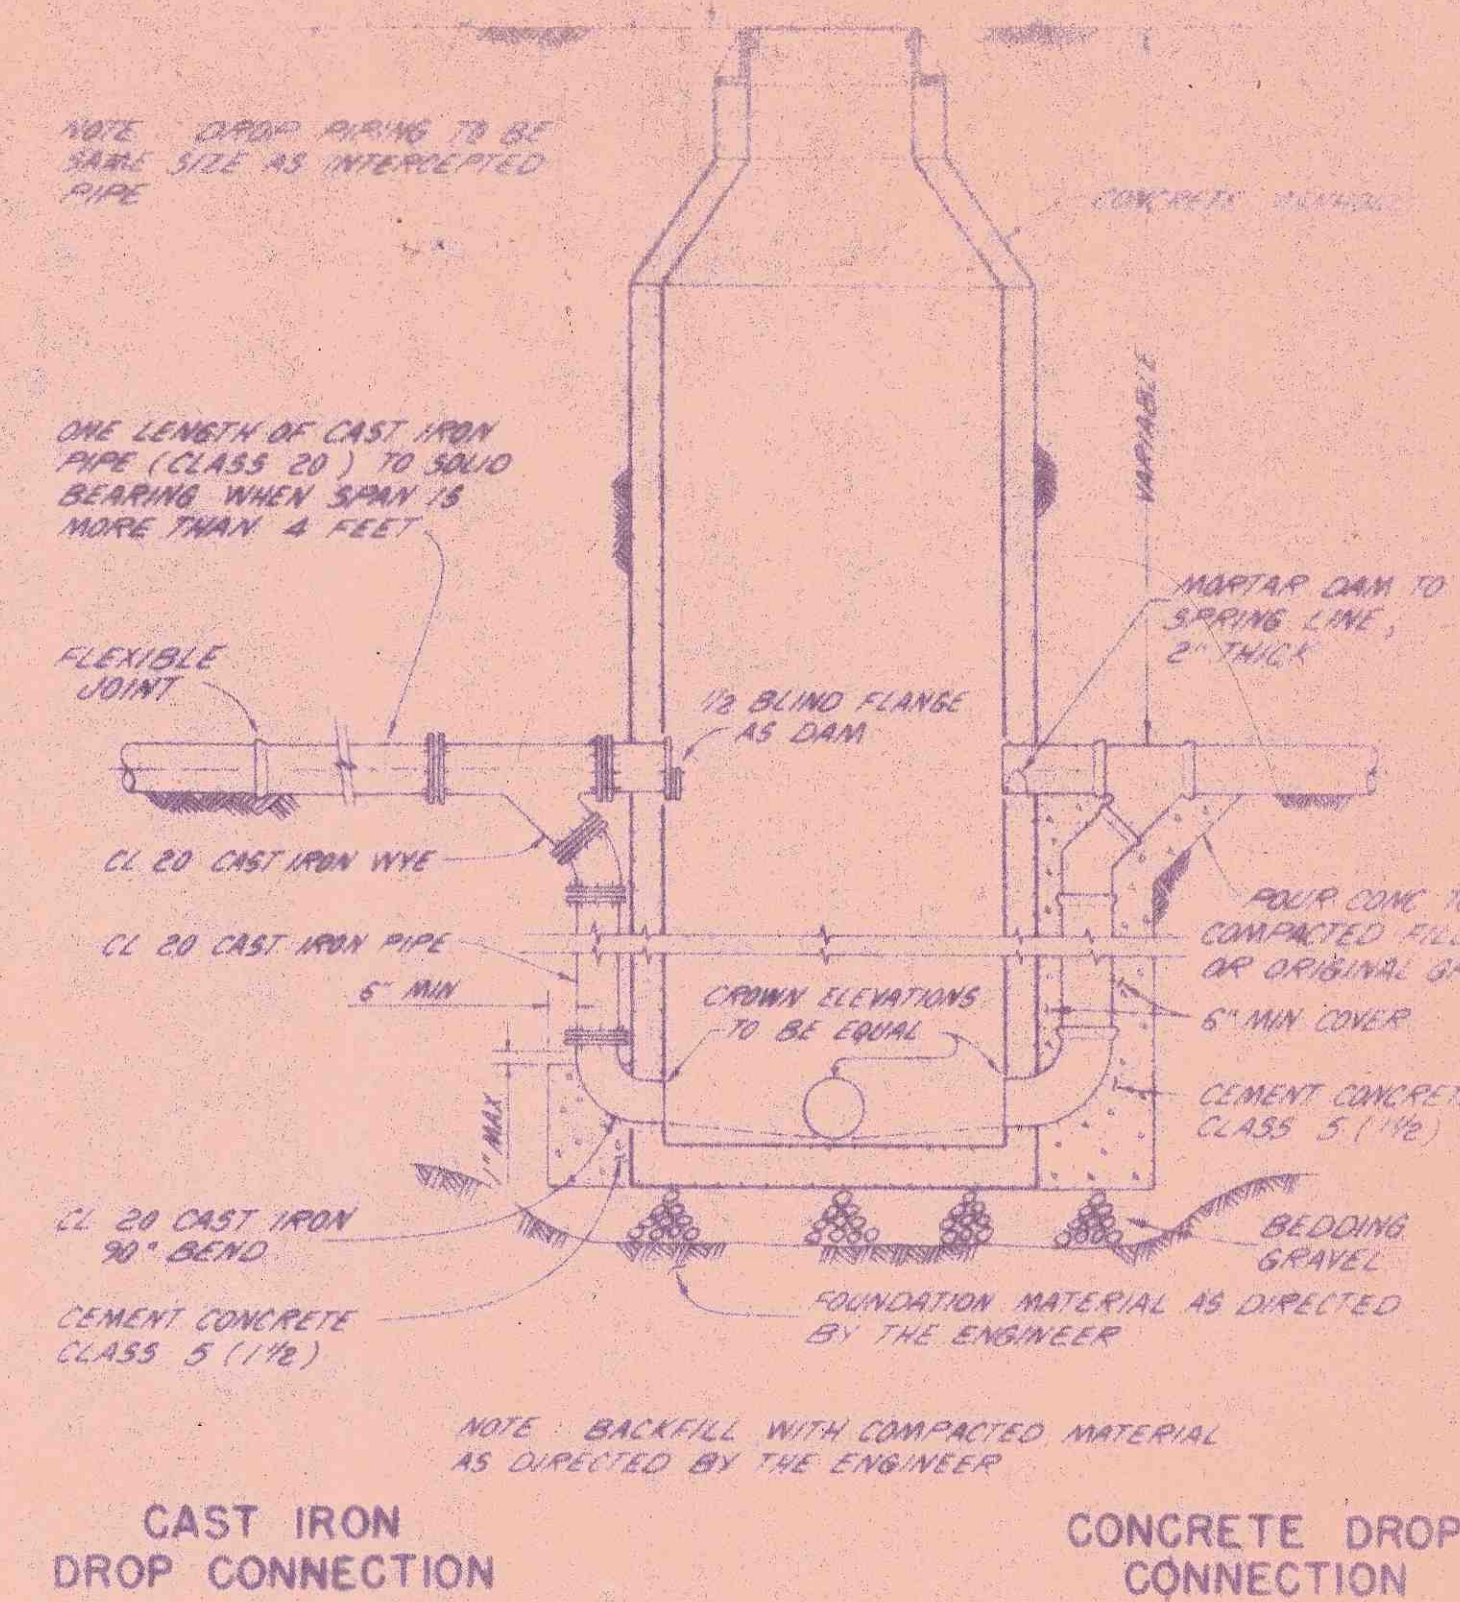


SO
 DATE
 PROJECT
 SURVEY
 SHEET
 NO.
 DATE
 PROJECT
 SURVEY
 SHEET
 NO.
 DATE

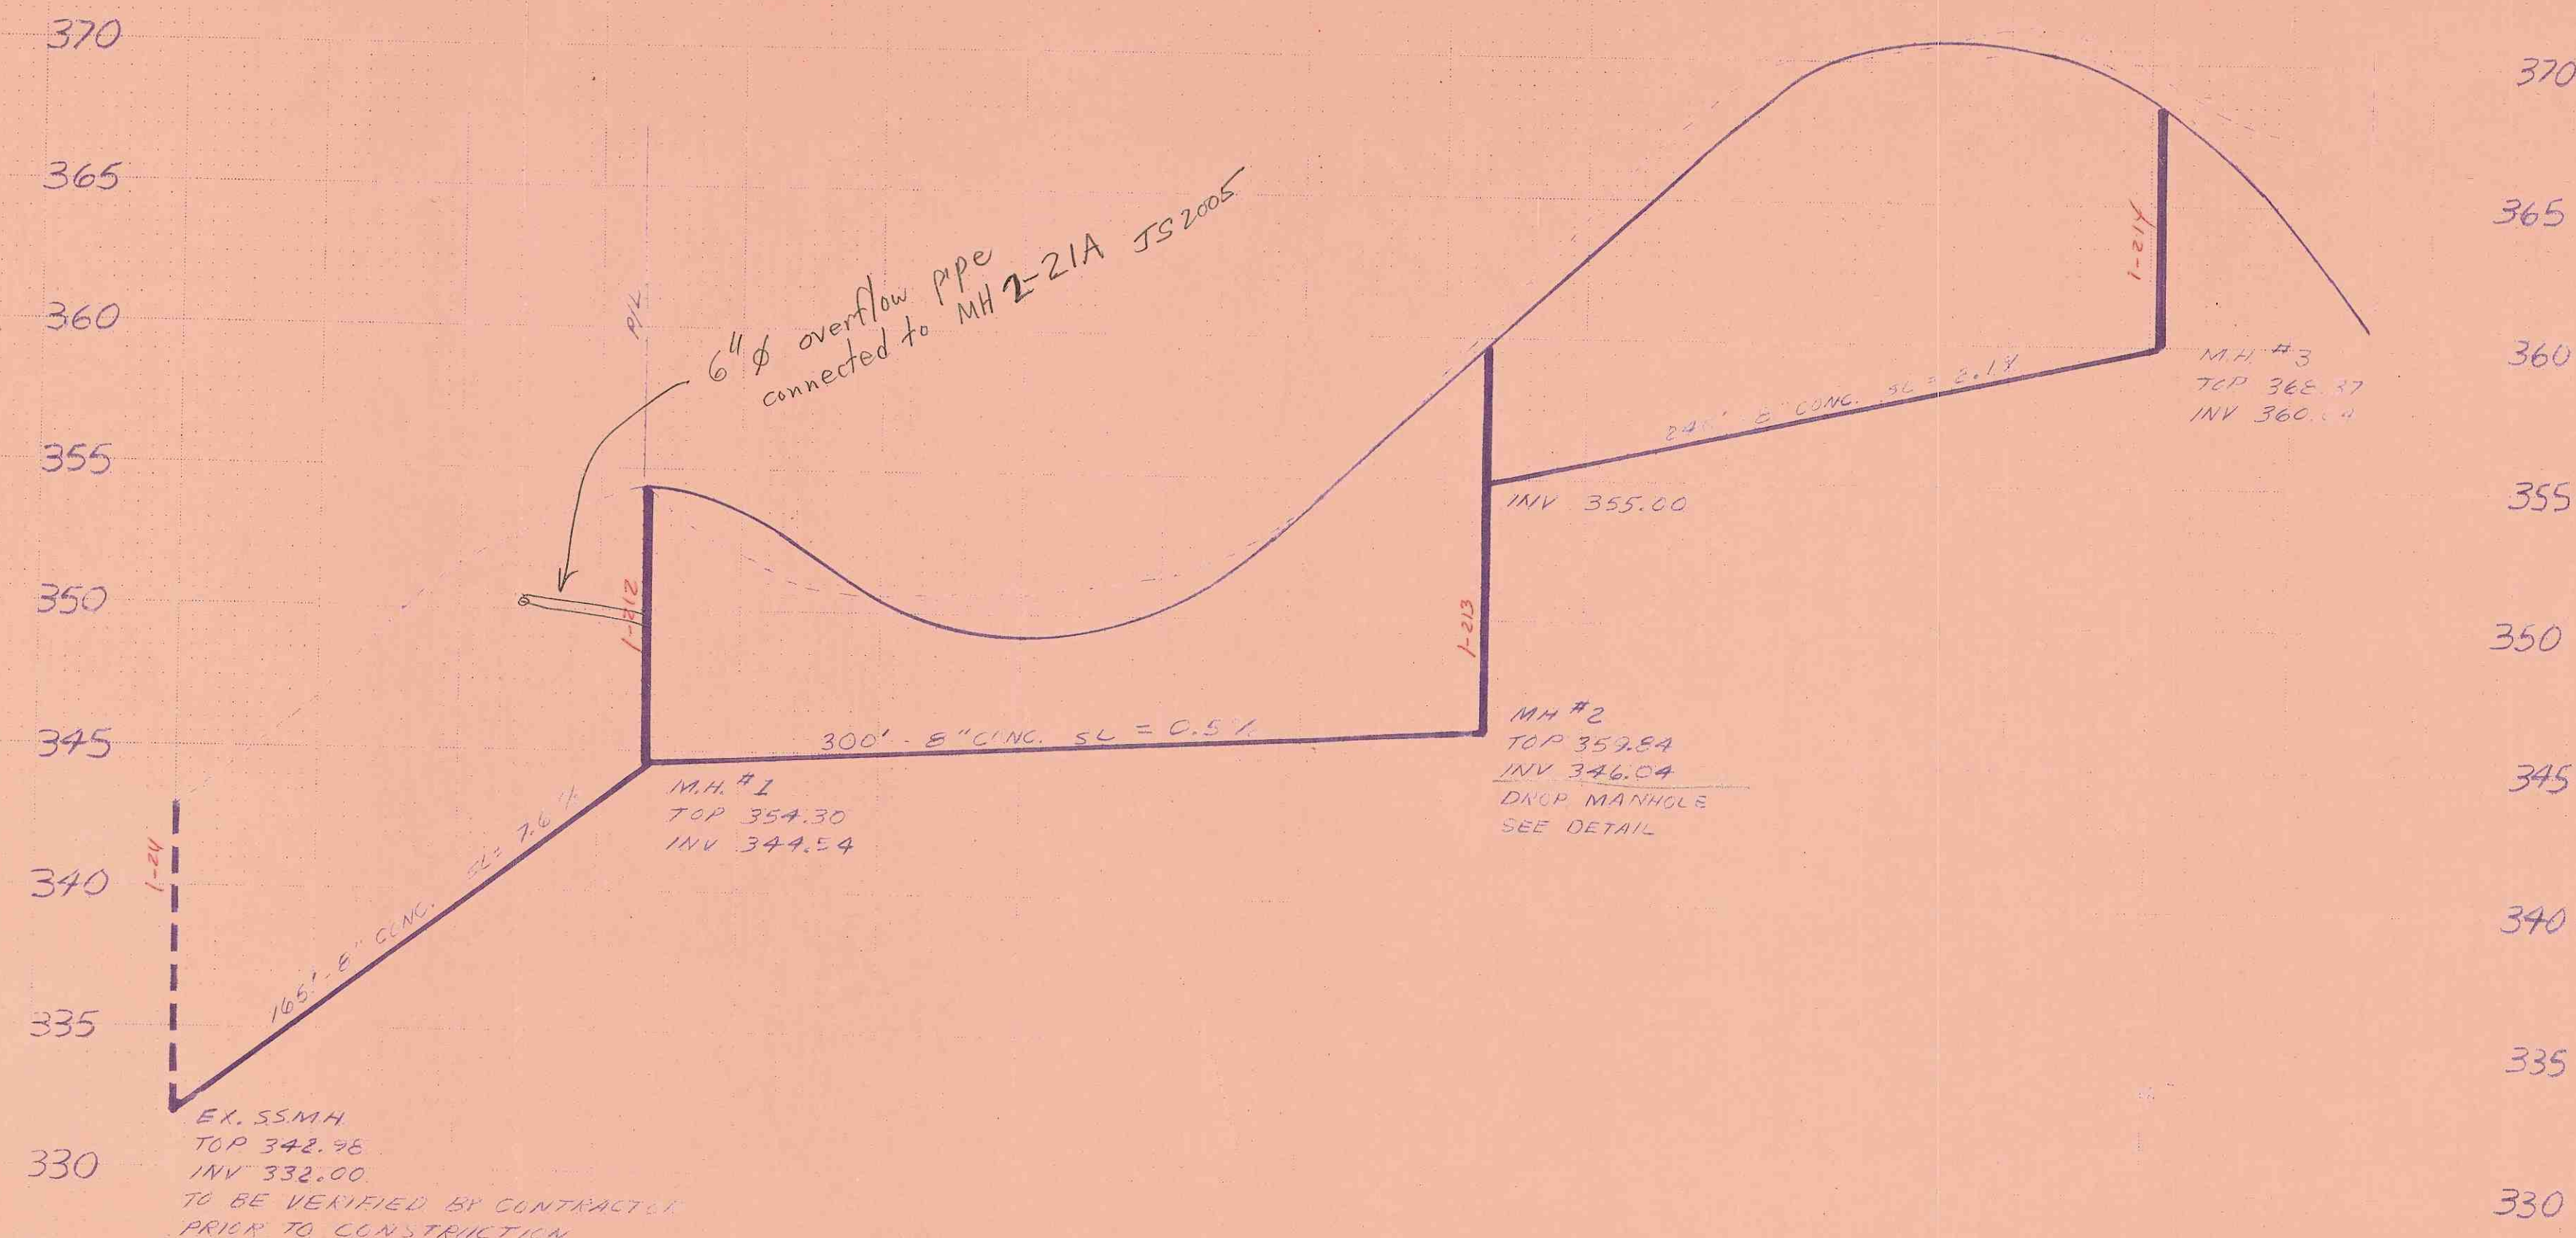

TYPICAL DROP MANHOLE CONNECTION DETAIL
 NO SCALE

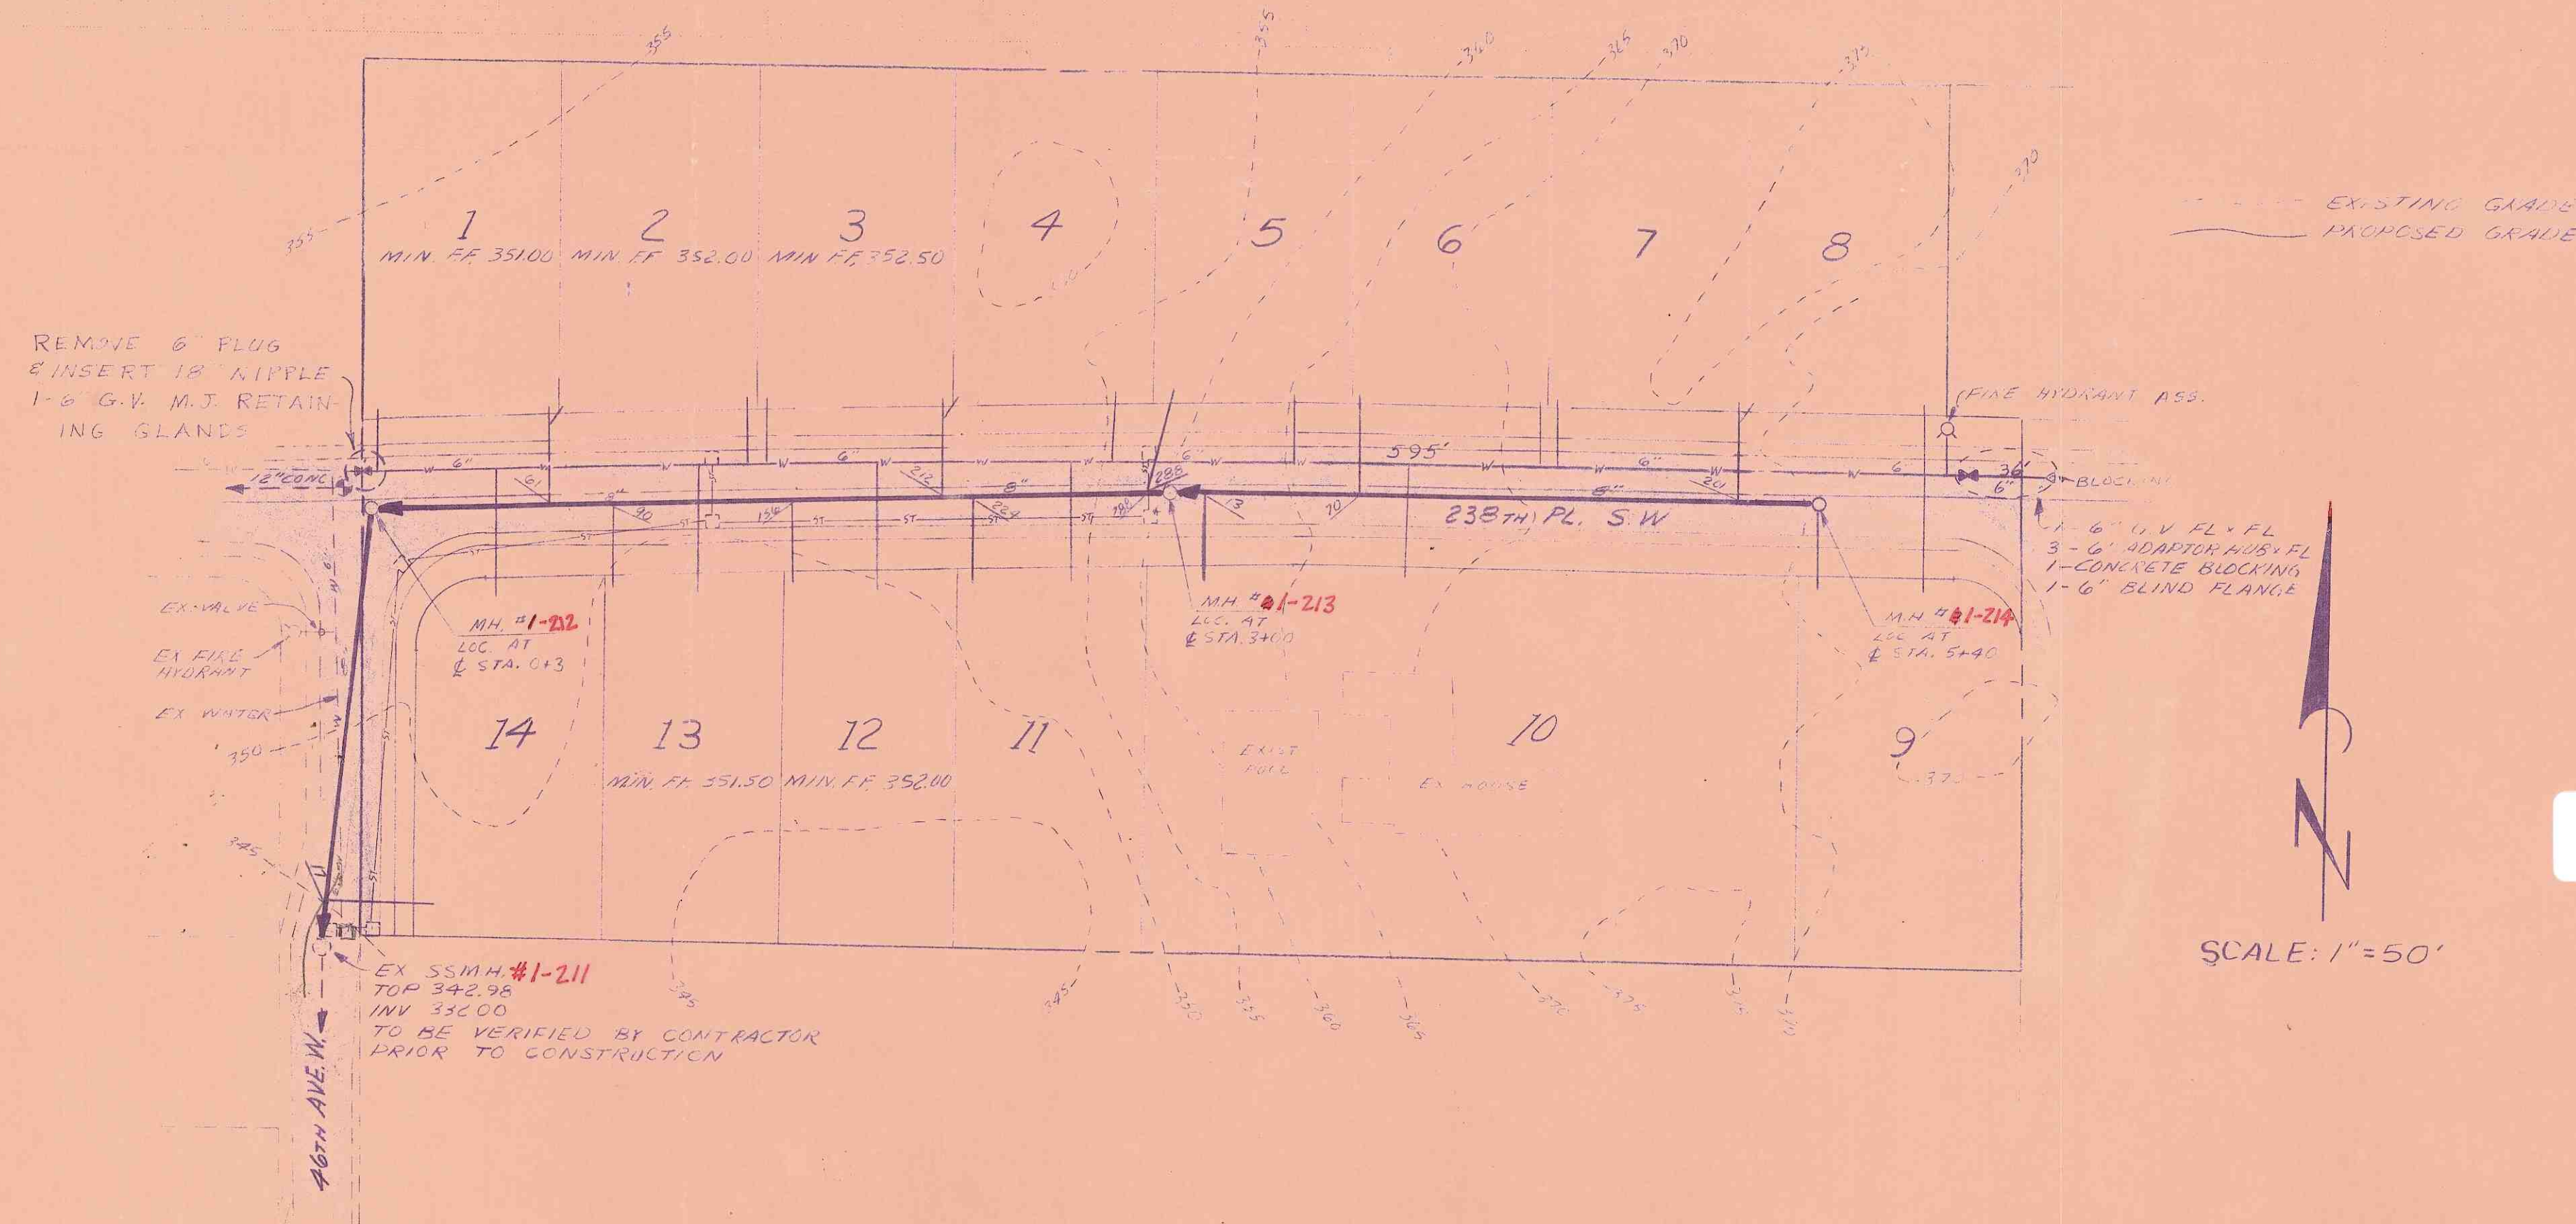

GENERAL NOTES

1. ALL LOCATIONS OF EXISTING UTILITIES ARE APPROXIMATE AND IT SHALL BE THE RESPONSIBILITY OF THE CONTRACTOR TO VERIFY THE CORRECT LOCATIONS SO AS TO AVOID DAMAGE OR DISTURBANCE.
2. ALL WORK AND MATERIALS TO BE IN ACCORDANCE WITH THE CITY OF MOUNTLAKE TERRACE STANDARDS AND SPECIFICATIONS, OR APWA SPECIFICATIONS.
3. TEST OBSERVATION AND INSPECTION SHALL BE BY THE CITY OF MOUNTLAKE TERRACE.
4. THE CONTRACTOR SHALL BE RESPONSIBLE FOR THE INSTALLATION OF SIDE SEWERS (LATERALS & TEES) AND THE PLACING OF 2x4 MARKERS WITH THE LENGTH AND DEPTH OF THE LATERALS & TEES, INSCRIBED ON THE MARKERS. LATERALS TO BE 6\"/>

Scan Name: scans06152.pdf
 Scan Date:

DATUM: CITY OF MOUNTLAKE TERRACE
 SANITARY SEWER M.H. INT. 238TH
 PL. S.W. & 46TH AVE. W.
 INV. ELEV. 348.83

Long Brothers Engineering, Inc. PLANNING - ENGINEERING - SURVEYING 7116 - 220TH S.W. MOUNTLAKE TERRACE, WASH. 98043 PH. (206) 774-8863			
DRAWN BY (Signature)	CHECKED BY (Signature)	JOB NO. 541	SHEET 1 OF 2
PROJECT MANAGER M. MULLEN		SHEET 1 OF 2	

9-2-A
 1-18-J