

APPLICATION

for

SIDE SEWER PERMIT


CARD No. _____

The City of Mountlake Terrace

OUTSIDE ☐ INSIDE ☐ REPAIRS ☐

EASEMENT No. _____

OWNER Jim Hellerstedt CONTRACTOR North End Septic Tank Co. PERMIT No. _____
 HOUSE No. 22402-39 Ave W. STREET _____
 AVENUE LOT No. Lot 4 BLOCK No. A
 NAME ADD. Cedar Grove

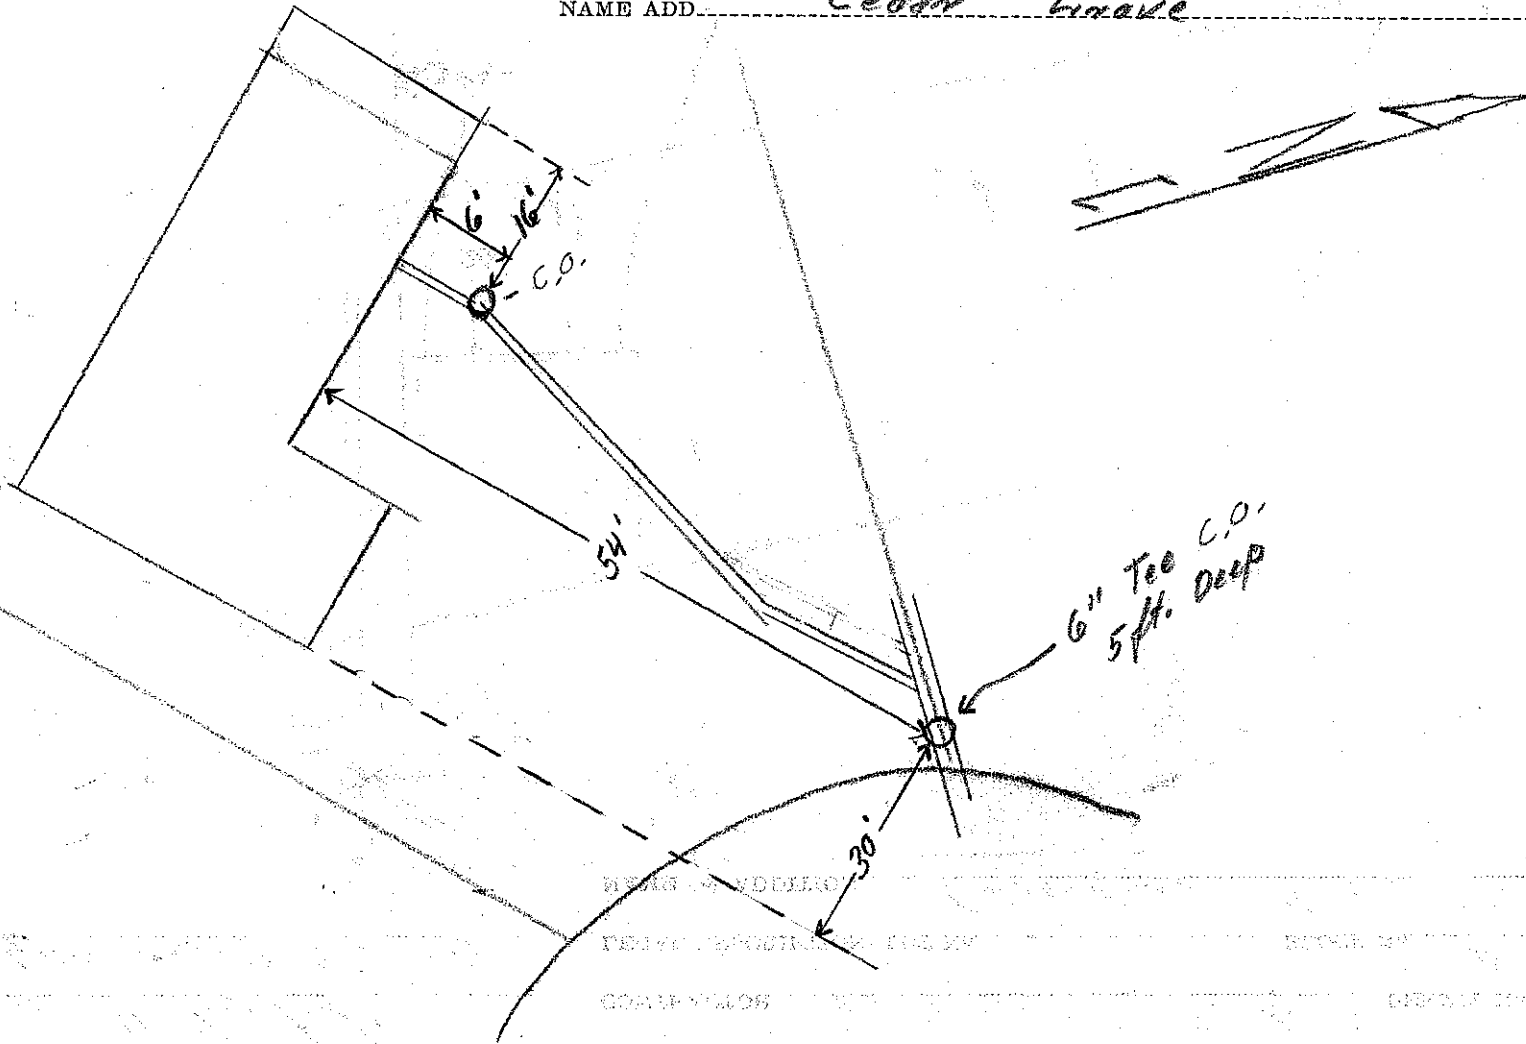

Date _____

WORK COMPLETION ☐

Approved: ☐

BACKFILL WORK ORDER ISSUED _____ DEPOSIT, \$ _____

SEWER WORK ORDER ISSUED _____ DATE _____ BY _____