

APPLICATION

for

SIDE SEWER PERMIT


CARD No. _____

The City of Mountlake Terrace

OUTSIDE ☐ INSIDE ☐ REPAIRS ☐

EASEMENT No. _____

OWNER Jim Hellerstedt CONTRACTOR North End Septic Tank Co. PERMIT No. _____
 STREET _____
 HOUSE No. 22309 - 39 Ave W. AVENUE LOT No. 1 BLOCK No. B
 NAME ADD. Cedar Grove

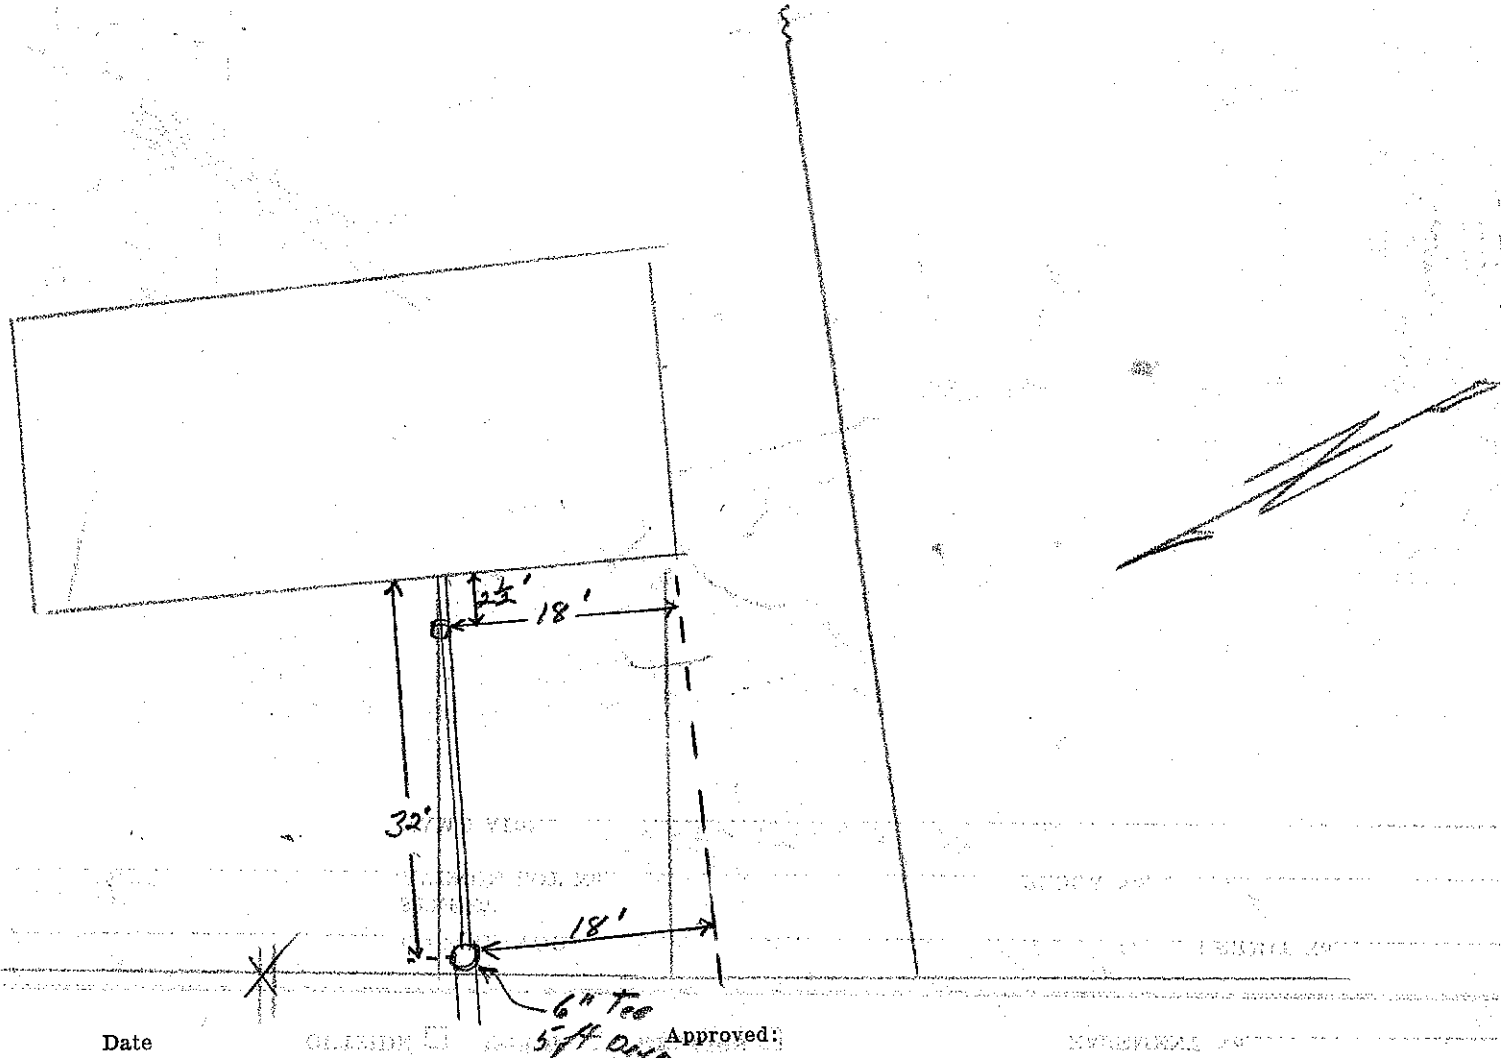

BACKFILL WORK ORDER ISSUED _____ DEPOSIT, \$ _____ DATE _____ BY _____
 SEWER WORK ORDER ISSUED _____