


THE CITY OF MOUNTLAKE TERRACE

APPLICATION
FOR
SIDE SEWER PERMIT
OUTSIDE ☐ INSIDE ☐ REPAIRS ☐

CARD No. _____

EASEMENT No. _____

OWNER Jim Hellerstedt CONTRACTOR North End Septic Tank PERMIT No. _____
HOUSE No. 22404 - 39 Ave w. STREET 5 AVENUE LOT No. 5 BLOCK No. A
NAME ADD Cedar Grove # 2

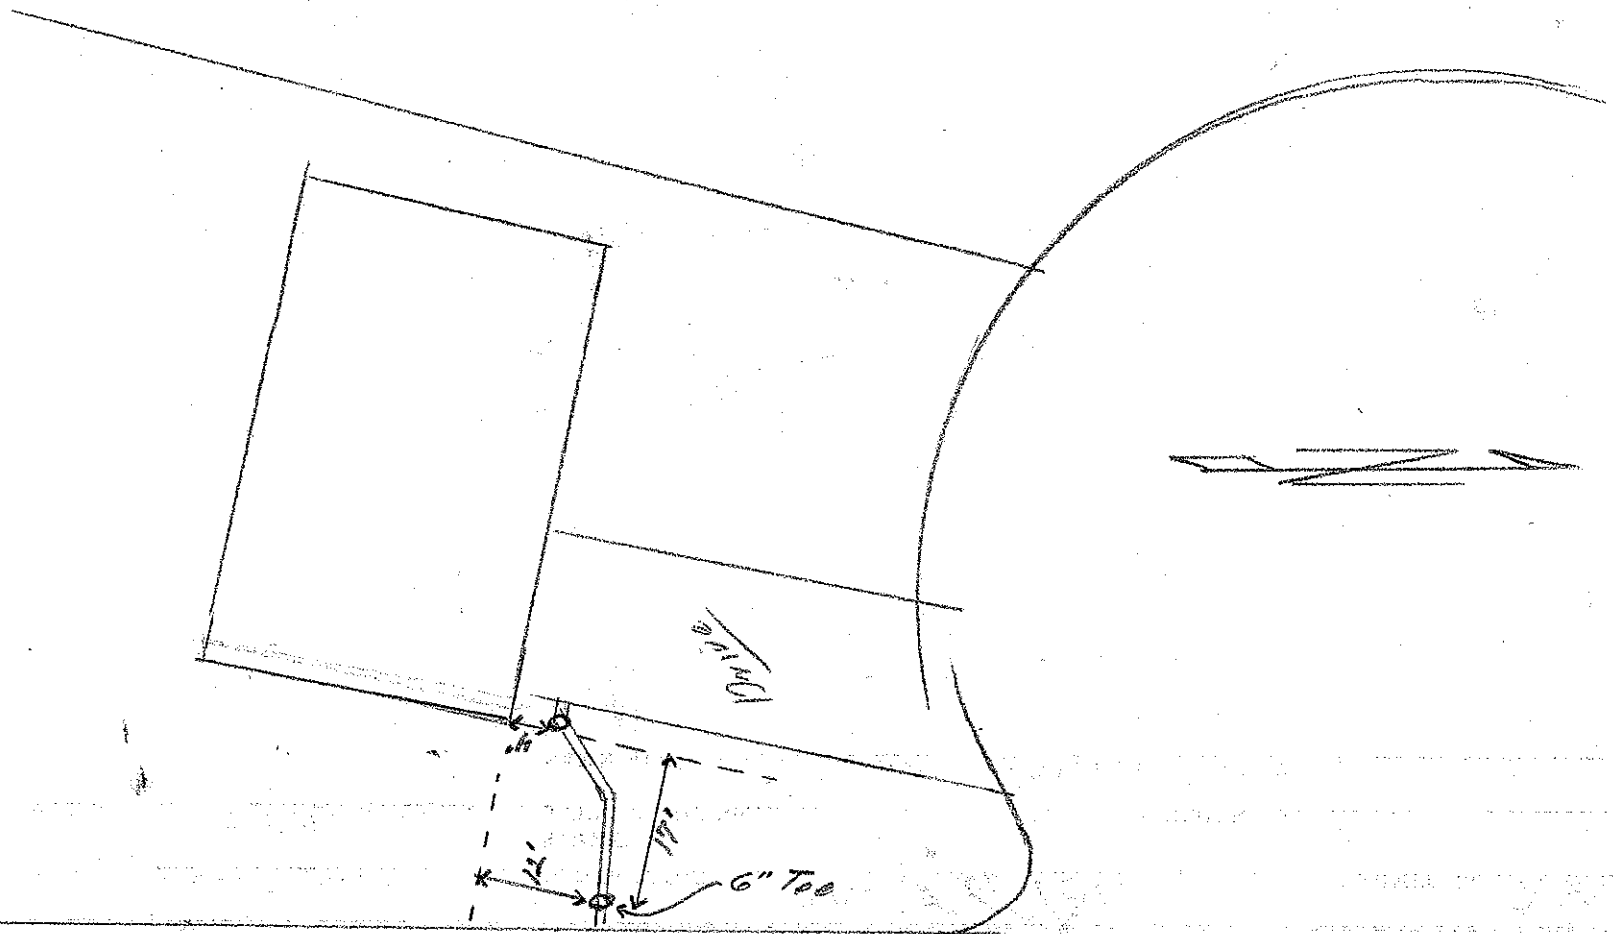

DATE 39 Ave APPROVED: _____
BACKFILL WORK ORDER ISSUED _____ DEPOSIT. \$ _____
SEWER WORK ORDER ISSUED _____ DATE _____ BY _____