


ENGINEERING DEPARTMENT
CITY OF MOUNTLAKE TERRACE
23204 36TH AVENUE WEST
MOUNTLAKE TERRACE, WA 98043
(425) 778-1161
FAX (425) 778-9421



**CITY OF MOUNTLAKE TERRACE
SEWER AS-BUILTS**

SIDE SEWER AS-BUILT

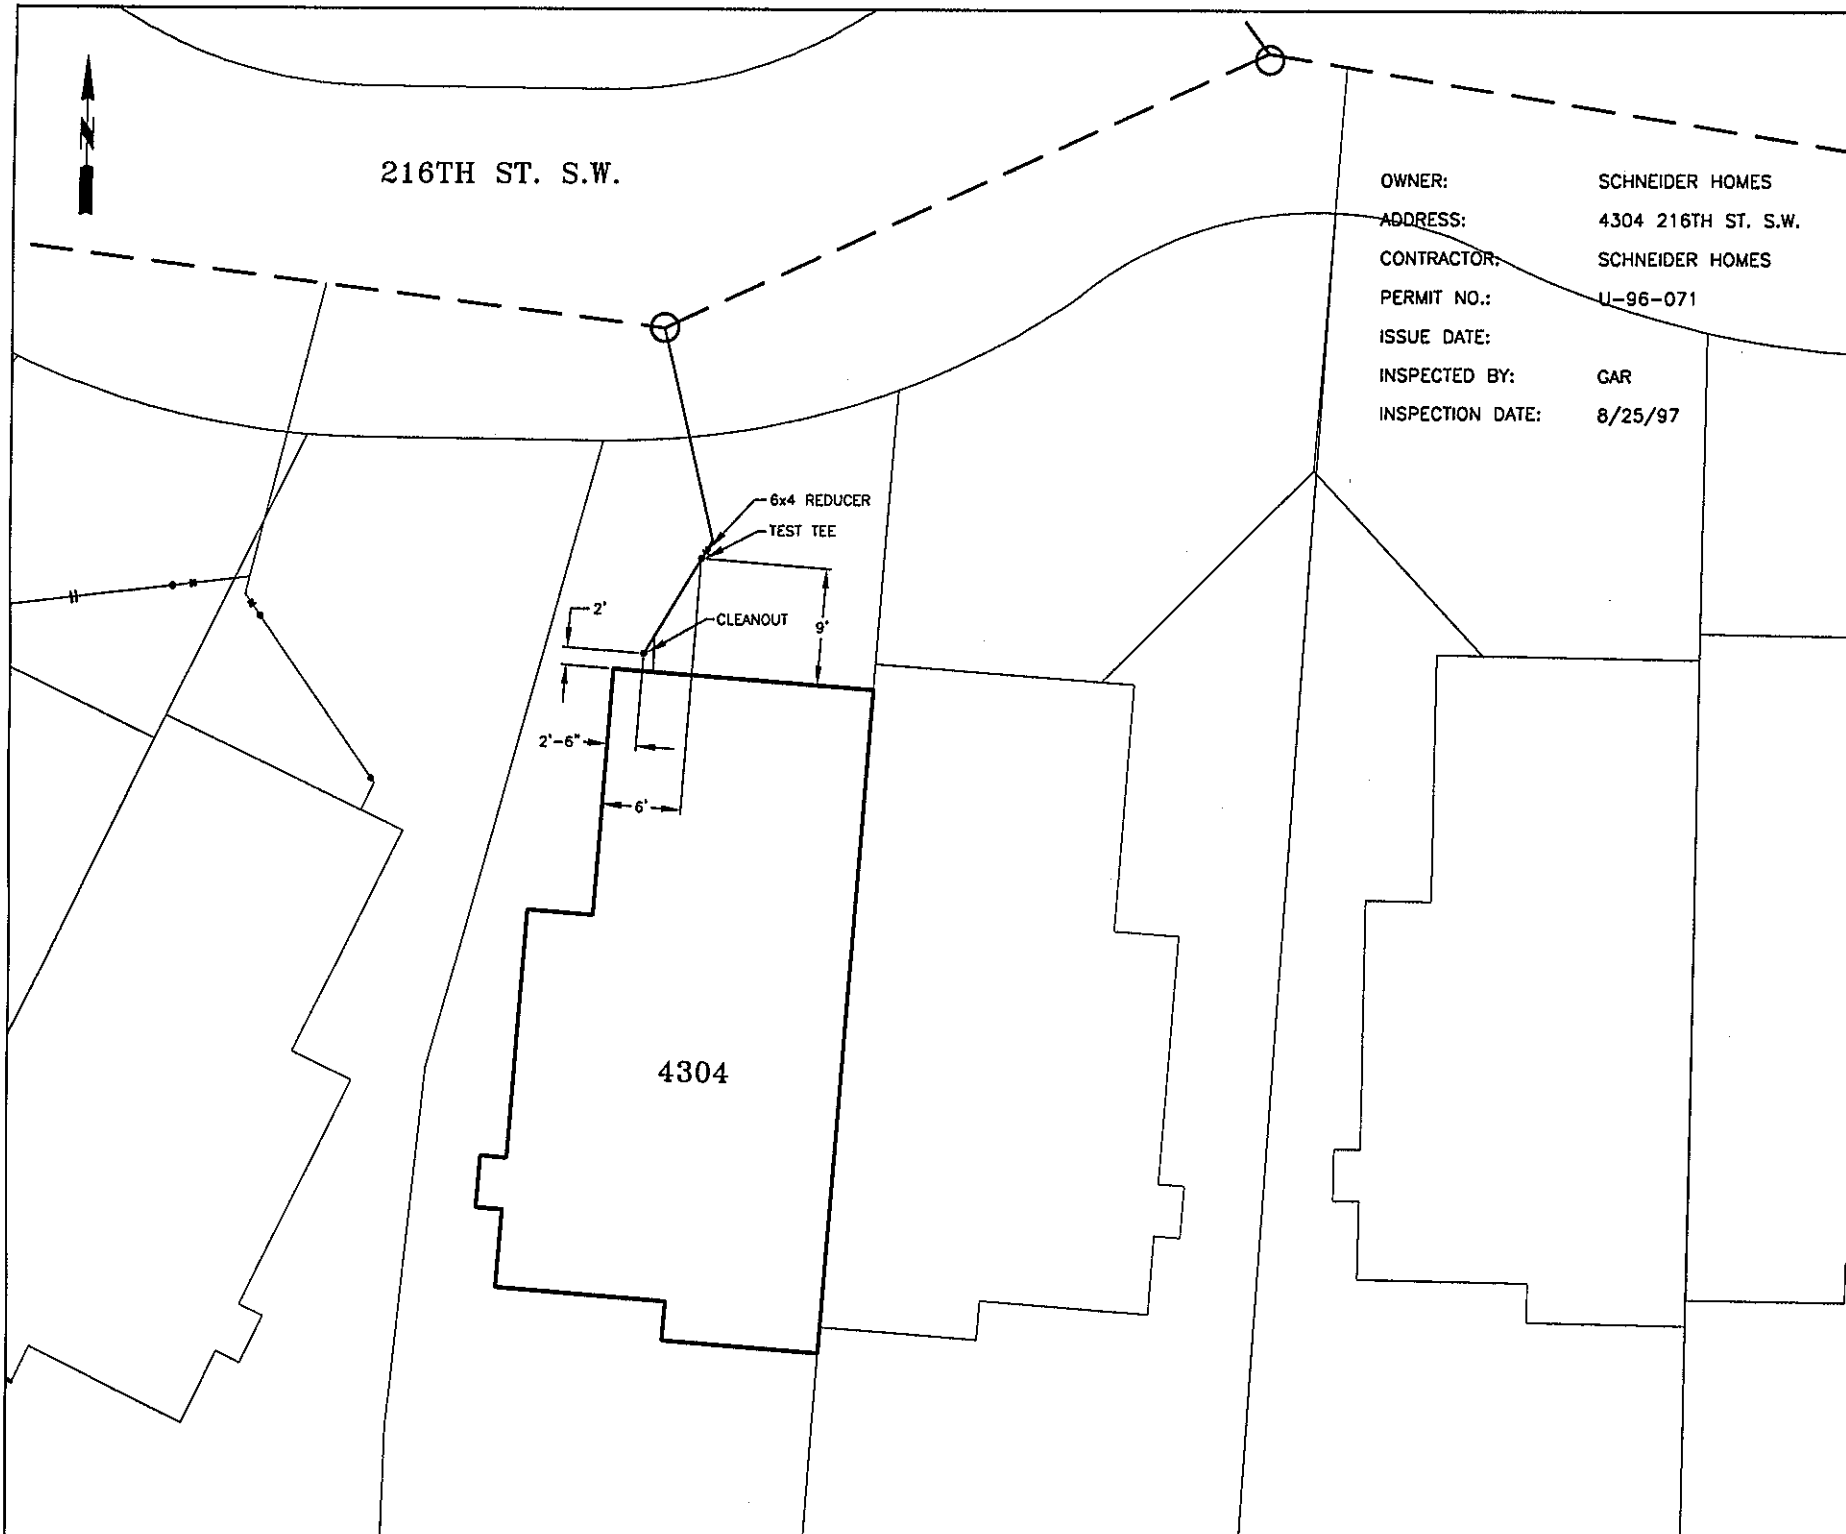

4304

DESIGNED BY:	CHECKED BY:	PROJECT ENGINEER	DATE:
SS-		DESCRIPTION	
DRAWING NO.	REVISION		
DATE			