
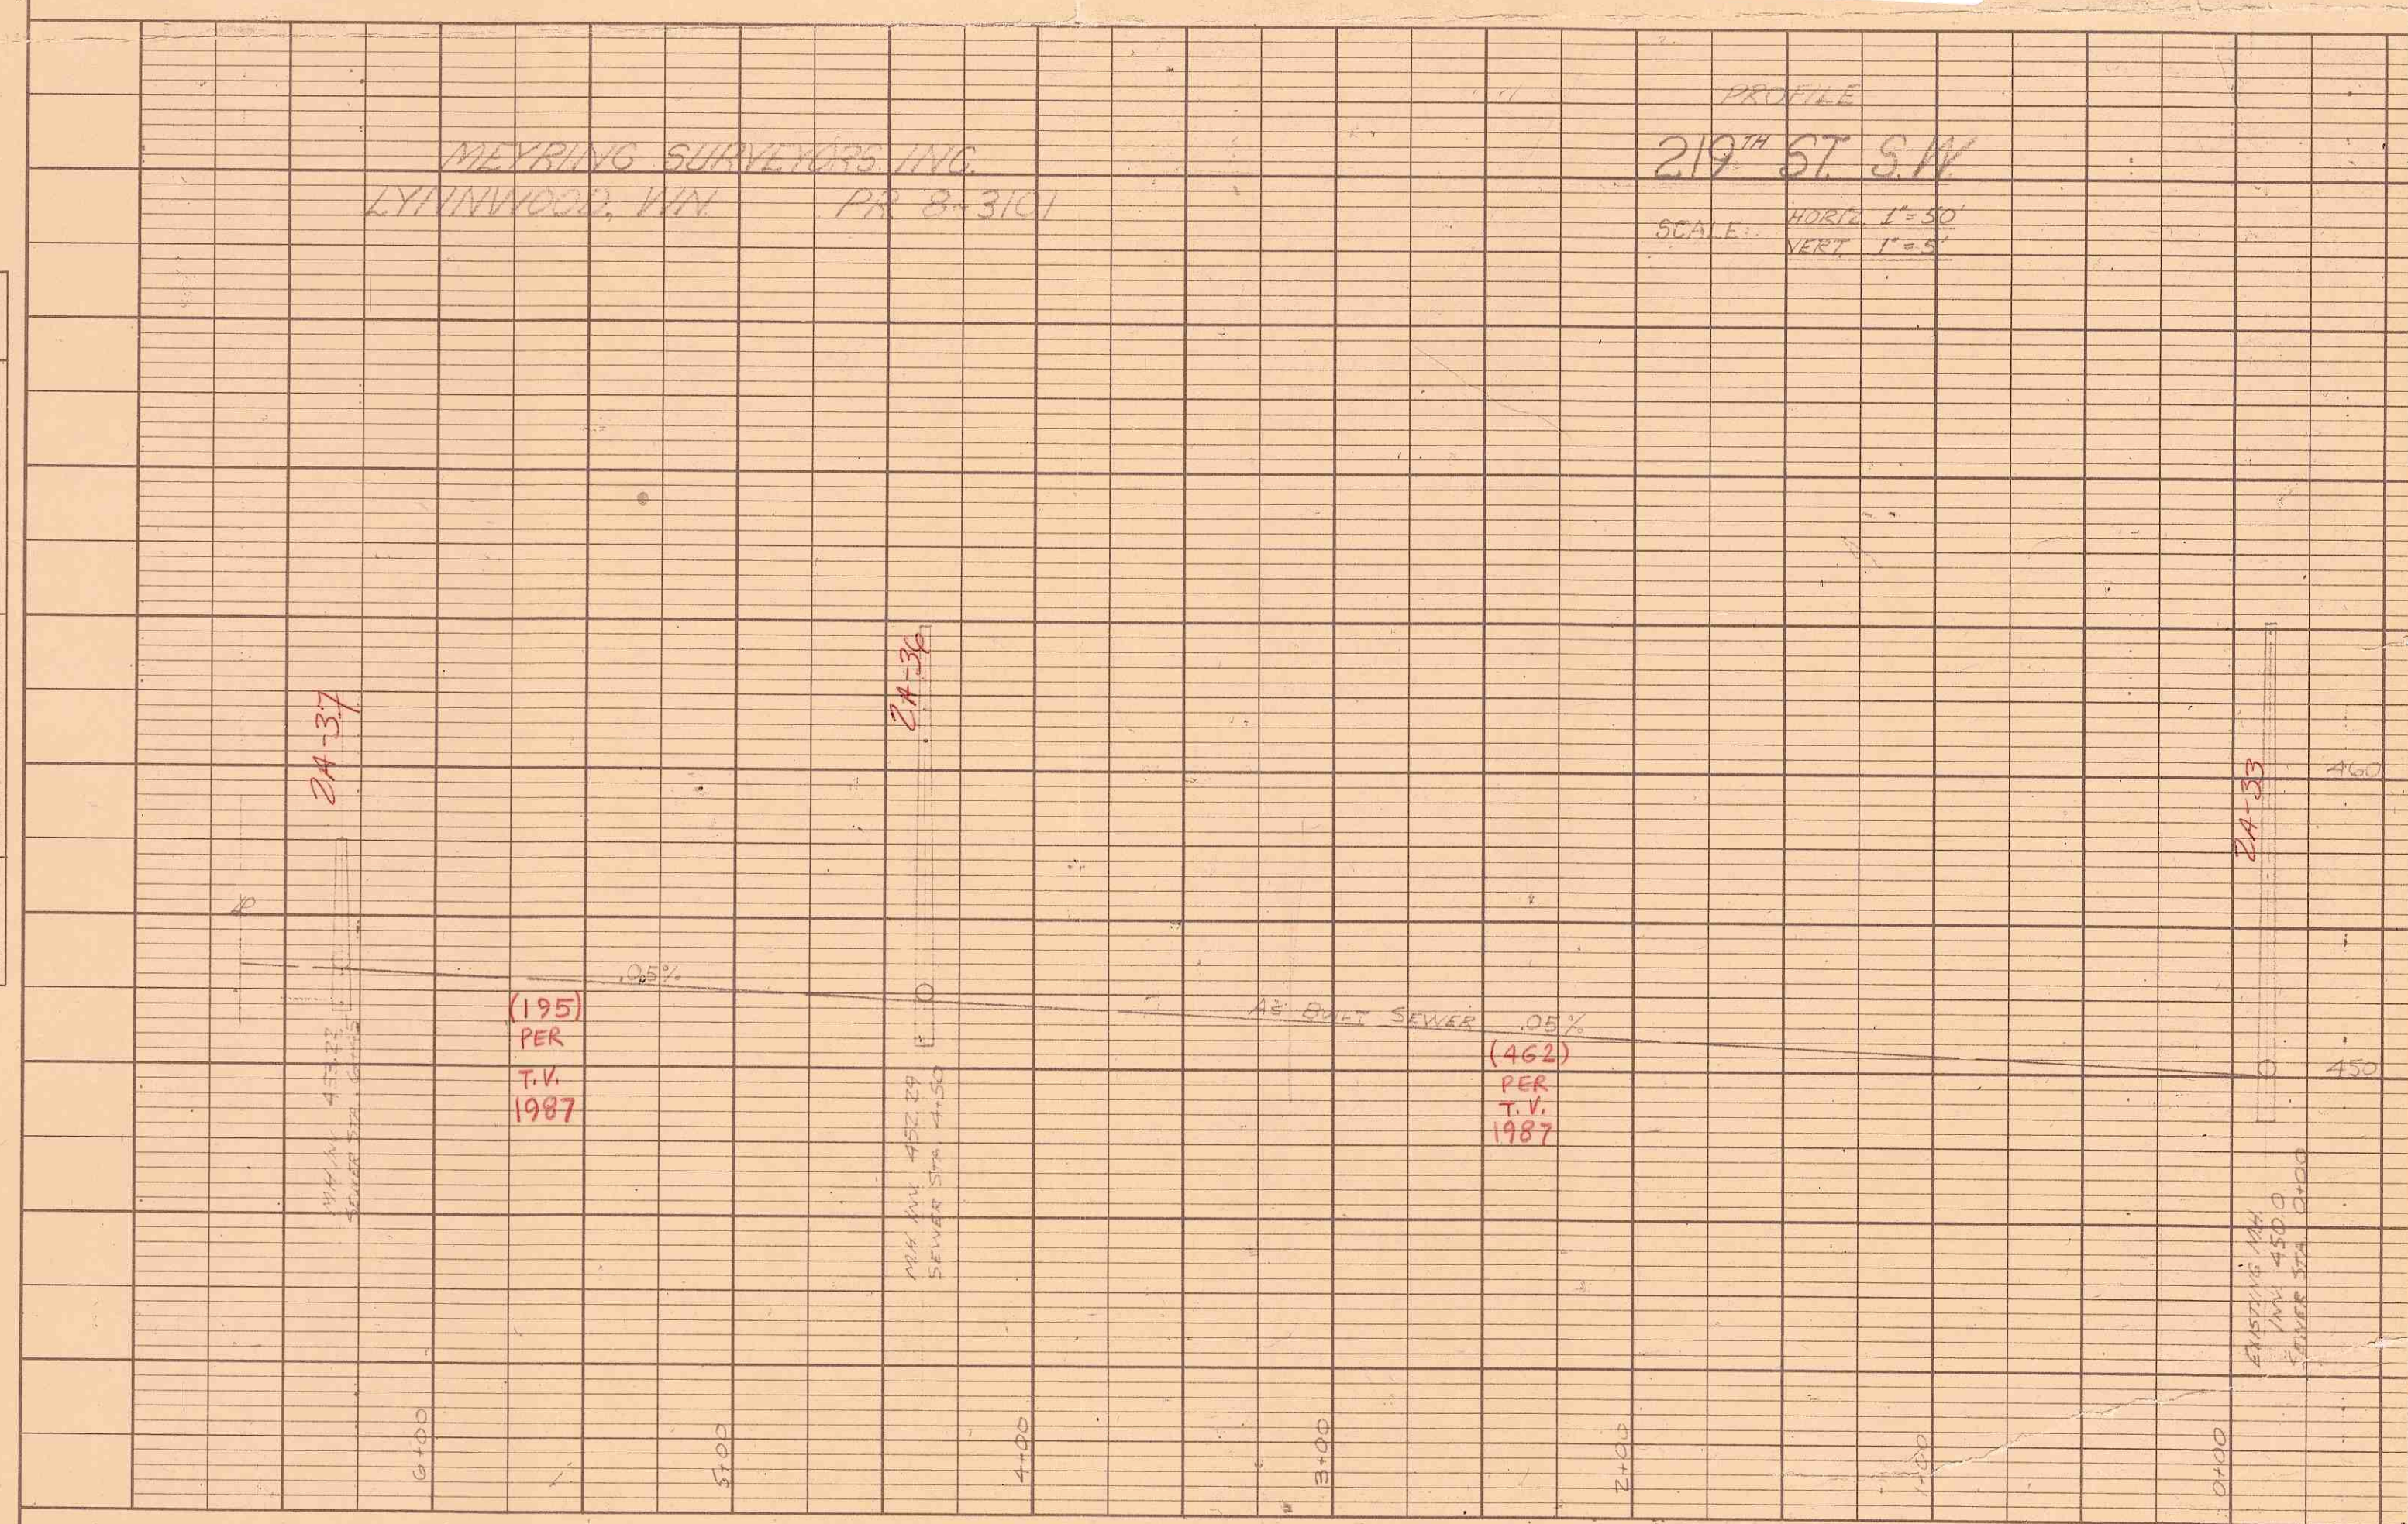


PLAN	BY	DATE
SURVEYED		
PLOTTED		
ALIGNMENT CHECKED		
NOTE BOOK		
NO.		

PROFILE	BY	DATE
SURVEYED		
PLOTTED		
GRADES CHECKED		
STRUCTURE NOTAS CH'G.		
NO.		

AS BUILT SAN SEWER / WATER LINE
CEDA-PARK #3
 IN THE NE 1/4 SEC 28, T27N, R45E, W1M
 SNO. CO. WASH.
 CITY OF MOUNTLAKE TERRACE, WASH.

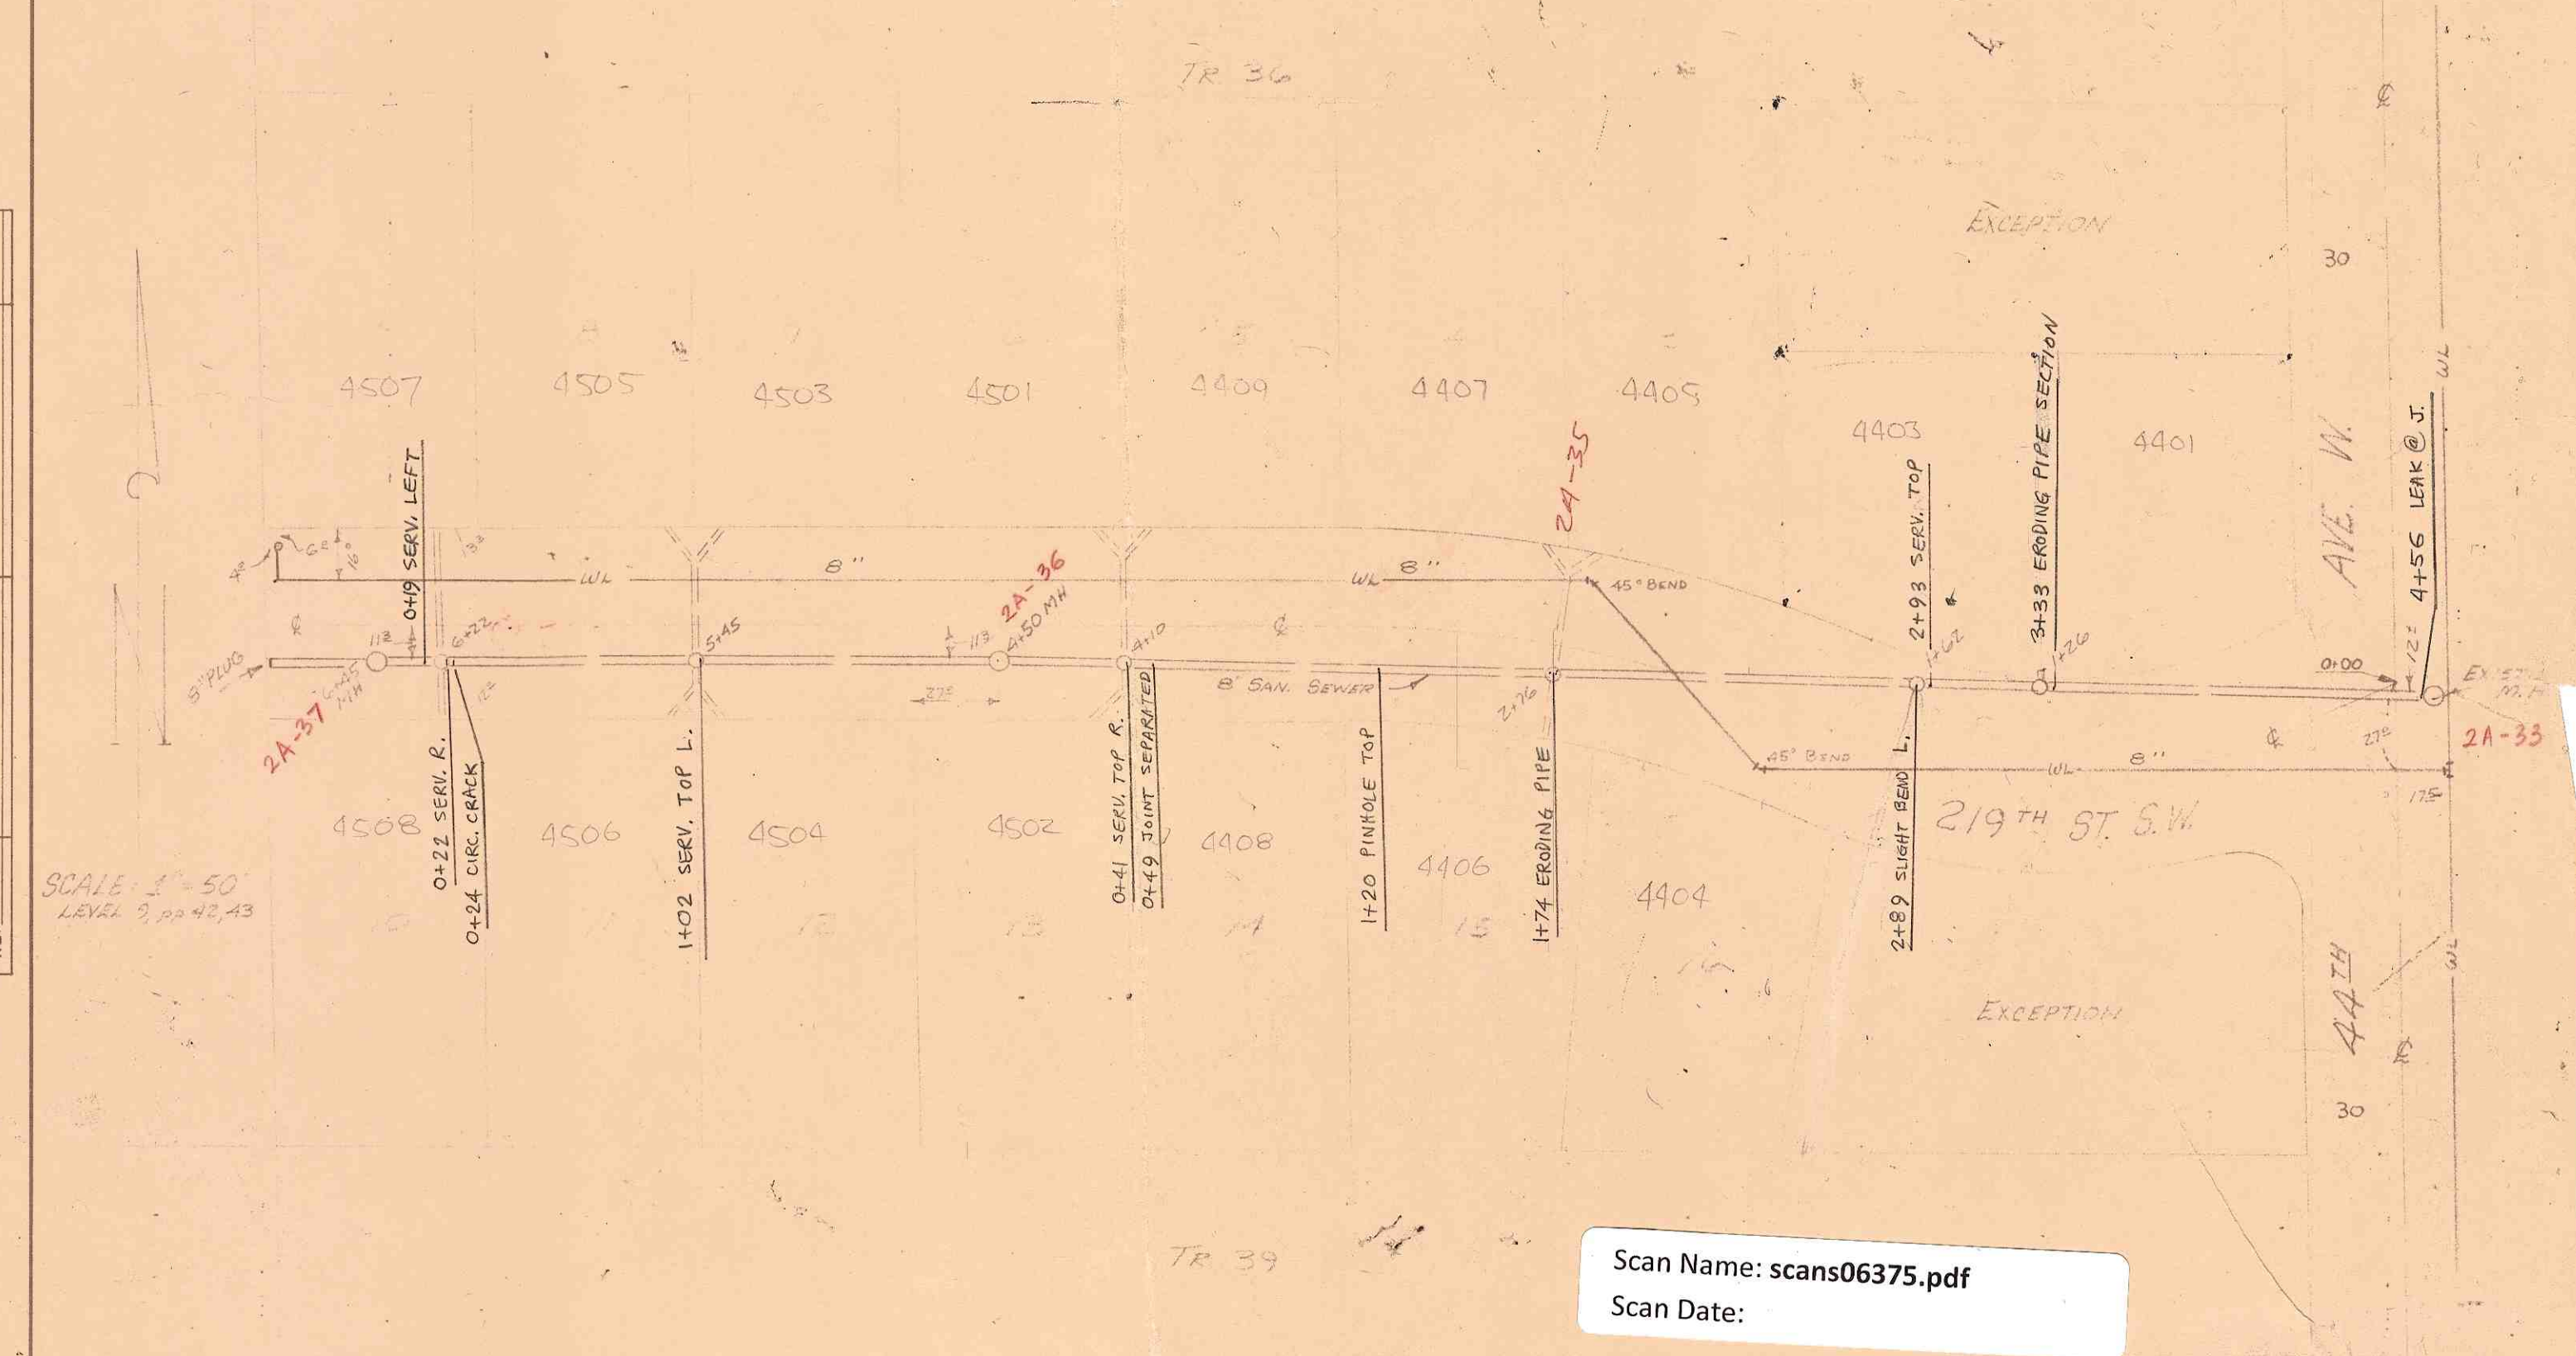

Scan Name: scans06375.pdf
 Scan Date: