

APPLICATION

SIDE SEWER PERMIT

OUTSIDE ☒ INSIDE ☐ REPAIRS ☐

CARD No. _____

EASEMENT No. _____


The City of Mountlake Terrace

H & H Homes

OWNER _____ CONTRACTOR Lynnwood Septic Tank Co PERMIT No. U-43-75

HOUSE No. 22304 66th Place STREET _____ AVENUE LOT No. 5 Greenridge BLOCK No. _____

NAME ADD _____

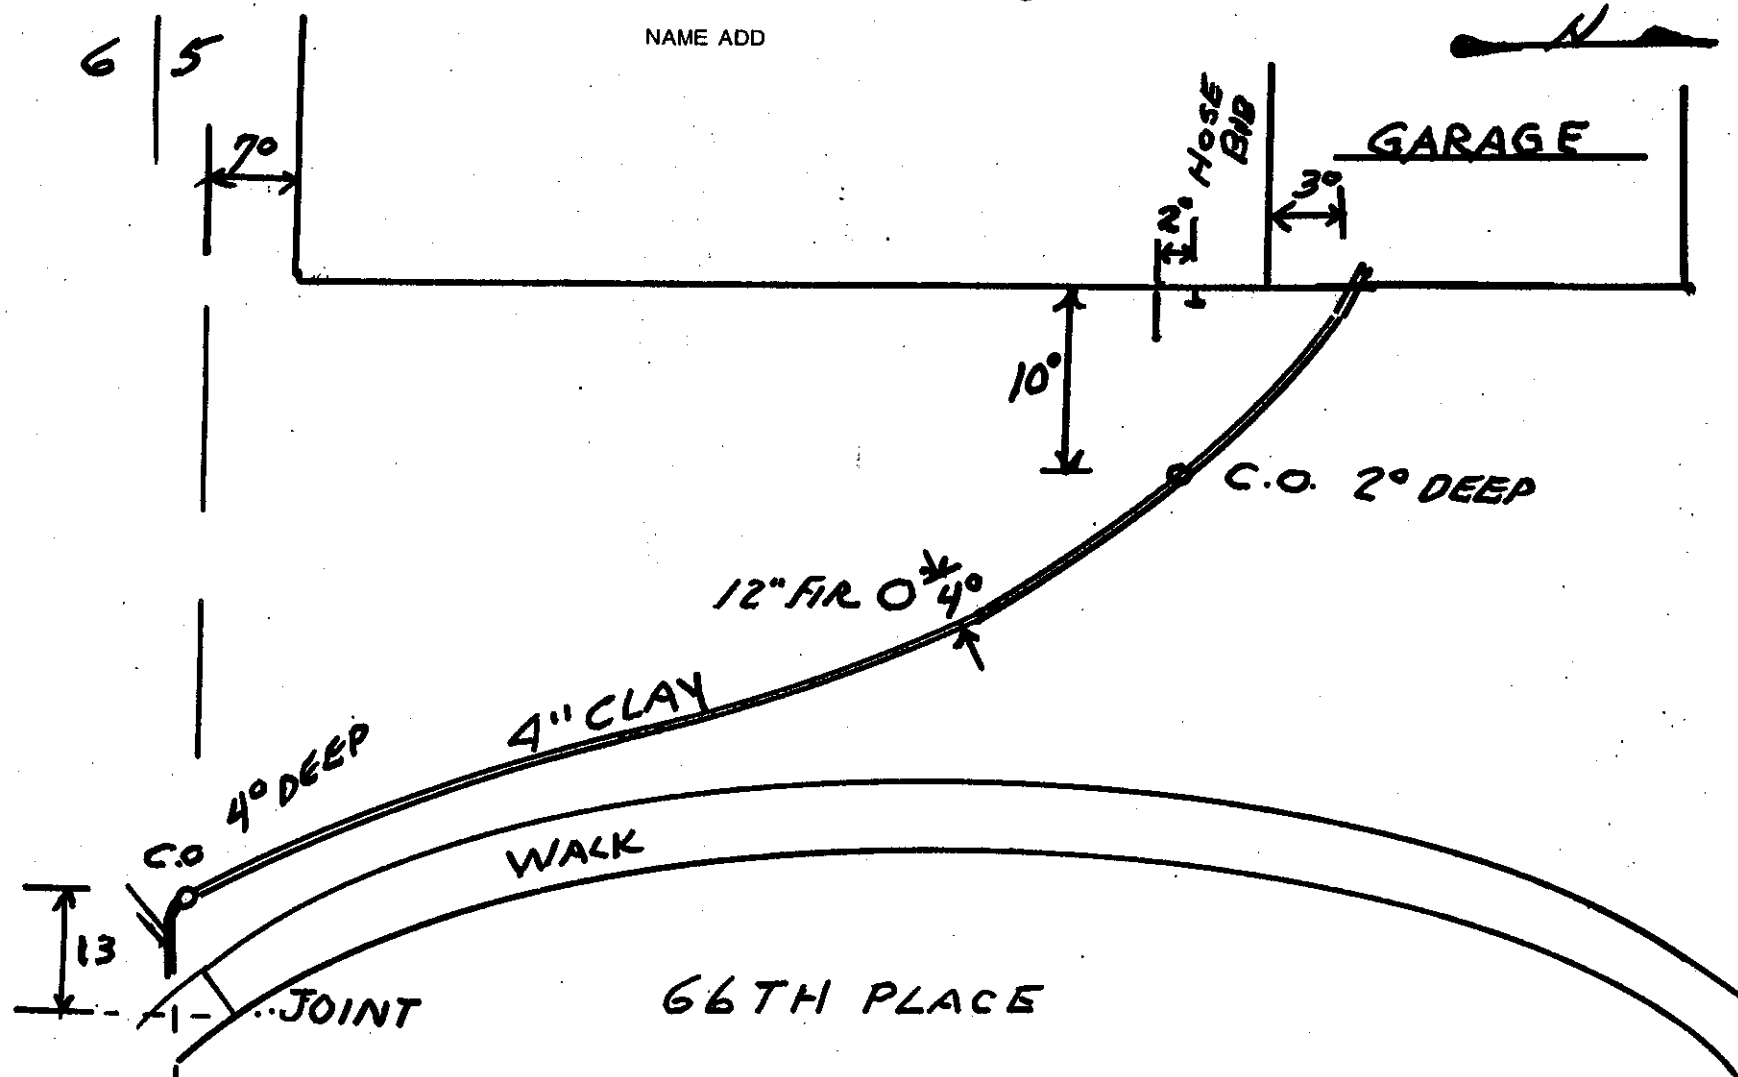

BACKFILL WORK ORDER ISSUED 6-11-75 DEPOSIT, \$ \$10.00 Approved: _____
 SEWER WORK ORDER ISSUED 6-11-75 DATE 6-11-75 BY Paul H. Smith