

The City of Mountlake Terrace

APPLICATION

for

SIDE SEWER PERMIT

OUTSIDE ☐ INSIDE ☐ REPAIRS ☐

2197

CARD No. ....


EASEMENT No. ....

OWNER Elmer V. Moser CONTRACTOR Lynnwood Septic Tank Co. PERMIT No. 3198

HOUSE No. 4510 STREET 33 AVENUE LOT No. 33 BLOCK No. 243 plsn

4512

NAME ADD. Terrace Ridge

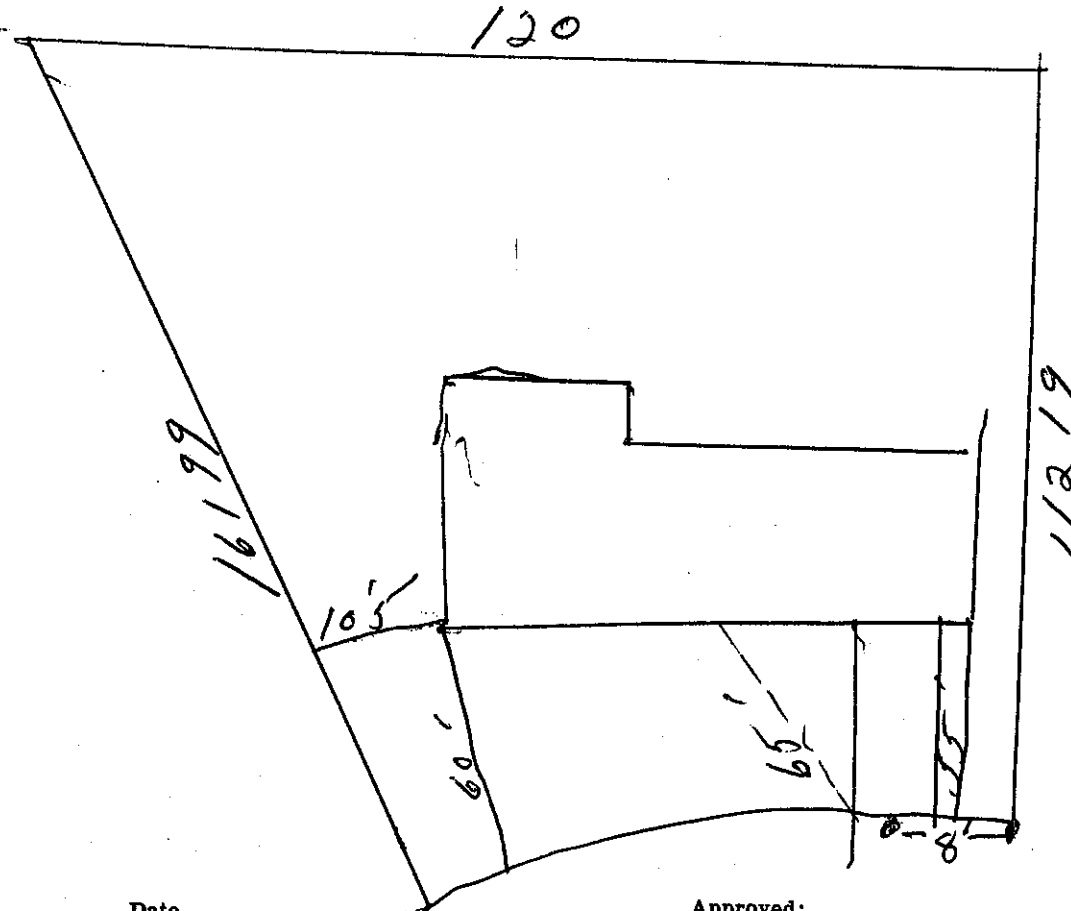

Date

Approved:

BACKFILL WORK ORDER ISSUED..... DEPOSIT, \$.....

SEWER WORK ORDER ISSUED.....

DATE..... BY.....