

626-1161

6 ft east of manhole

THE CITY OF MOUNTLAKE TERRACE

# APPLICATION

FOR

SIDE SEWER PERMIT

OUTSIDE ☐ INSIDE ☐ REPAIRS ☐

CARD No. \_\_\_\_\_


EASEMENT No. \_\_\_\_\_

OWNER Sunset Realty CONTRACTOR Woodley Pipe & Sewer PERMIT No. \_\_\_\_\_

HOUSE No. 7108 - 230th St W STREET Installations Inc AVENUE LOT No. 7 BLOCK No. \_\_\_\_\_

NAME ADD # 3 Lake Ballinger Country Club Estates

230th St SW

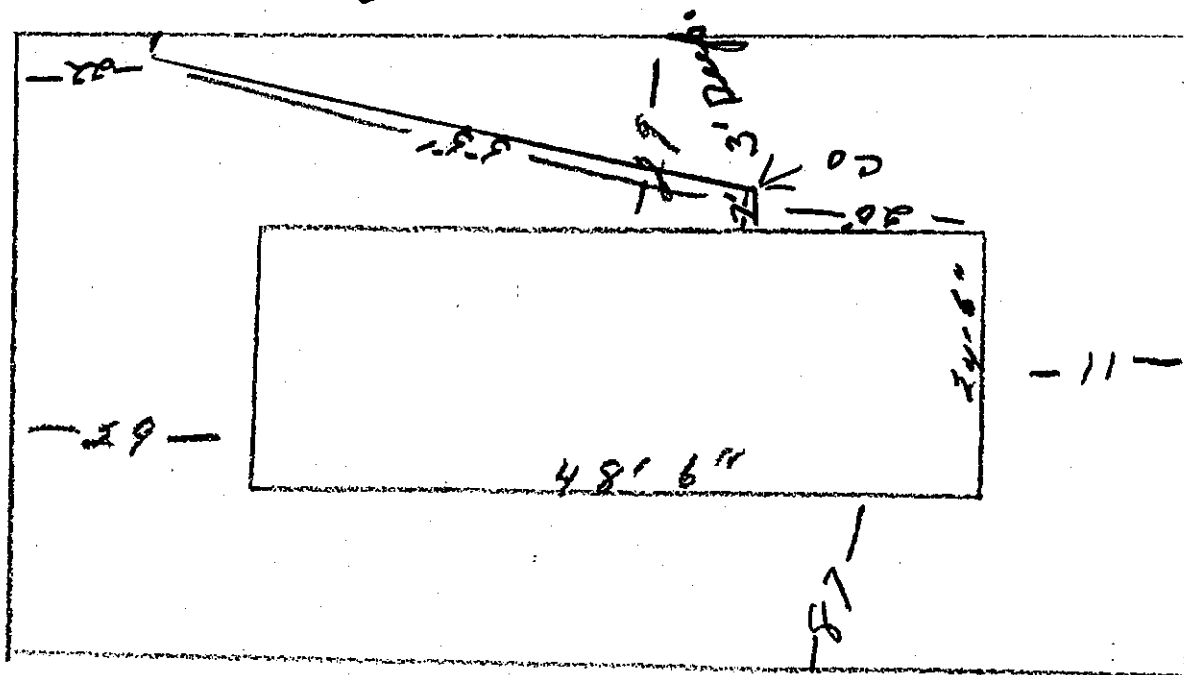

BACKFILL WORK ORDER ISSUED \_\_\_\_\_ DATE \_\_\_\_\_ DEPOSIT, \$ \_\_\_\_\_

SEWER WORK ORDER ISSUED \_\_\_\_\_

APPROVED:

DATE

9/4/68

BY

Charles B. Duke